

THIS DRAWING AND DESIGN HEREIN SHALL NOT BE REPRODUCED, COPIED, USED OR DISCLOSED TO OTHERS FOR PROCUREMENT OR OTHER PURPOSE (EXCEPT AS OTHERWISE AUTHORIZED BY CONTRACT) WITHOUT WRITTEN PERMISSION OF SIEMENS BUILDING TECHNOLOGIES, INC., FIRE SAFETY DIVISION. ALL OTHER REPRODUCTIONS SHALL BEAR THIS NOTICE.

REVISIONS

No.	Revision	By	Date	Appr.
△	REVISED PER FIRE MARSHAL'S COMMENTS DATED 02/12/09	JPM	2/27/09	KW
	AS-BUILT	JPM	8/10/09	KW

AS BUILT

C-10 APPROVAL STAMP:



ENGINEERING CONSULTANTS:

CUSTOMER'S NAME & ADDRESS



PRODUCT MANUFACTURER:

Siemens Building Technologies, Inc.
Fire Safety Division
25821 Industrial Boulevard, Suite 300
Hayward, California 94545-2991
Tel (510) 783-6000 Fax (510) 293-2100
California State C10 License No. 758796
U.L. Certificate ID No. 324787-001

JOB NAME & LOCATION (STREET ADDRESS)

LAWRENCE BERKELEY NATIONAL LABORATORY

BERKELEY LAB GUEST HOUSE

Berkeley, California

SHEET CONTENTS:

FIRE ALARM RISER DIAGRAM

INSTALLATION TYPE

- NEW INSTALLATION
- DESIGN/BUILD
- PER CONTRACT DOCUMENT
- EXISTING BASE JOB # N/A
- OTHERS _____

SYSTEM SALES REP: Kevin Waxman

PROJECT MANAGER: Mark Millard

DRAWN BY: John Paul Minus


CAD FILENAME: FA-07

SCALE: Not Applicable

DATE DRAWN: January 12, 2009 PLOT DATE: November 04, 2013

SHEET: **FA-07** JOB NUMBER: **440P-048653**

DRAWING NO. **6B23E009**

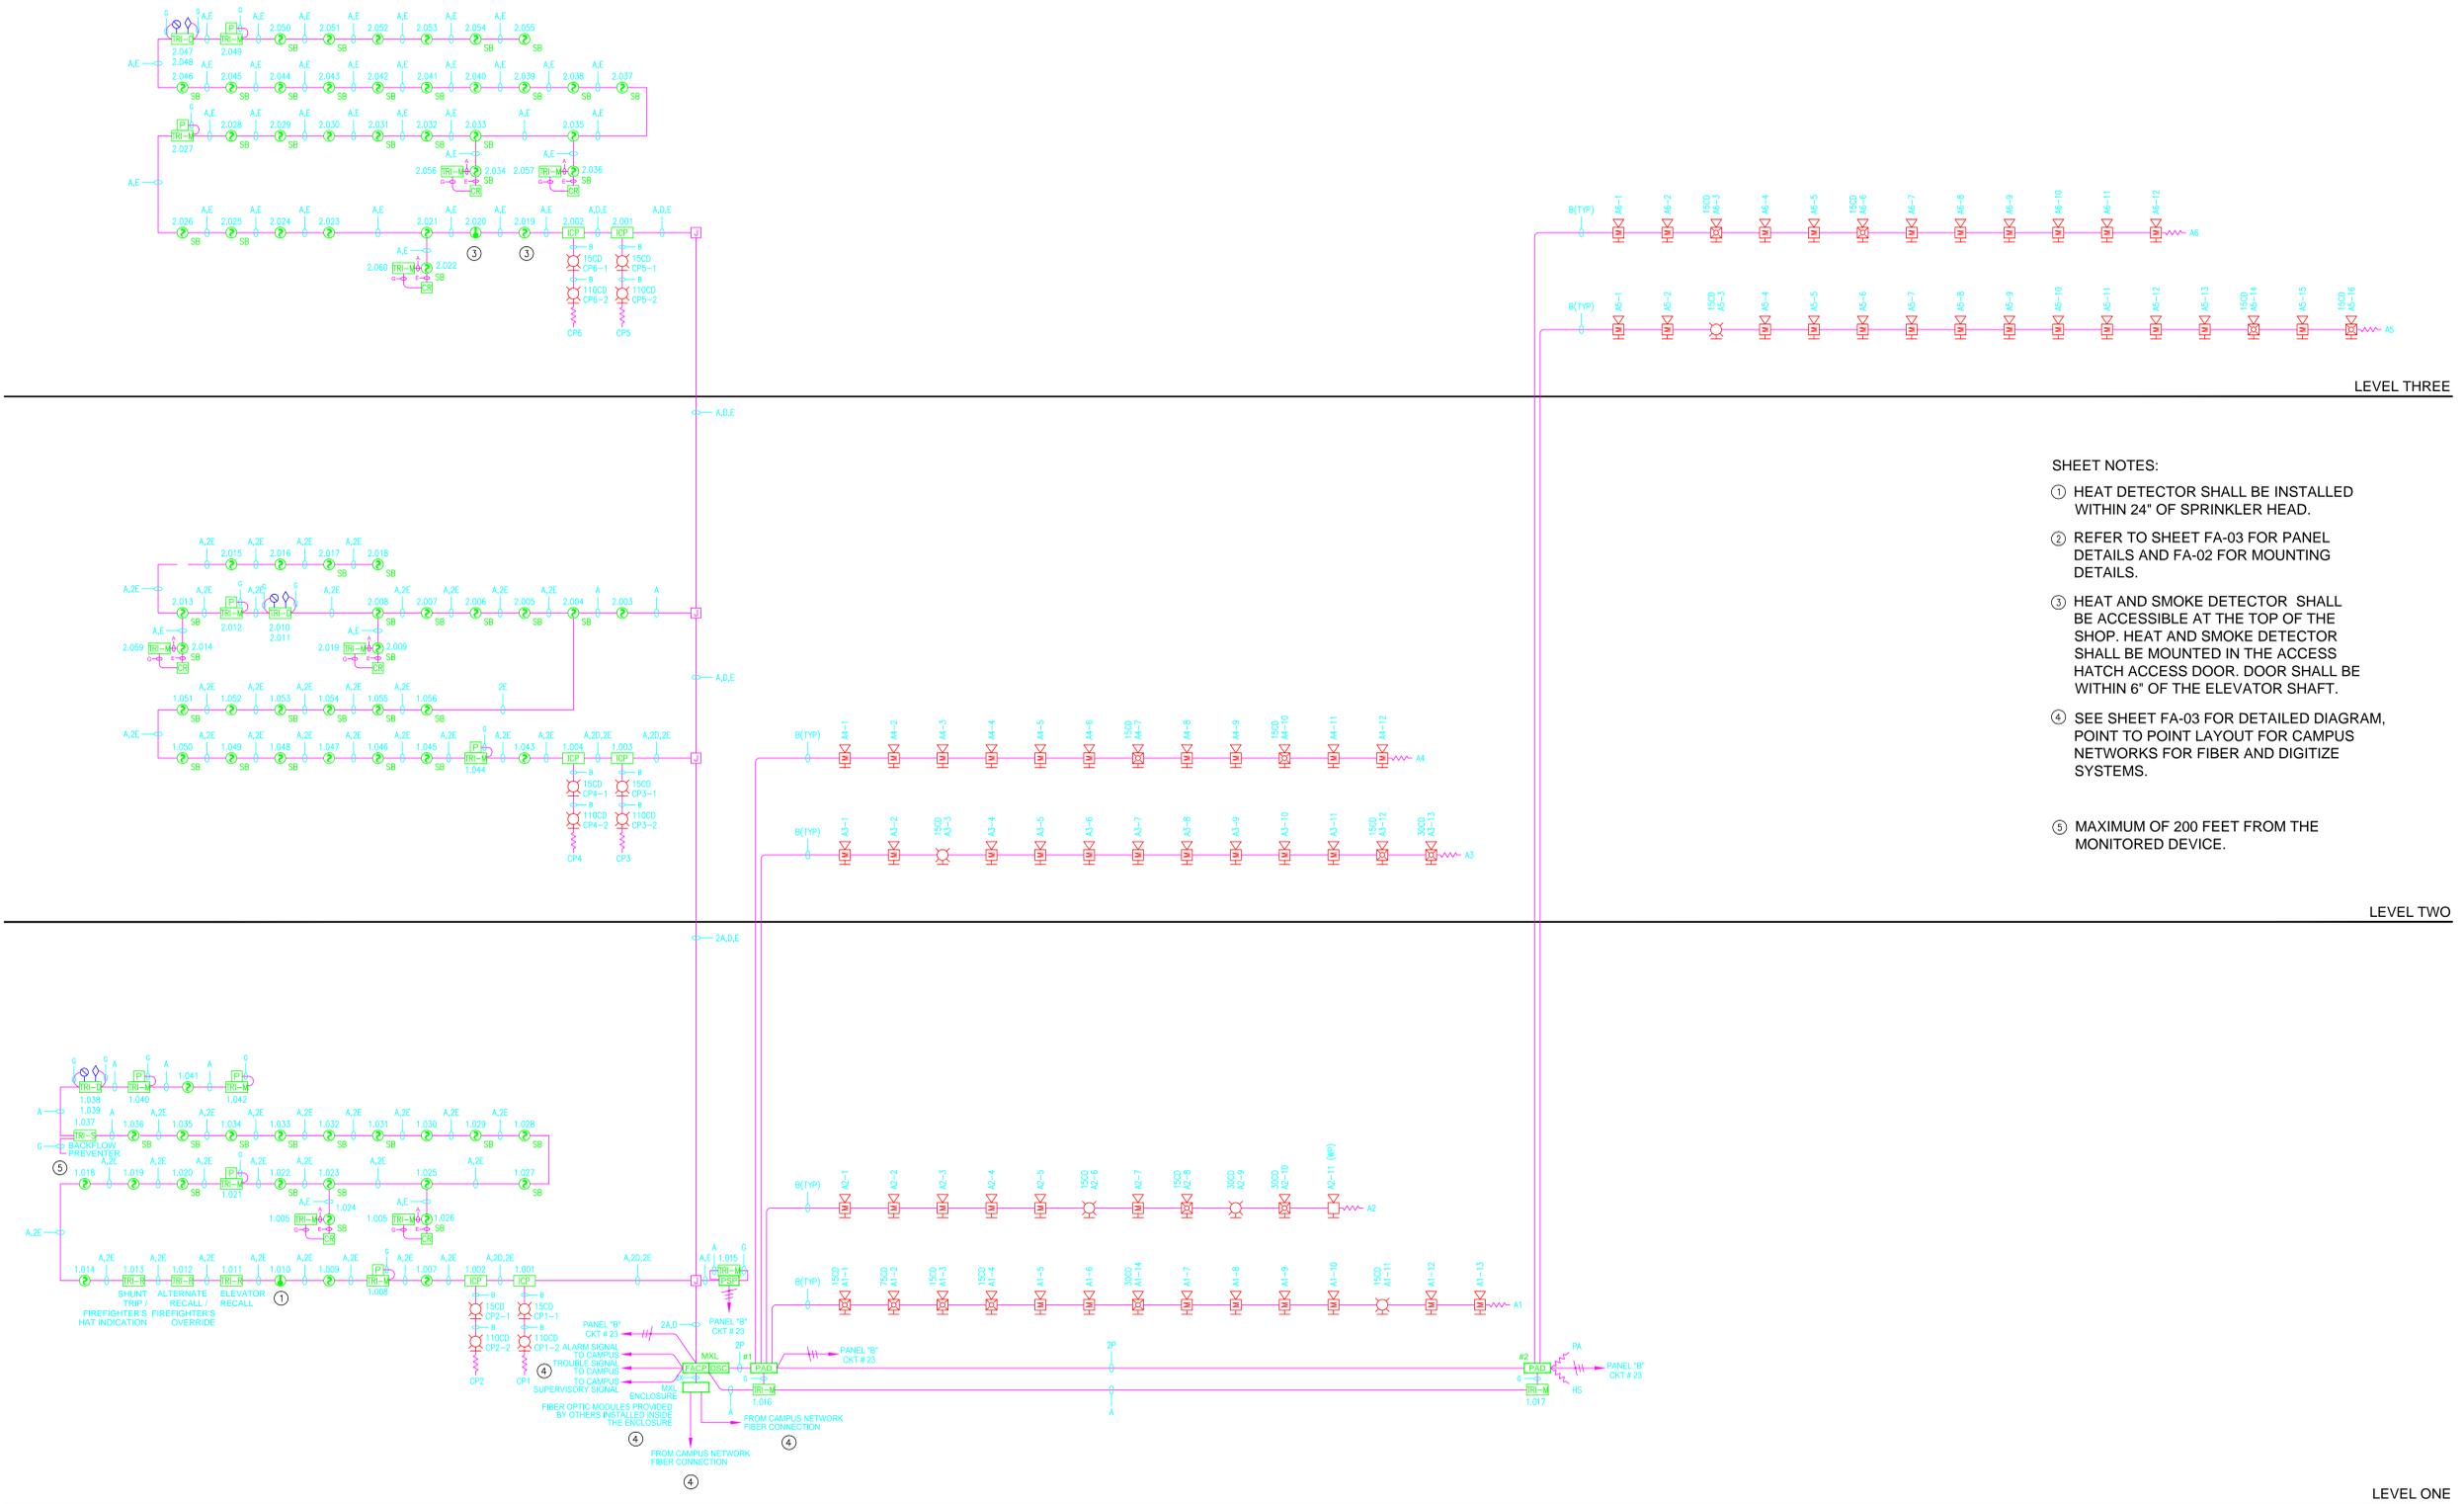

- SHEET NOTES:
- ① HEAT DETECTOR SHALL BE INSTALLED WITHIN 24" OF SPRINKLER HEAD.
 - ② REFER TO SHEET FA-03 FOR PANEL DETAILS AND FA-02 FOR MOUNTING DETAILS.
 - ③ HEAT AND SMOKE DETECTOR SHALL BE ACCESSIBLE AT THE TOP OF THE SHOP. HEAT AND SMOKE DETECTOR SHALL BE MOUNTED IN THE ACCESS HATCH ACCESS DOOR. DOOR SHALL BE WITHIN 6" OF THE ELEVATOR SHAFT.
 - ④ SEE SHEET FA-03 FOR DETAILED DIAGRAM, POINT TO POINT LAYOUT FOR CAMPUS NETWORKS FOR FIBER AND DIGITIZE SYSTEMS.
 - ⑤ MAXIMUM OF 200 FEET FROM THE MONITORED DEVICE.

FIRE ALARM RISER DIAGRAM

IF DRAWING IS SMALLER THAN 30" X 42" IT IS A REDUCED COPY