


FIRE ALARM CONTROL UNIT ARRANGEMENT

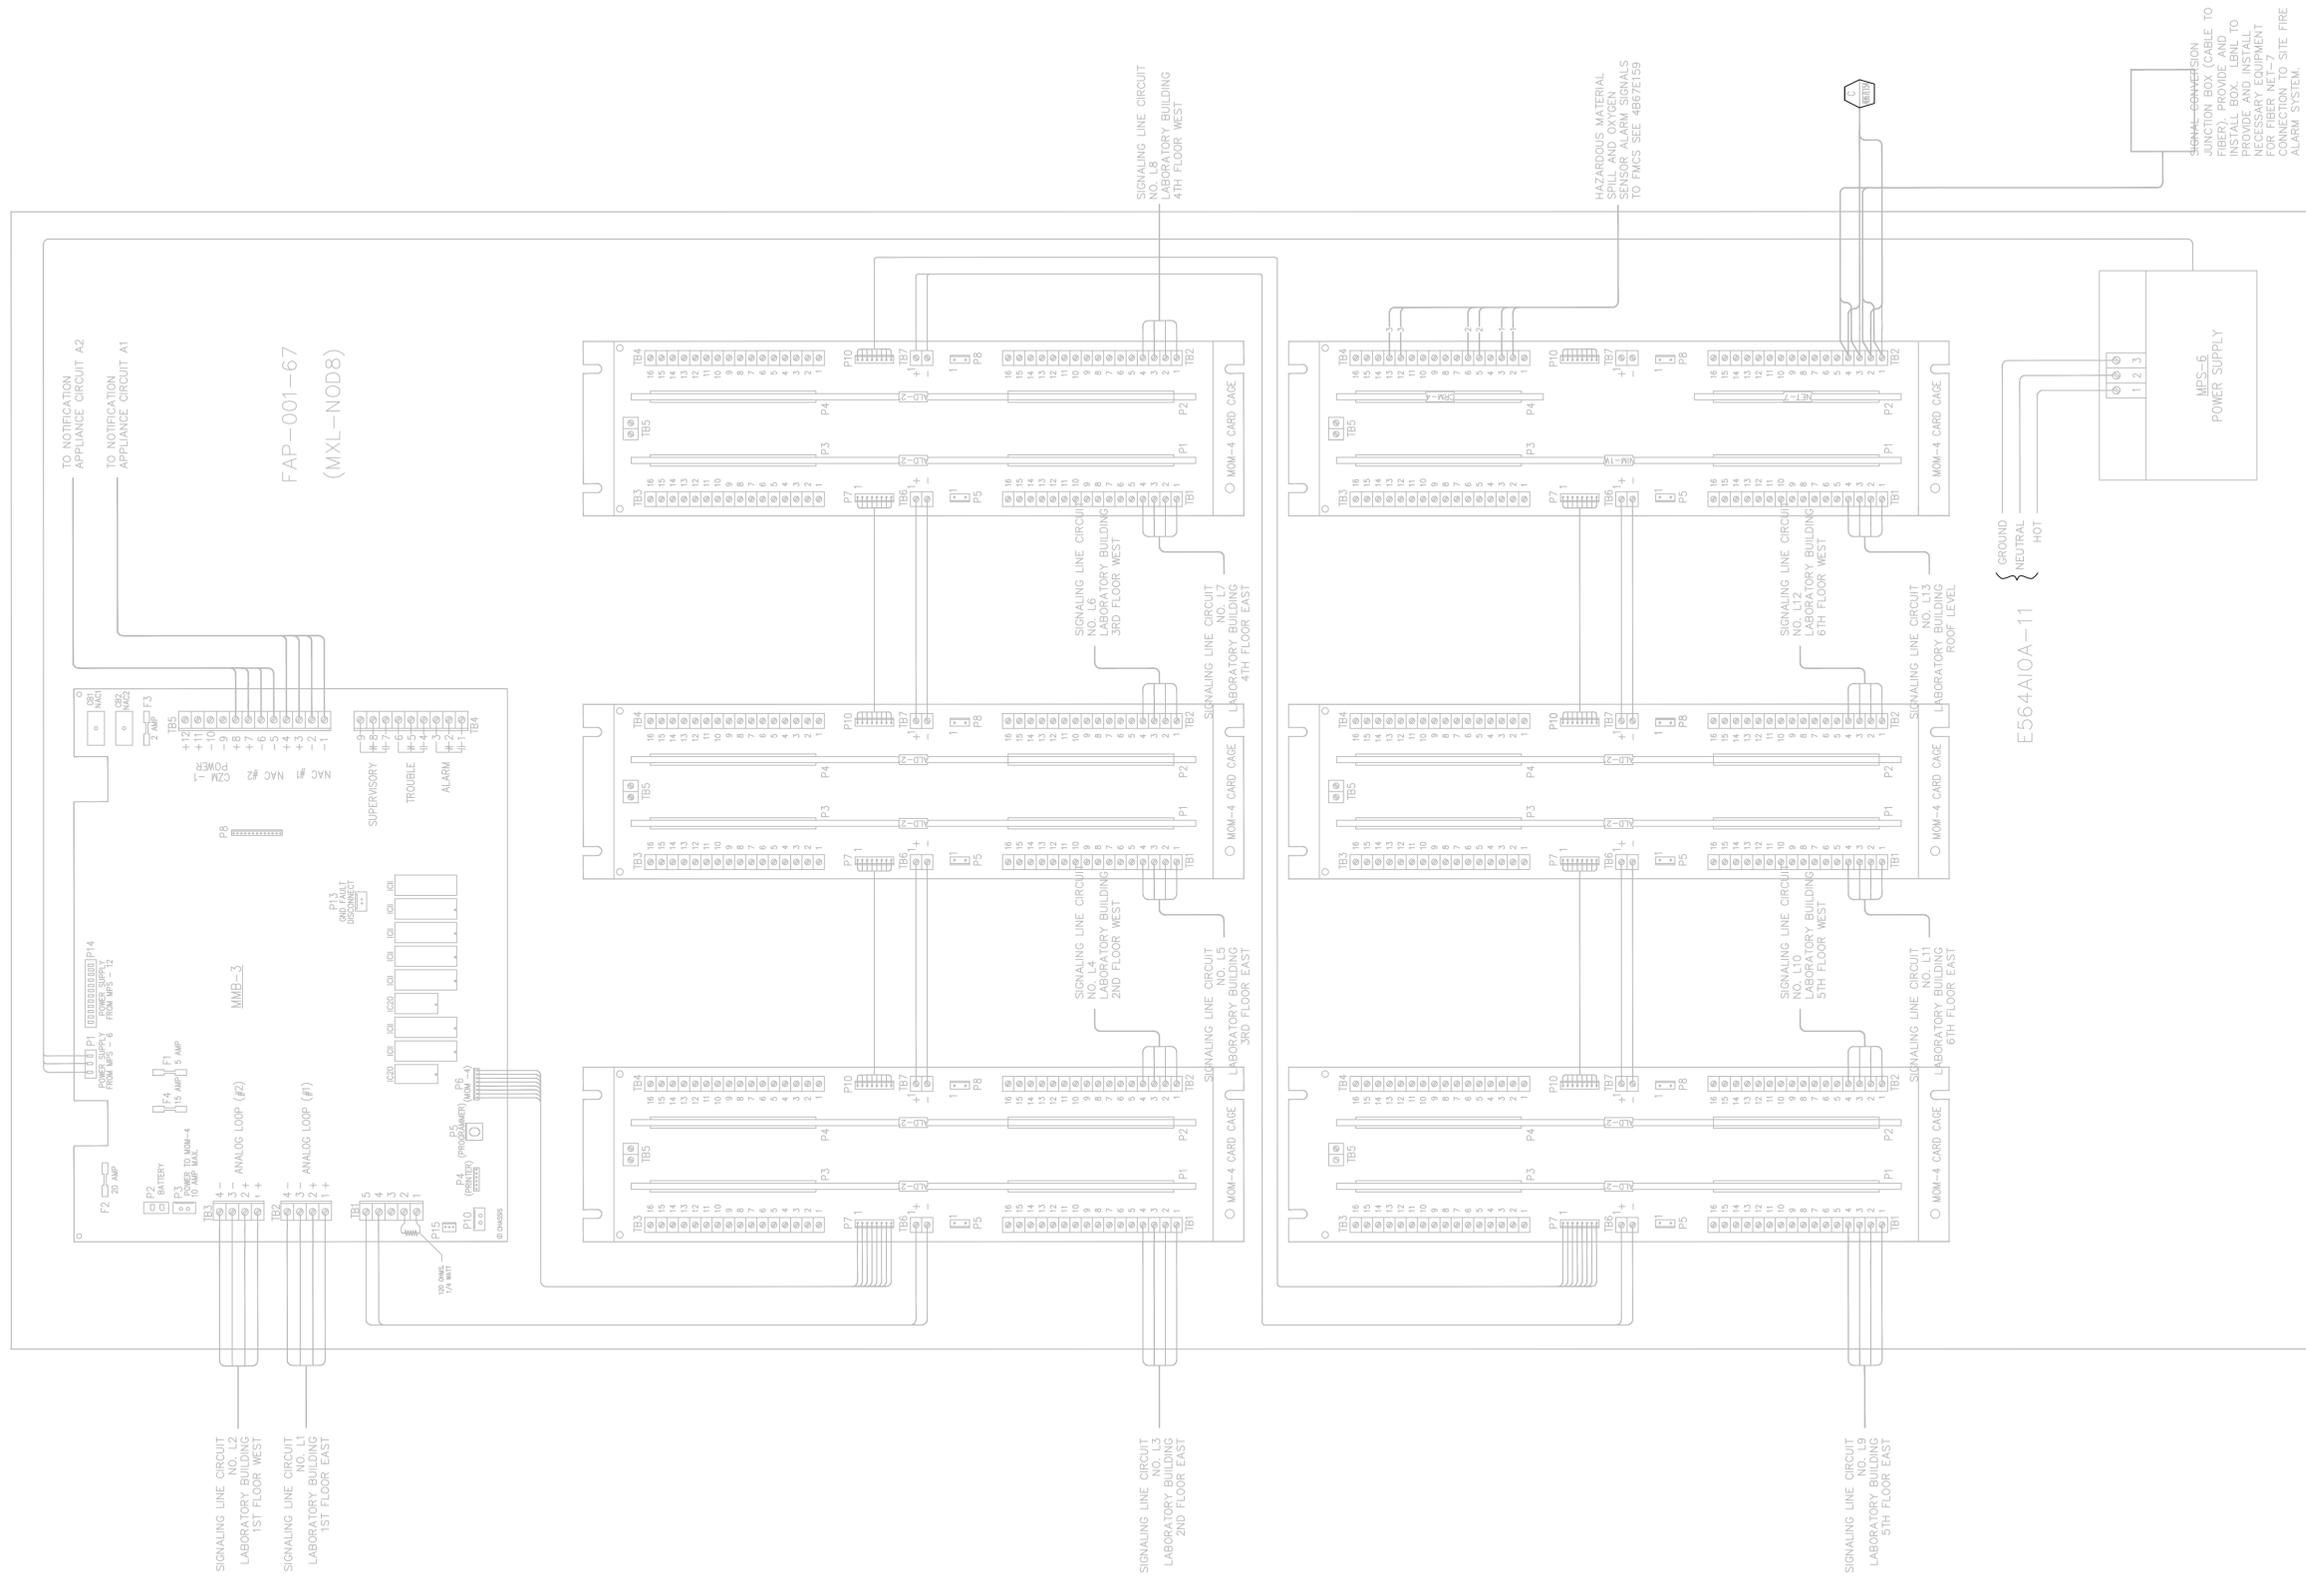

AS BUILT											
06/17/13											
PROFESSIONAL SEAL (IF REVISION, APPLIES ONLY TO REVISED WORK)	ISSUE (PROGRESS, ESTIMATE, BID, CONSTRUCTION, CONFORMED, REVISION, RECORD)	REVISION NUMBER	DRAWN BY	CHECKED BY	APPR'D BY	DATE	REMARKS				
		-	DSV	LDD	MCD	6/17/13	AS BUILT PER FIELD VERIFICATION				

BLDG-67 FIRE ALARM CONTROL UNIT ARRANGEMENT
FAP-001-67

UNIVERSITY OF CALIFORNIA
LAWRENCE BERKELEY NATIONAL LABORATORY
FACILITIES DIVISION

DRAWN BY	DSV	DATE	06/17/2013
CHECKED BY	LDD	DATE	7/8/2013
APPROVED BY	MCD	DATE	7/8/2013
SCALE			
DRAWING NO.	4B67E153	SHEET	6
PROJECT NO.	FN1438		6 OF 21