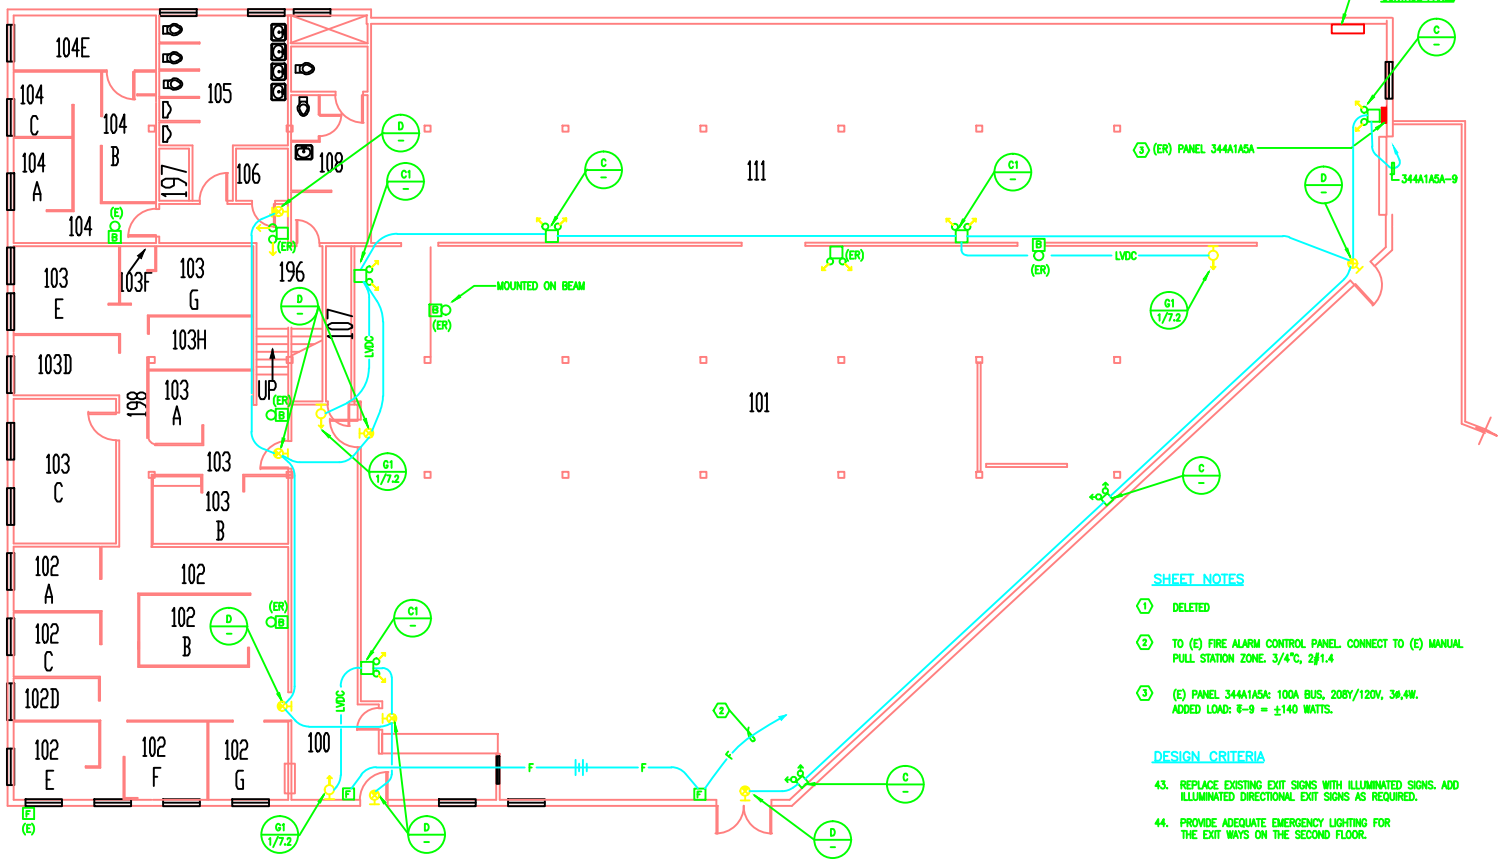

SHEET NOTES

1. DELETED
2. TO (E) FIRE ALARM CONTROL PANEL. CONNECT TO (E) MANUAL PULL STATION ZONE. 3/4"C, 2#1.4
3. (E) PANEL 344A1A5A: 100A BUS, 208Y/120V, 3Ø,4W. ADDED LOAD: 8-9 = ±140 WATTS.

DESIGN CRITERIA

43. REPLACE EXISTING EXIT SIGNS WITH ILLUMINATED SIGNS. ADD ILLUMINATED DIRECTIONAL EXIT SIGNS AS REQUIRED.
44. PROVIDE ADEQUATE EMERGENCY LIGHTING FOR THE EXIT WAYS ON THE SECOND FLOOR.

1 / 07-E2.1 FIRST FLOOR ELECTRICAL PLAN

SCALE: 1/8"=1'-0"

ESS ARCHITECTS
455 Ninth Street
San Francisco, CA 94103
415 863-7800
415 863-1888 Fax

CONSULTANT
MAZZETTI & ASSOCIATES, INC.
Consulting Mechanical & Electrical Engineers
1003 BRANNAN STREET - SAN FRANCISCO, CA 94103-4321
TELEPHONE (415) 864-8899 FAX (415) 864-4353
421-225

REVISIONS

no.	date	description
1		90% TITLE II 9/28/94
2		100% TITLE II 11/7/94
3		FINAL TITLE II 2/13/95
4		REISSUE FINAL TITLE II 3/30/95
5		AS BUILT 7/25/97

JOB TITLE

FIRE AND SAFETY SYSTEMS UPGRADE
PHASE I
LAWRENCE BERKELEY LABORATORY, UNIVERSITY OF CALIFORNIA
BERKELEY, CALIFORNIA

KEY PLAN

REGISTERED PROFESSIONAL ENGINEER
WILLIAM R. MAZZETTI
No. 13450
Exp. 9/30/95
ELECTRICAL
STATE OF CALIFORNIA

ESS ARCHITECTS JOB #: 9292
LBL SC#: 728
LBL FILE DRAWING:
ACAD FILE NAME:
LBNL DWG. 3N07E016E
PROJ # 120257

SHEET TITLE:
BLDG. 7
FIRST FLOOR PLAN
ELECTRICAL PLAN

SCALE: 1/8"=1'-0"
DATE: 2/13/95

SHEET:
07-E2.1E