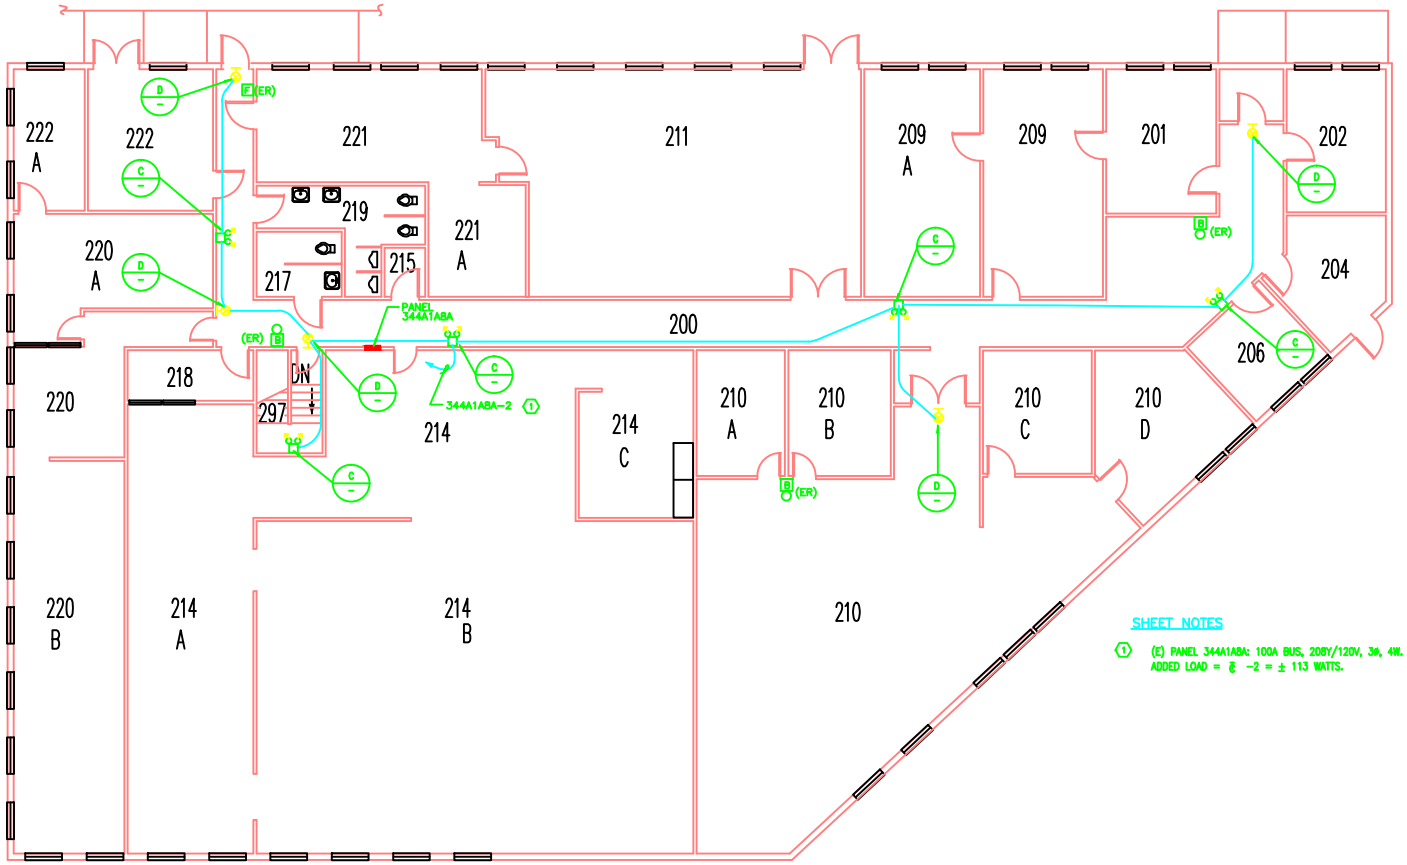

SHEET NOTES

1 (E) PANEL 344A1A8A: 100A BUS, 208Y/120V, 3ø, 4W. ADDED LOAD = ℄ -2 = ± 113 WATTS.

1 / 07-E2.2 SECOND FLOOR ELECTRICAL PLAN

SCALE: 1/8"=1'-0"

ESS ARCHITECTS
466 Eighth Street
San Francisco, CA 94103
415 252-9500
415 252-1555 Fax

CONSULTANT
MAZZETTI & ASSOCIATES, INC.
Consulting Mechanical & Electrical Engineers
1000 BRANNAN STREET – SAN FRANCISCO, CA 94103-4971
TELEPHONE (415) 864-8000 FAX (415) 864-4263
421-225

REVISIONS

no.	date	description
A	90% TITLE II	9/28/94
B	100% TITLE II	11/7/94
C	FINAL TITLE II	2/13/95
D	REISSUE FINAL TITLE II	3/30/95
E	AS BUILT	7/25/97

JOB TITLE

FIRE AND SAFETY SYSTEMS UPGRADE
PHASE I
LAWRENCE BERKELEY LABORATORY, UNIVERSITY OF CALIFORNIA
BERKELEY, CALIFORNIA

KEY PLAN

REGISTERED PROFESSIONAL ENGINEER
WILLIAM R. MAZZETTI JR.
No. 13450
EXP. 9/30/98
ELECTRICAL
STATE OF CALIFORNIA

ESS ARCHITECTS JOB #: 9292
LBL SC#: 728
LBL FILE DRAWING:
ACAD FILE NAME:
LBNL DWG. 3N07E017E
PROJ # 120257

SHEET TITLE:
BLDG. 7
SECOND FLOOR PLAN
ELECTRICAL PLAN
SCALE: 1/8"=1'-0" DATE: 2/13/95
SHEET: 07-E2.2E