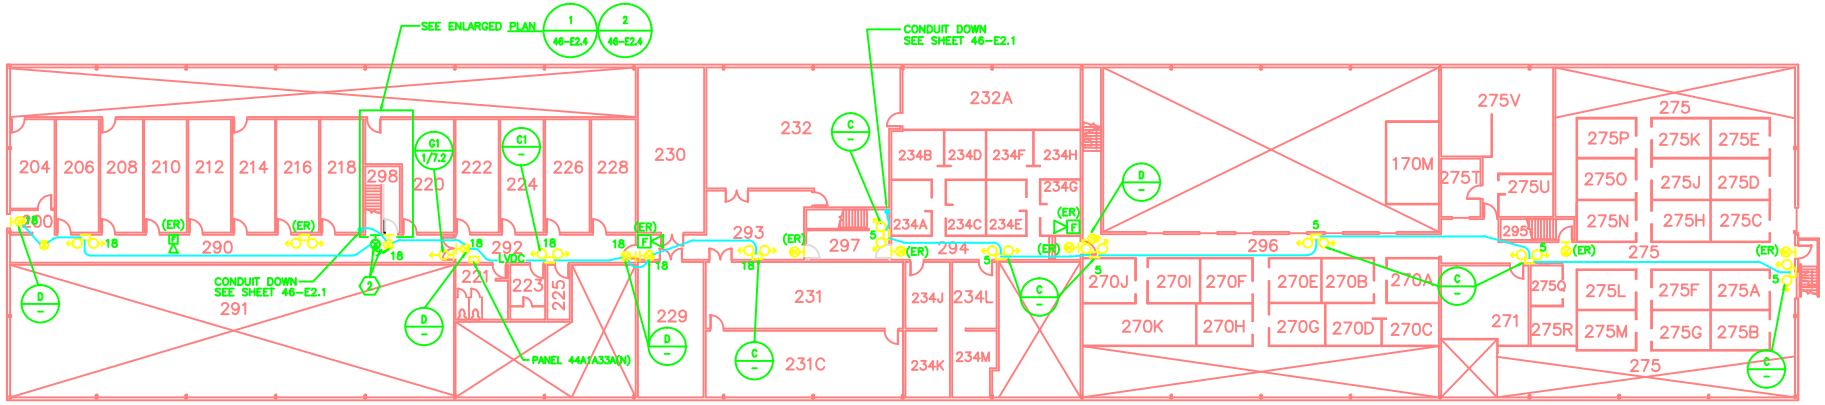

1
46-E2.2

SECOND FLOOR DEMO. & CONSTRUCTION PLAN

SCALE: 1/16"=1'-0"

SHEET NOTES

1. NOT USED.
2. REMOVE AND RELOCATE (E) FIXTURE AS SHOWN. CLEAN AND RELAMP FIXTURE.

ess ARCHITECTS
466 Eighth Street
San Francisco, CA 94103
415 252-9500
415 252-1585 Fax

CONSULTANT

MAZZETTI & ASSOCIATES, INC.
Consulting Mechanical & Electrical Engineers
1000 BRANNAN STREET – SAN FRANCISCO, CA 94103-4871
TELEPHONE (415) 864-5800 FAX (415) 864-5363
621-283

REVISIONS

no.	date	description
A		90% TITLE II 9/26/94
B		100% TITLE II 11/7/94
C		FINAL TITLE II 2/13/95
D		REISSUE FINAL TITLE II 3/30/95
E		AS BUILT 7/25/97

JOB TITLE

FIRE AND SAFETY SYSTEMS UPGRADE
PHASE I
LAWRENCE BERKELEY LABORATORY, UNIVERSITY OF CALIFORNIA
BERKELEY, CALIFORNIA

KEY PLAN

REGISTERED PROFESSIONAL ENGINEER
WILLIAM R. MAZZETTI
No. 13450
EXP. 9/30/98
ELECTRICAL
STATE OF CALIFORNIA

ESS ARCHITECTS JOB #: 9292
LBL SC#: 728
LBL FILE DRAWING:
ACAD FILE NAME:
LBNL DWG. 3N46E057E
PROJ # 120257

SHEET TITLE:
BUILDING 46
SECOND FLOOR
DEMO. & CONSTRUCTION PLAN

SCALE: AS NOTED
DATE: 2/13/95

SHEET:
46-E2.2E