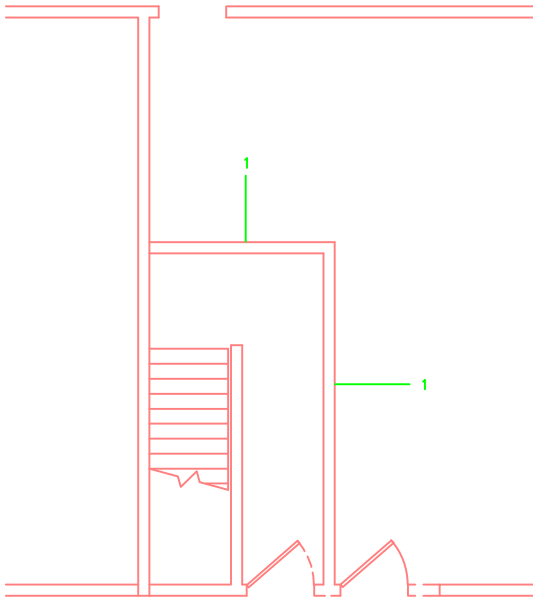

EXISTING WORK

1 PARTIAL SECOND FLOOR STAIRS
46-E2.4 SCALE: 1/4"=1'-0"

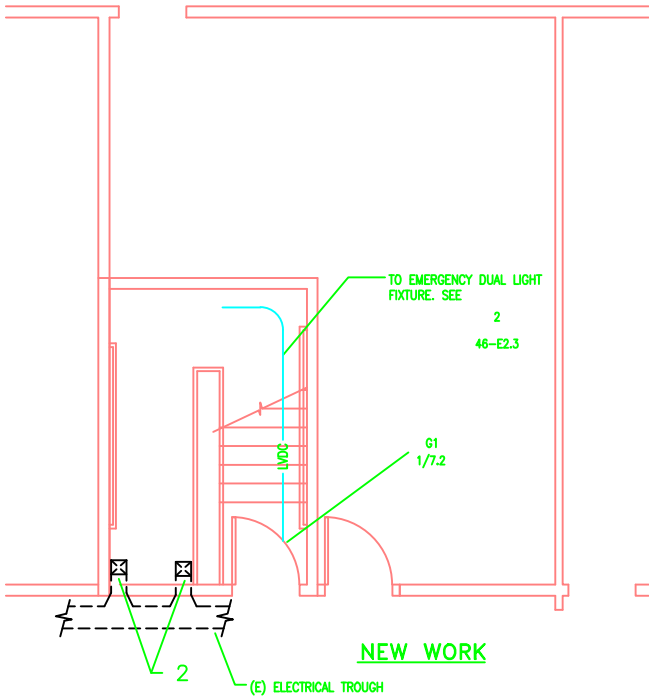

NEW WORK

2 PARTIAL SECOND FLOOR STAIRS
46-E2.4 SCALE: 1/4"=1'-0"

SHEET NOTES

1 REMOVE ALL (E) DEVICES, PANELBOARDS AND CONDUITS. RELOCATE TO NEW WALL.

2 PROVIDE FIRE STOP PENETRATION.

△1 90% TITLE II 9/26/94
△2 100% TITLE II 11/7/94
△3 FINAL TITLE II 2/13/95
△4 REISSUE FINAL TITLE II 3/30/95
△5 AS BUILT 7/25/97

728

BLDG. 46
FIRST FLOOR
ELECTRICAL PLAN
1/8"=1'-0" 2/13/95

LBNL DWG. 3N46E059E
PROJ # 120257
46-E2.4E

Xref BORDER