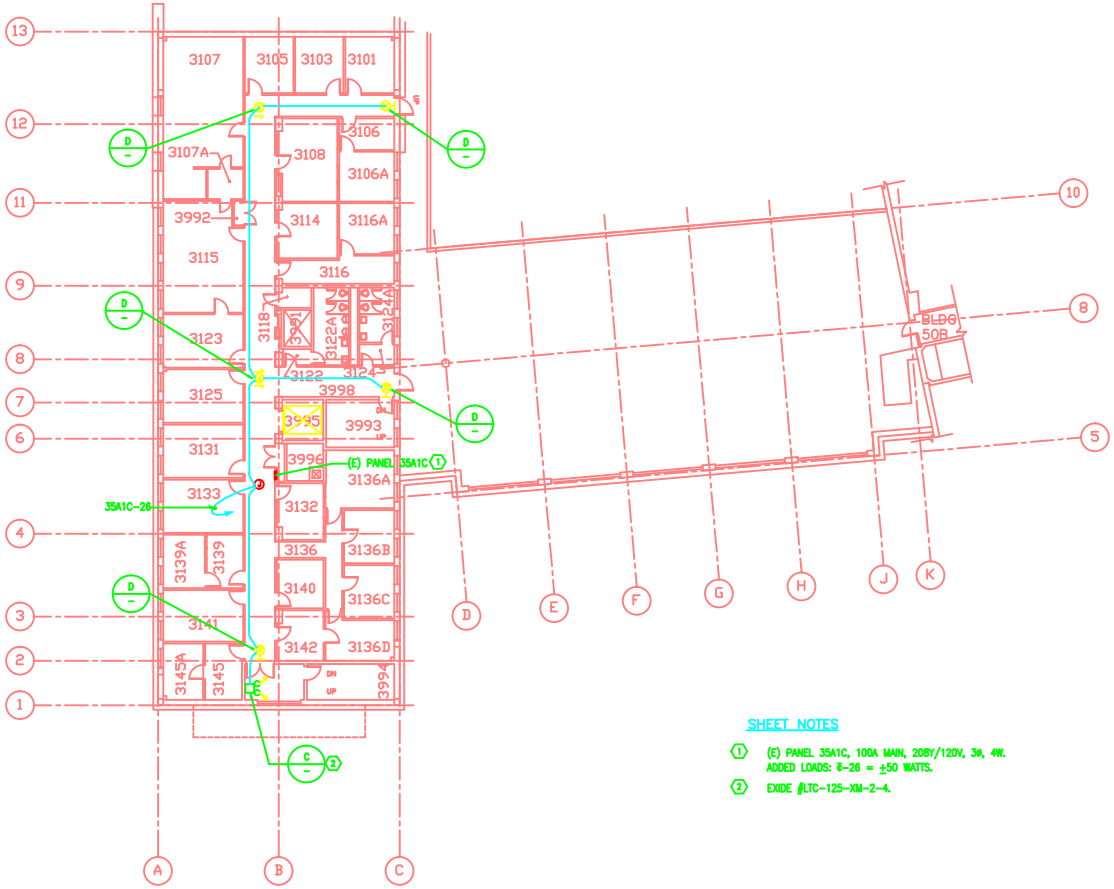

SHEET NOTES

1. (E) PANEL 35A1C, 100A MAIN, 208Y/120V, 3ø, 4W. ADDED LOADS: ⊼-26 = ±50 WATTS.
2. EXIDE #LTC-125-XM-2-4.

1 / 5A-E2.4 THIRD FLOOR DEMO. & CONSTRUCTION PLAN
SCALE: 1/16"=1'-0"

ESS ARCHITECTS
468 Eighth Street
San Francisco, CA 94103
415 252-9500
415 252-1885 Fax

CONSULTANT
MAZZETTI & ASSOCIATES, INC.
Consulting Mechanical & Electrical Engineers
1000 BRANNAN STREET - SAN FRANCISCO, CA 94103-4971
TELEPHONE (415) 864-8000 FAX (415) 864-4263
421-225

REVISIONS

no.	date	description
A	90% TITLE II	9/28/94
B	100% TITLE II	11/7/94
C	FINAL TITLE II	2/13/95
D	REISSUE FINAL TITLE II	3/30/95
E	AS BUILT	7/25/97

JOB TITLE
FIRE AND SAFETY SYSTEMS UPGRADE
PHASE I
LAWRENCE BERKELEY LABORATORY, UNIVERSITY OF CALIFORNIA
BERKELEY, CALIFORNIA

KEY PLAN
REGISTERED PROFESSIONAL ENGINEER
WILLIAM P. MAZZETTI
No. 13450
EXP. 9/30/98
ELECTRICAL
STATE OF CALIFORNIA

ESS ARCHITECTS JOB #: 9292
LBL SC#: 728
LBL FILE DRAWING:
ACAD FILE NAME:
LBNL DWG. 3N50AE117E
PROJ # 120257

SHEET TITLE:
BLDG. 50A
THIRD FLOOR PLAN
DEMO. & CONSTRUCTION PLAN
SCALE: 1/16"=1'-0" DATE: 2/13/95
SHEET: 50A-E2.4E