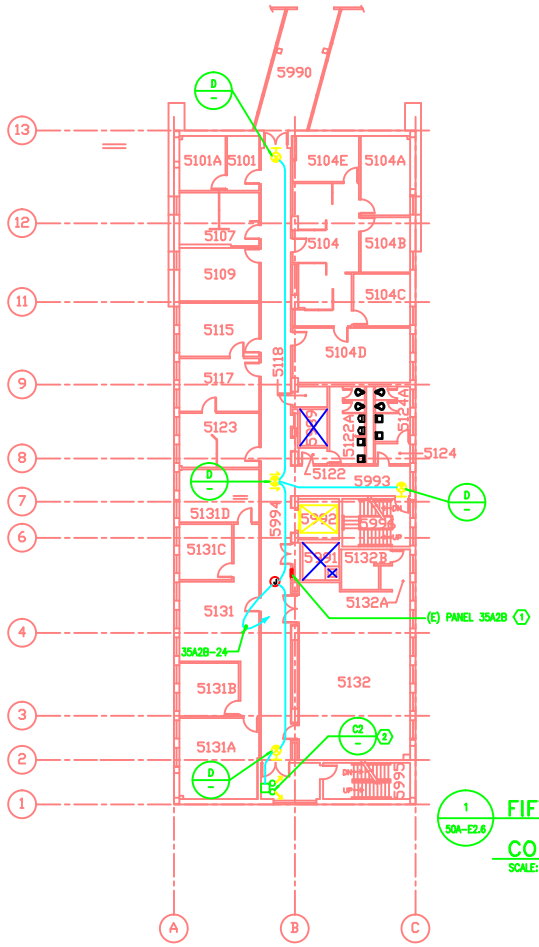

SHEET NOTES

1. (E) PANEL 35A2B, 225A MAIN, 208Y/120V, 3ø, 4W. LOAD: ℄-23 = 42 WATTS.
2. EXIDE #LTC-125-WM-2-4.

1 50A-E2.6 FIFTH FLOOR DEMO. & CONSTRUCTION PLAN

SCALE: 1/16"=1'-0"

ESS ARCHITECTS
468 Eighth Street
San Francisco, CA 94103
415 252-9500
415 252-1885 Fax

CONSULTANT
MAZZETTI & ASSOCIATES, INC.
Consulting Mechanical & Electrical Engineers
1000 BRANNAN STREET – SAN FRANCISCO, CA 94103-4971
TELEPHONE (415) 864-8000 FAX (415) 864-4263
421-225

REVISIONS

no.	date	description
A	90% TITLE II	9/26/94
B	100% TITLE II	11/7/94
C	FINAL TITLE II	2/13/95
D	REISSUE FINAL TITLE II	3/30/95
E	AS BUILT	7/25/97

JOB TITLE

FIRE AND SAFETY SYSTEMS UPGRADE
PHASE I
LAWRENCE BERKELEY LABORATORY, UNIVERSITY OF CALIFORNIA
BERKELEY, CALIFORNIA

KEY PLAN

REGISTERED PROFESSIONAL ENGINEER
WILLIAM R. MAZZETTI
No. 13450
EXP. 9/30/99
ELECTRICAL
STATE OF CALIFORNIA

ESS ARCHITECTS JOB #: 9292
LBL SC#: 728
LBL FILE DRAWING:
ACAD FILE NAME:
LBNL DWG. 3N50AE119E
PROJ # 120257

SHEET TITLE:
BLDG. 50A
FIFTH FLOOR PLAN
DEMO. & CONSTRUCTION PLAN
SCALE: 1/16"=1'-0" DATE: 2/13/95
SHEET: 50A-E2.6E