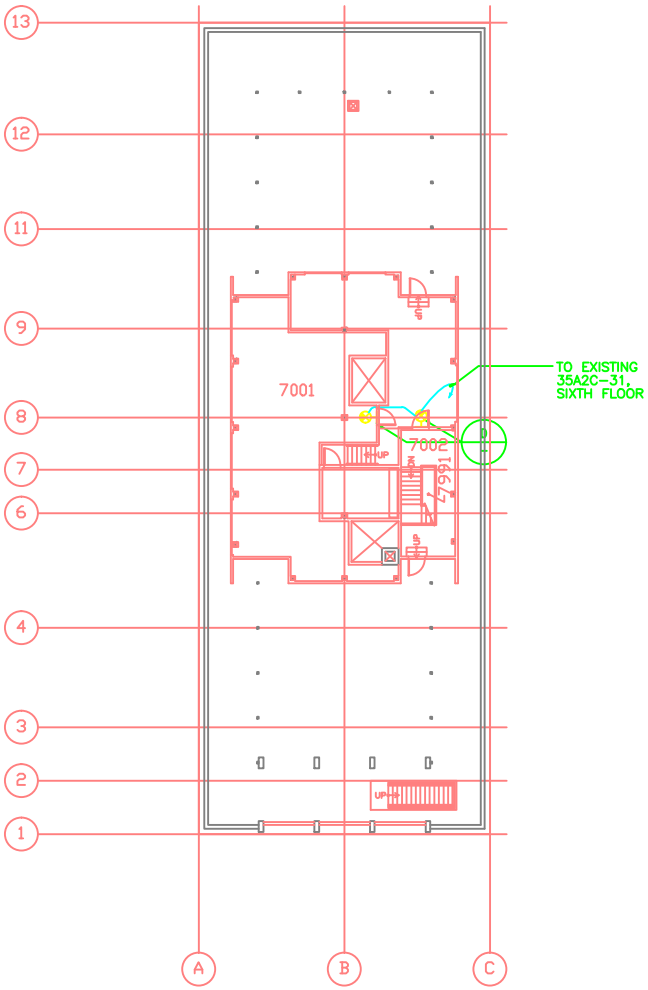

1 / 50A-E2.8 SEVENTH FLOOR – DEMO. & CONSTRUCTION PLAN

SCALE: 1/16"=1'-0"

ess ARCHITECTS
466 Eighth Street
San Francisco, CA 94103
415 252-9500
415 252-1555 Fax

CONSULTANT

MAZZETTI & ASSOCIATES, INC.
Consulting Mechanical & Electrical Engineers
1000 BRANNAN STREET – SAN FRANCISCO, CA 94103-4871
TELEPHONE (415) 864-5800 FAX (415) 864-5363
621-283

REVISIONS

no.	date	description
A		90% TITLE II 9/26/94
B		100% TITLE II 11/7/94
C		FINAL TITLE II 2/13/95
D		REISSUE FINAL TITLE II 3/30/95
E		AS BUILT 7/25/07

JOB TITLE

FIRE AND SAFETY SYSTEMS UPGRADE
PHASE I
LAWRENCE BERKELEY LABORATORY, UNIVERSITY OF CALIFORNIA
BERKELEY, CALIFORNIA

KEY PLAN

REGISTERED PROFESSIONAL ENGINEER
WILLIAM P. MAZZETTI
No. 13450
EXP. 9/30/96
ELECTRICAL
STATE OF CALIFORNIA

ESS ARCHITECTS JOB #: 9292
LBL SC#: 728
LBL FILE DRAWING:
ACAD FILE NAME:
LBNL DWG. 3N50AE121E
PROJ # 120257

SHEET TITLE:
BUILDING 50A
SEVENTH FLOOR – DEMO. & CONST. PLAN

SCALE: 1/32"=1'-0"
DATE: 2/13/95

SHEET:
50A-E2.8E