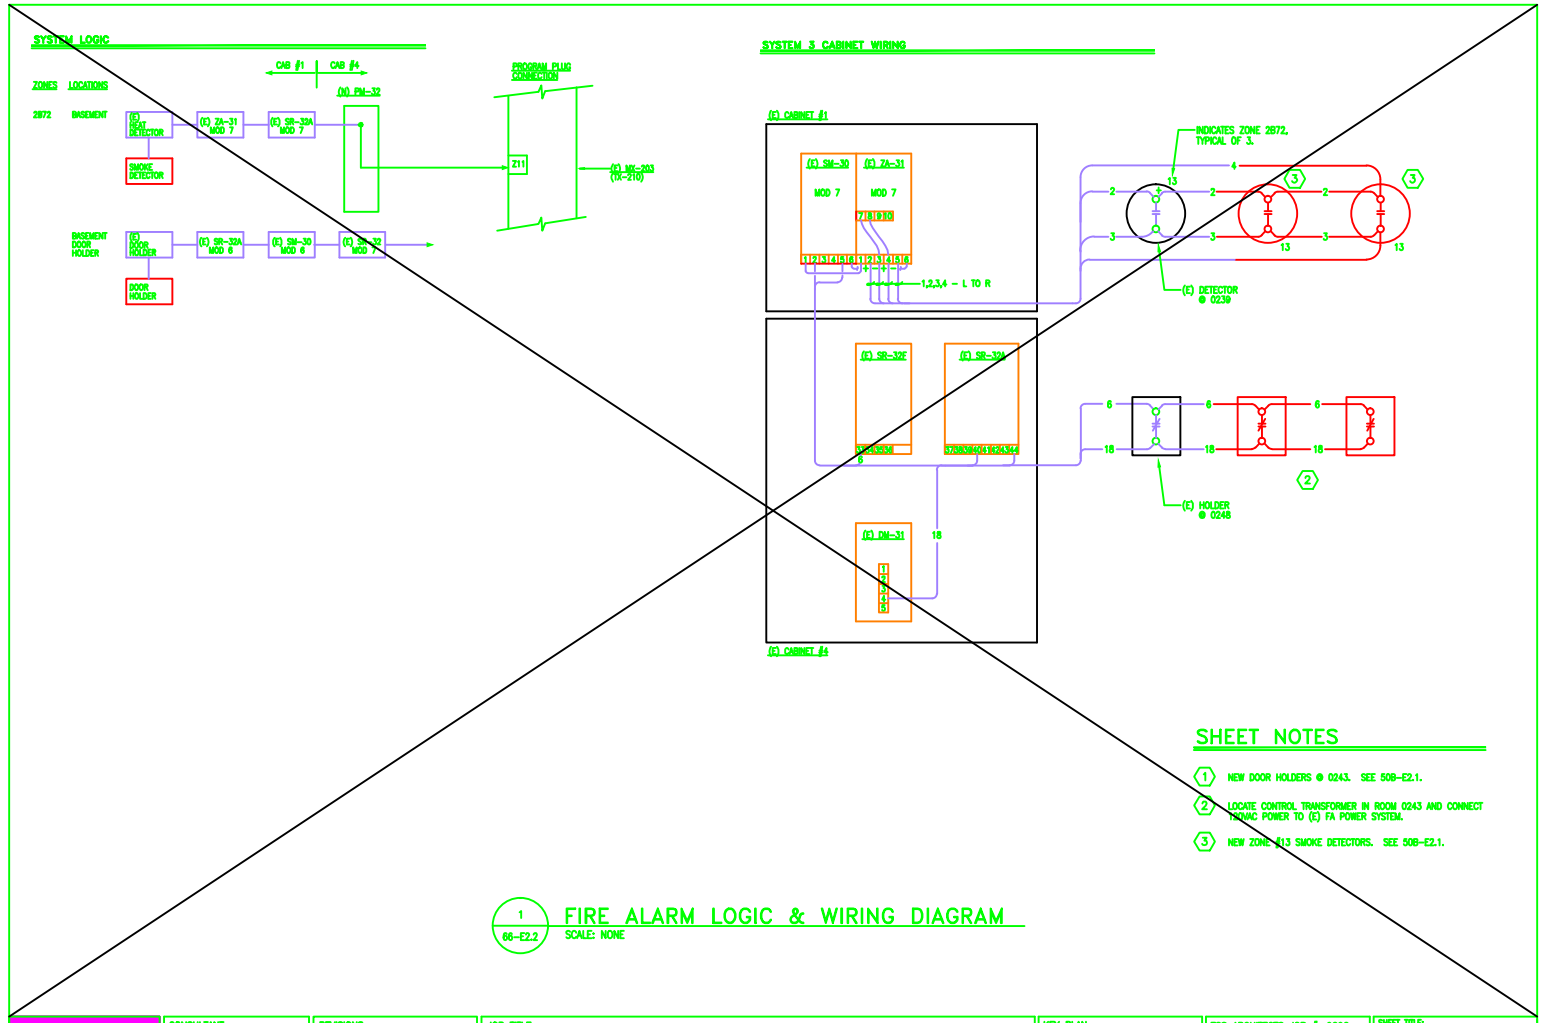

SHEET NOTES

1. NEW DOOR HOLDERS @ 0243. SEE 50B-E2.1.
2. LOCATE CONTROL TRANSFORMER IN ROOM 0243 AND CONNECT HVAC POWER TO (E) FA POWER SYSTEM.
3. NEW ZONE #13 SMOKE DETECTORS. SEE 50B-E2.1.

1 / 66-E2.2

FIRE ALARM LOGIC & WIRING DIAGRAM

SCALE: NONE

ESS ARCHITECTS
455 Ellis Street
San Francisco, CA 94102
415 885-2220
415 885-1888 Fax

CONSULTANT

MAZZETTI & ASSOCIATES, INC.
Consulting Mechanical & Electrical Engineers
1000 BRANNAN STREET - SAN FRANCISCO, CA 94103-4317
TELEPHONE (415) 554-4000 FAX (415) 554-4333
J 431-225

REVISIONS

no.	date	description
1		90% TITLE II 9/28/94
2		100% TITLE II 11/7/94
3		FINAL TITLE II 2/13/95
4		REISSUE FINAL TITLE II 3/30/95
5		FIRE ALARM SCHEMATICS REV. 1 7/7/95
6		AS BUILT 7/25/97

JOB TITLE

FIRE AND SAFETY SYSTEMS UPGRADE
PHASE I
LAWRENCE BERKELEY LABORATORY, UNIVERSITY OF CALIFORNIA
BERKELEY, CALIFORNIA

KEY PLAN

REGISTERED PROFESSIONAL ENGINEER WILLIAM R. MAZZETTI No. 13480 EXP. 9/30/98 ELECTRICAL STATE OF CALIFORNIA

ESS ARCHITECTS JOB #: 9292
LBL SC#: 728
LBL FILE DRAWING: *
LBNL DWG. 3N50BE195F
PROJ # 120257

SHEET TITLE: FIRE ALARM LOGIC & WIRING DIAGRAM
SCALE:
DATE: 7/7/95
SHEET: 50B-E2.2F