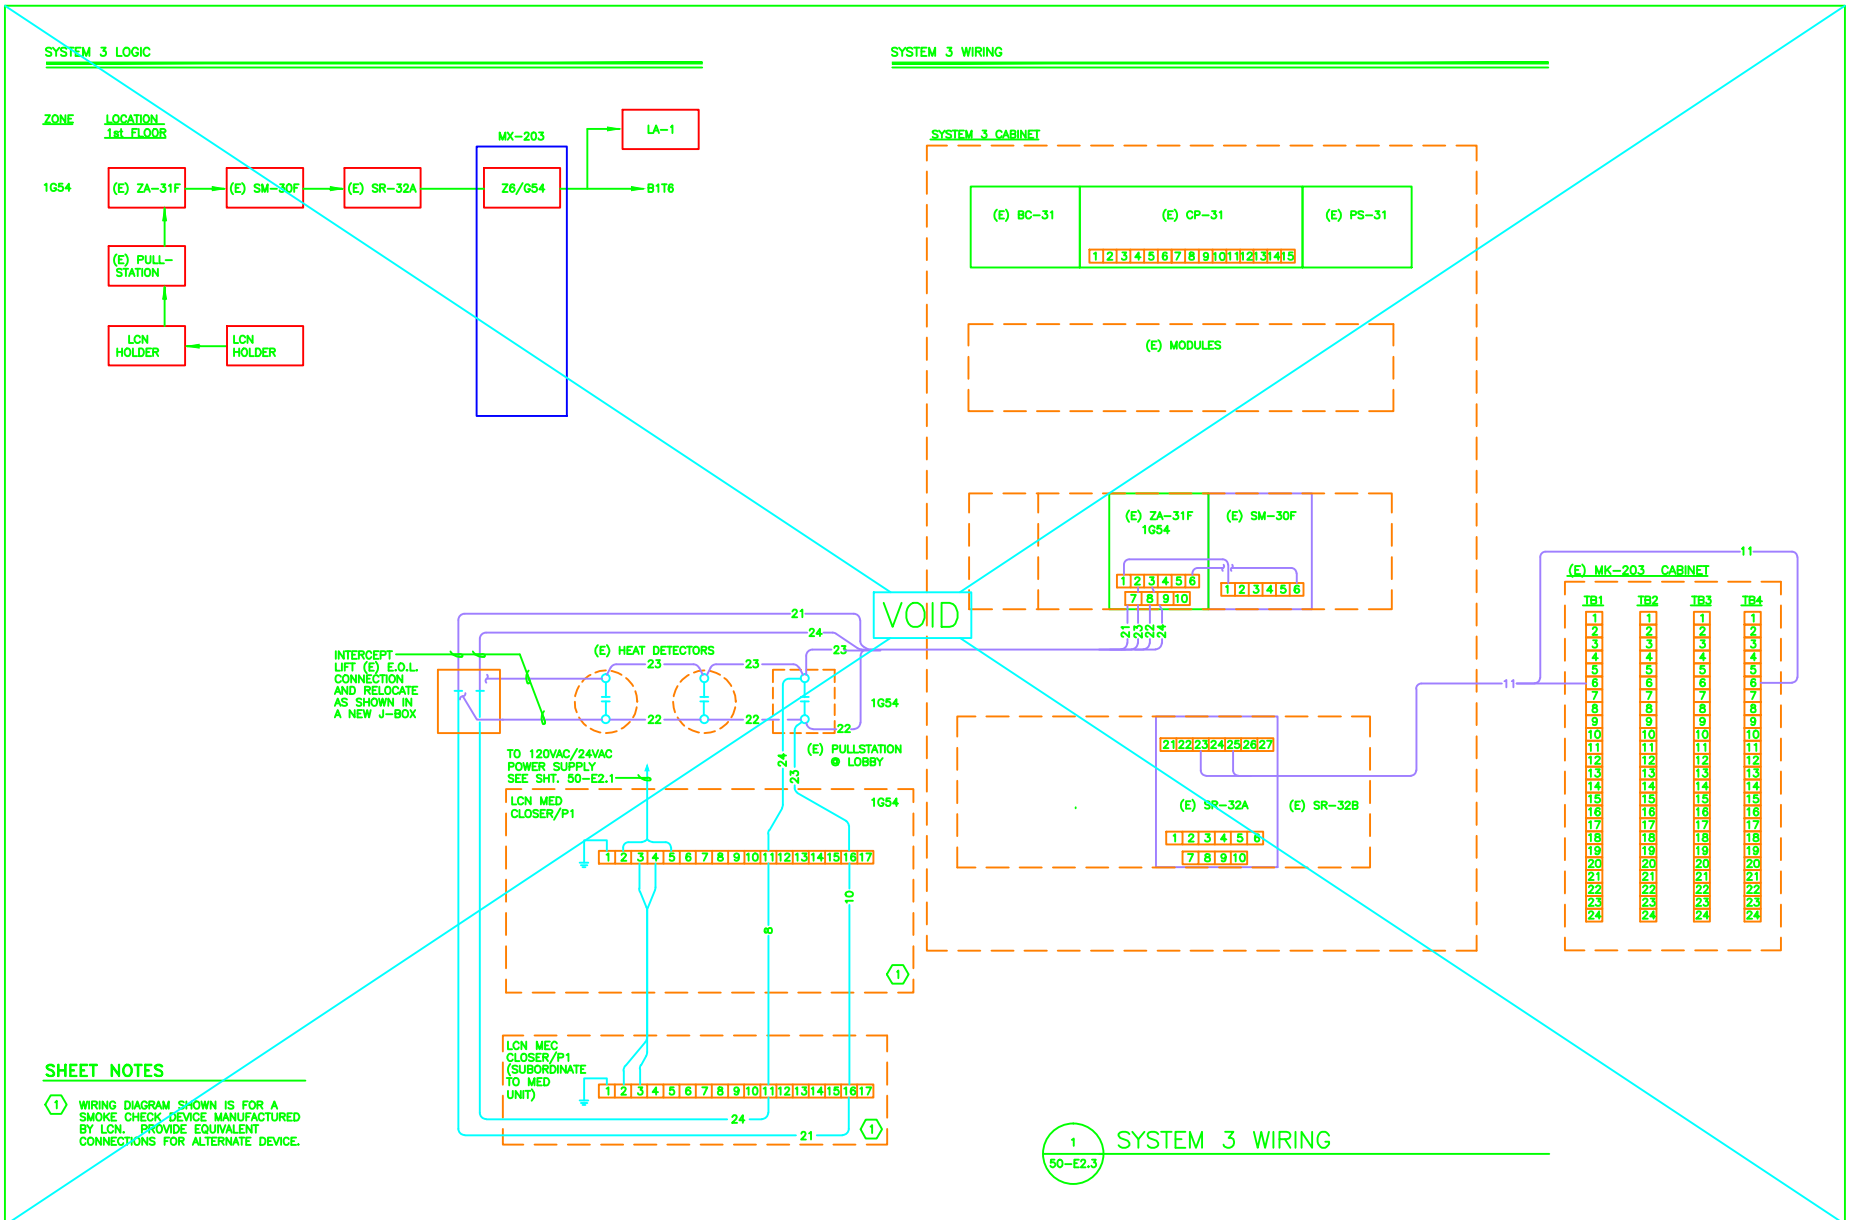

SHEET NOTES

1. WIRING DIAGRAM SHOWN IS FOR A SMOKE CHECK DEVICE MANUFACTURED BY LCN. PROVIDE EQUIVALENT CONNECTIONS FOR ALTERNATE DEVICE.

ESS ARCHITECTS
455 Eighth Street
San Francisco, CA 94103
415 252-9500
415 252-1555 Fax

CONSULTANT

MAZZETTI & ASSOCIATES, INC.
Consulting Mechanical & Electrical Engineers
1000 BRANNAN STREET - SAN FRANCISCO, CA 94103-4871
TELEPHONE (415) 864-5899 FAX (415) 864-6363
621-283

REVISIONS

no.	date	description
A		90% TITLE II 9/26/94
B		100% TITLE II 11/7/94
C		FINAL TITLE II 2/13/95
D		REISSUE FINAL TITLE II 3/30/95
E		FIRE ALARM SCHEMATICS REV. 1 7/7/95
F		VOIDED DWG AND REPLACED WITH 6850E027D BY LBNL 9/21/95
G		AS BUILT 7/25/97

JOB TITLE

FIRE AND SAFETY SYSTEMS UPGRADE
PHASE I
LAWRENCE BERKELEY LABORATORY, UNIVERSITY OF CALIFORNIA
BERKELEY, CALIFORNIA

KEY PLAN

REGISTERED PROFESSIONAL ENGINEER
WILLIAM P. MAZZETTI JR.
No. 13450
EXP. 9/30/98
ELECTRICAL
STATE OF CALIFORNIA

ESS ARCHITECTS JOB #: 9292
LBL SC#: 728
LBL FILE DRAWING: 00002379
ACAD FILE NAME:
LBNL DWG. 3N50E066G
PROJ # 120257

SHEET TITLE:
BUILDING 50
FIRE ALARM LOGIC
& WIRING DIAGRAM

SCALE: AS NOTED
DATE: 7/7/95

SHEET:
50-E2.3G