SHEET NOTES

1. NOT USED
2. NOT USED
3. HEAT DETECTOR IN RM. 161
4. NOT USED
5. DOOR HOLDER WITH INTEGRAL SMOKE DETECTOR, NORTON MASTER UNIT CAT. #PTD-24 FOR CLASS, 4 WIRE SYSTEM
6. REFER TO DWG. 4B55E069D FOR SYSTEM LOGIC DIAGRAM.

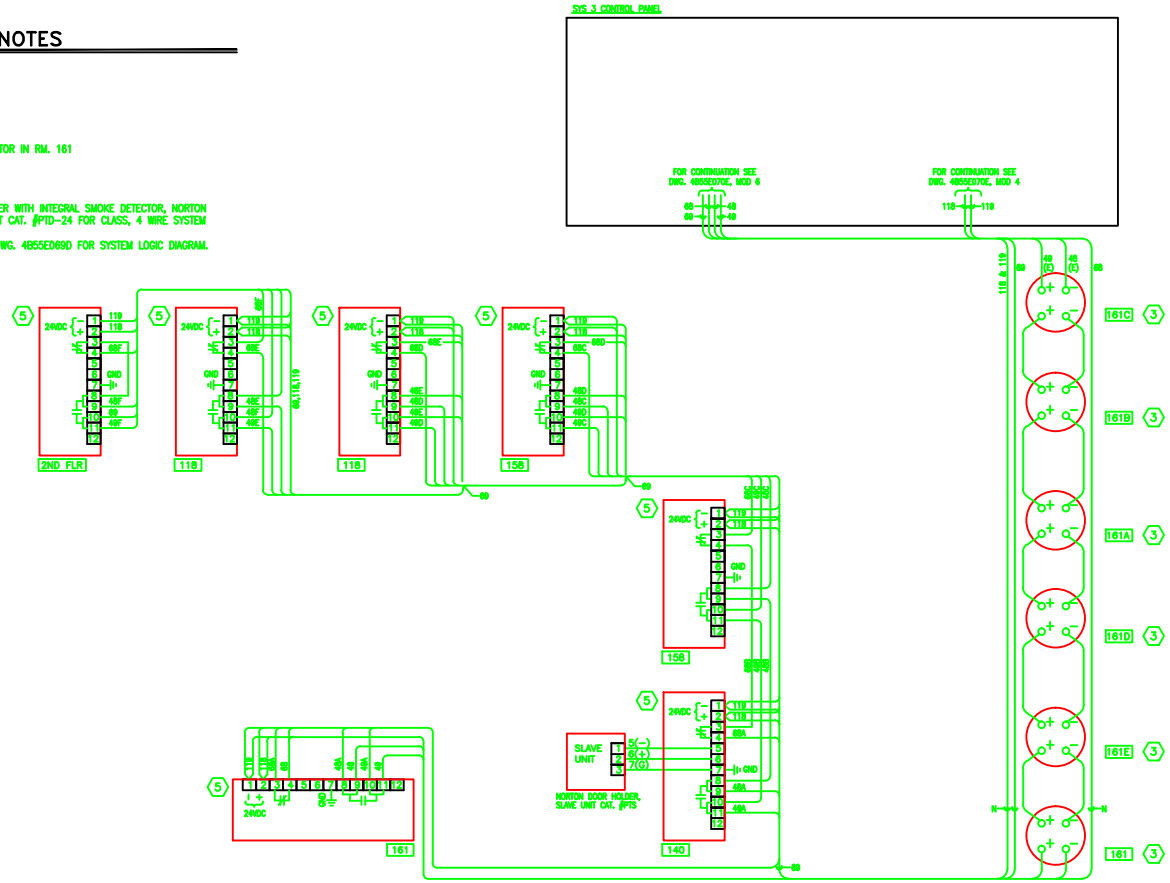

1 / 55-E2.3 FIRE ALARM LOGIC & WIRING DIAGRAM
SCALE: NONE

ESS ARCHITECTS
488 Eighth Street
San Francisco, CA 94103
415 252-9500
415 252-1555 Fax

CONSULTANT
MAZZETTI & ASSOCIATES, INC.
Consulting Mechanical & Electrical Engineers
1000 BRANNAN STREET – SAN FRANCISCO, CA 94103-4971
TELEPHONE (415) 864-8000 FAX (415) 864-4263
421-225

REVISIONS

no.	date	description
A		90% TITLE II 9/26/94
B		100% TITLE II 11/7/94
C		FINAL TITLE II 2/13/95
D		REISSUE FINAL TITLE II 3/30/95
E		FIRE ALARM SCHEMATICS REV. 1 7/7/95
F		FIRE AND LIFE SAFETY 10/2/95
H		AS BUILT 7/25/97

JOB TITLE
FIRE AND SAFETY SYSTEMS UPGRADE
PHASE I
LAWRENCE BERKELEY LABORITORY, UNIVERSITY OF CALIFORNIA
BERKELEY, CALIFORNIA

KEY PLAN
REGISTERED PROFESSIONAL ENGINEER
WILLIAM P. MAZZETTI JR.
No. 13450
EXP. 9/30/98
ELECTRICAL
STATE OF CALIFORNIA

ESS ARCHITECTS JOB #: 9292
LBL SC#: 728
LBL FILE DRAWING: *
LBNL DWG. 3N55E081H
PROJ # 120257

SHEET TITLE:
BLDG. 55
FIRE ALARM LOGIC AND WIRING DIAGRAM
SCALE:
DATE: 7/7/95
SHEET:
55-E2.3H