SHEET NOTES

1. (E) PANEL 263A2A: 225A BUS, 208Y/120V, 3ø, 4W.
   ADDED LOAD: 8-5 = ±126 WATTS.

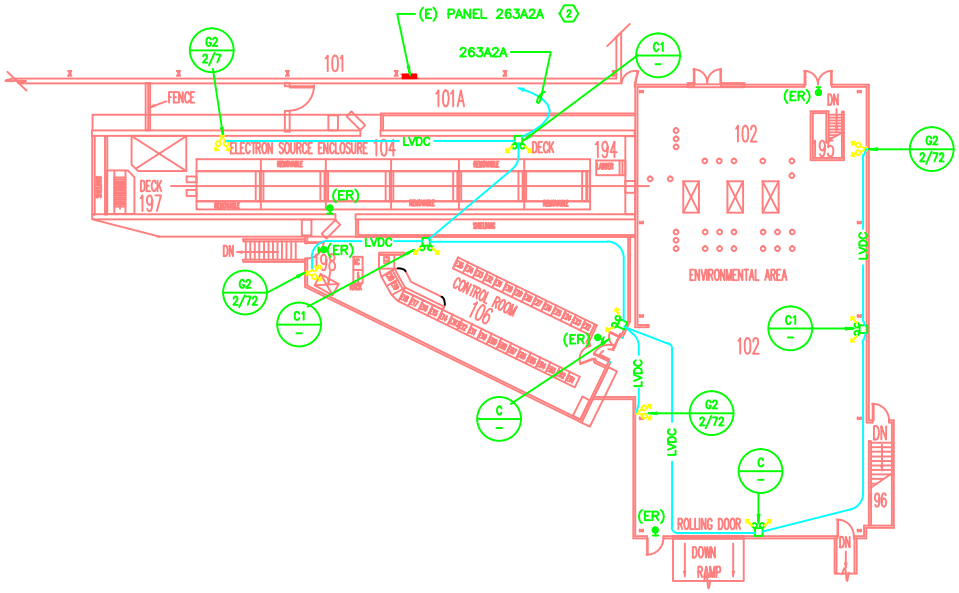

DESIGN CRITERIA

114. PROVIDE ADEQUATE EMERGENCY LIGHTING IN THE CONTROL ROOM AND HIGH BAY AREA.

1 / 58A-E2.1 FIRST FLOOR DEMOLITION & CONSTRUCTION PLAN
SCALE: 1/16"=1'-0"

ess ARCHITECTS
466 Eighth Street
San Francisco, CA 94103
415 252-9500
415 252-1585 Fax

CONSULTANT
MAZZETTI & ASSOCIATES, INC.
Consulting Mechanical & Electrical Engineers
1000 BRANNAN STREET – SAN FRANCISCO, CA 94103-4871
TELEPHONE (415) 864-5800 FAX (415) 864-5363
621-283

REVISIONS

no.	date	description
1		90% TITLE II 9/26/94
2		100% TITLE II 11/7/94
3		FINAL TITLE II 2/13/95
4		AS BUILT 7/25/97

JOB TITLE

FIRE AND SAFETY SYSTEMS UPGRADE
PHASE I
LAWRENCE BERKELEY LABORATORY, UNIVERSITY OF CALIFORNIA
BERKELEY, CALIFORNIA

KEY PLAN

REGISTERED PROFESSIONAL ENGINEER
WILLIAM R. MAZZETTI
No. 13450
EXP. 9/30/96
ELECTRICAL
STATE OF CALIFORNIA

ESS ARCHITECTS JOB #: 9292
LBL SC#: 728
LBL FILE DRAWING: *
ACAD FILE NAME:
LBNL DWG. 3N58AE013D
PROJ # 120257

SHEET TITLE:
BLDG. 58A
FIRST FLOOR
DEMO. & CONSTRUCTION PLAN
SCALE: AS NOTED
DATE: 2/13/95
SHEET: 58A-E2.1D