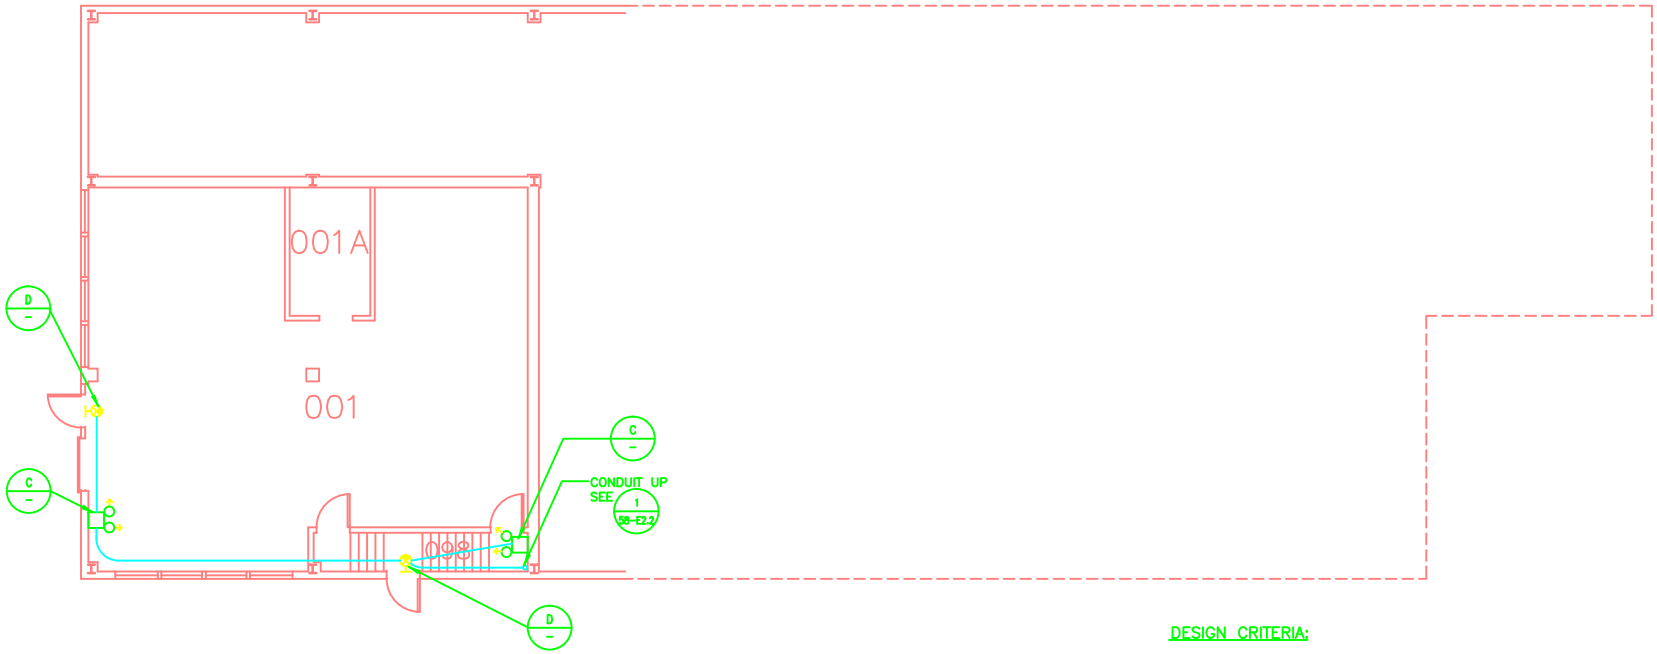

1 58-E2.1 BASEMENT FLOOR DEMO. & CONSTRUCTION PLAN
SCALE: 1/8" = 1'-0"

DESIGN CRITERIA:

81. PROVIDE ADEQUATE EMERGENCY LIGHTING FOR THE EXITWAYS.

82. PROVIDE ILLUMINATED EXIT SIGNS AS REQUIRED TO PROPERLY IDENTIFY EXIT PATHWAYS.

ESS ARCHITECTS
466 Eighth Street
San Francisco, CA 94103
415 252-9500
415 252-1585 Fax

CONSULTANT
MAZZETTI & ASSOCIATES, INC.
Consulting Mechanical & Electrical Engineers
1000 MINNIHAN STREET - SAN FRANCISCO, CA 94103-4071
TELEPHONE (415) 864-5800 FAX (415) 864-4363
621-283

REVISIONS

no.	date	description
A	90% TITLE II	9/26/94
B	100% TITLE II	11/7/94
C	FINAL TITLE II	2/13/95
D	AS BUILT	7/25/97

JOB TITLE
FIRE AND SAFETY SYSTEMS UPGRADE
PHASE I
LAWRENCE BERKELEY LABORATORY, UNIVERSITY OF CALIFORNIA
BERKELEY, CALIFORNIA

KEY PLAN
REGISTERED PROFESSIONAL ENGINEER
WILLIAM P. MAZZETTI, JR.
No. 13450
EXP. 9/30/98
ELECTRICAL
STATE OF CALIFORNIA

ESS ARCHITECTS JOB #: 9292
LBL SC#: 728
LBL FILE DRAWING:
ACAD FILE NAME:
LBNL DWG. 3N58E048D
PROJ # 120257

SHEET TITLE:
BLDG. 58
BASEMENT FLOOR PLAN
DEMO. & CONSTRUCTION PLAN
SCALE: AS NOTED
DATE: 2/13/95
SHEET: 58-E2.1D