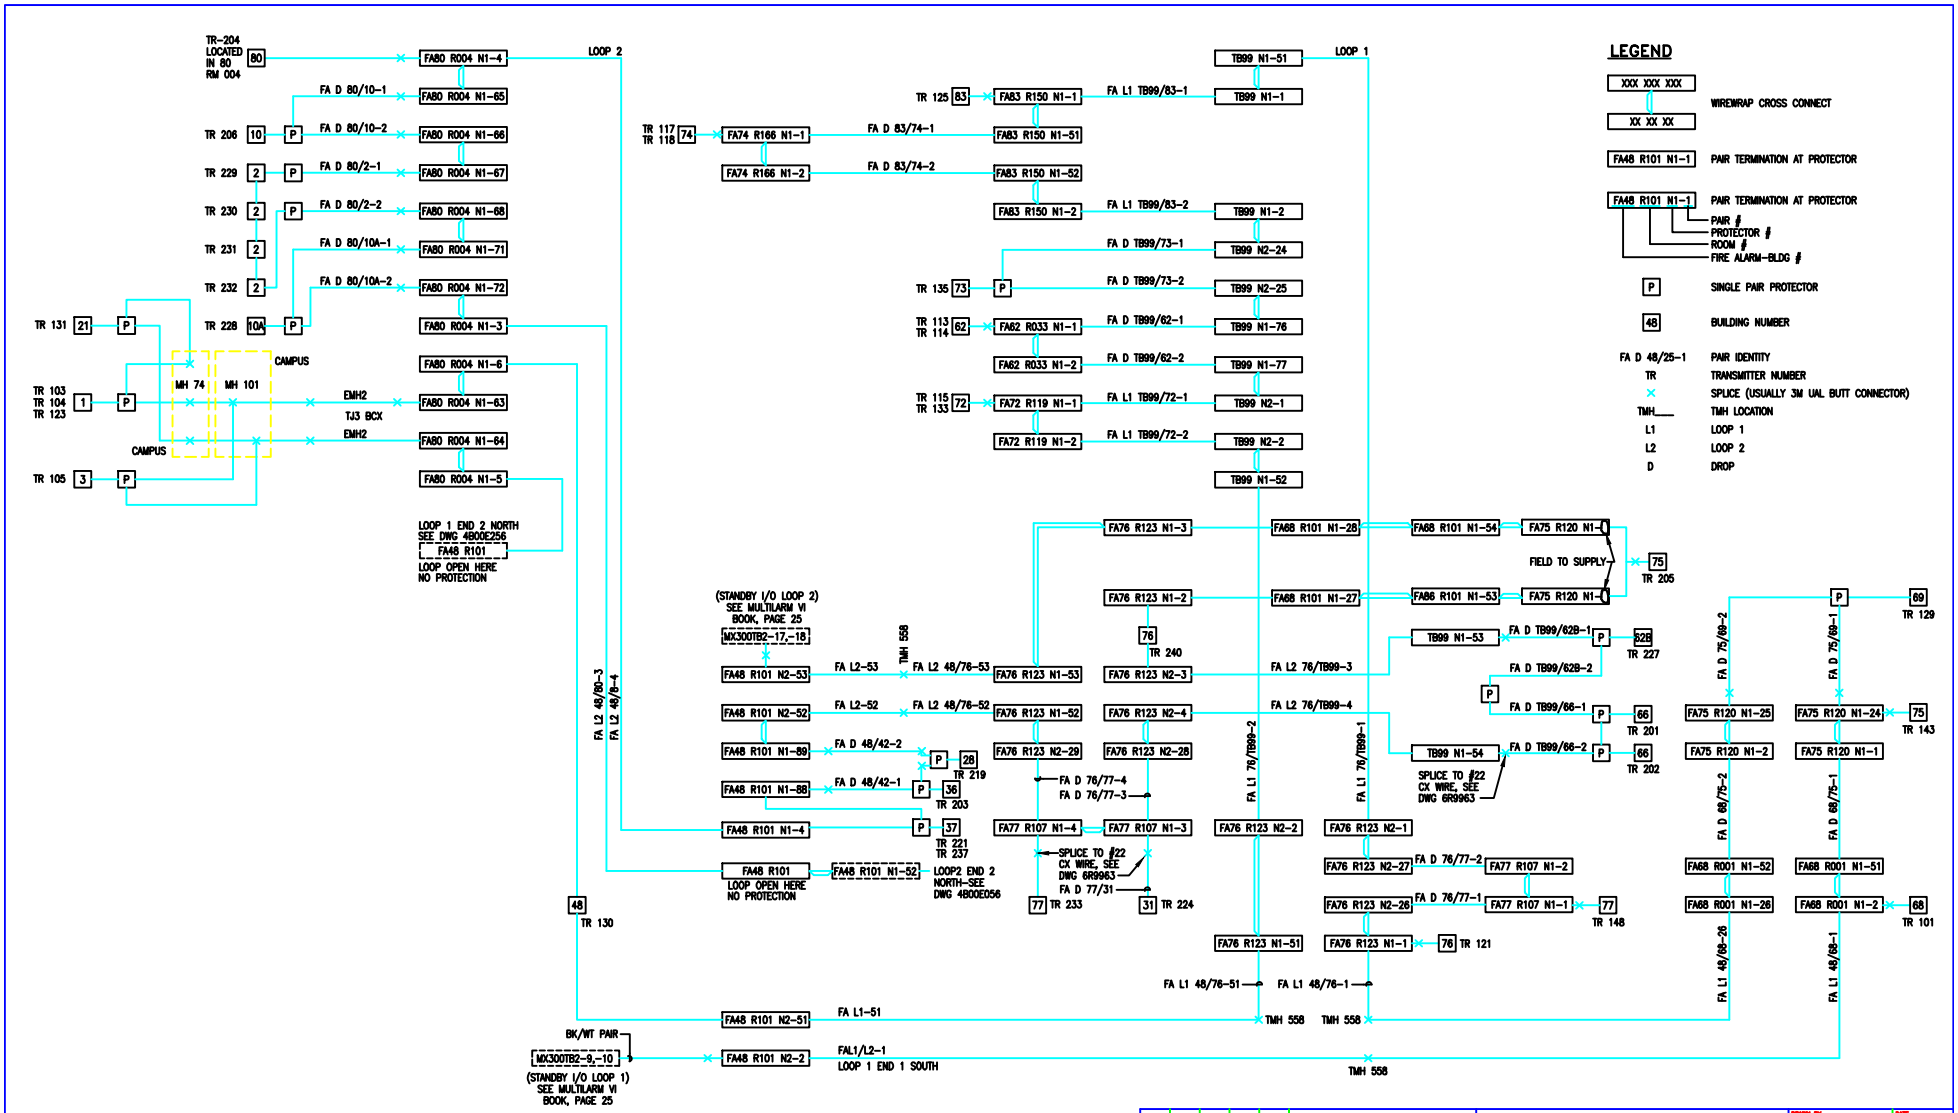

DISTRIBUTION LIST:

2-ELECTRIC SHOP B76 (FILE I & II)
1-B90J (FILE III)
1-STICK FILE B90J
ORIGINAL-FLAT FILE B90F

REVISION NUMBER	DRAWN BY	CHECKED BY	APPR'D BY	DATE	REMARKS
O	LDD	LDD	MCG	10/30/13	ADD BLDG 28 AS-BUILT
N	AD	MCG	MCG	5/18/01	ADD BLDG'S 84, 85 & AS-BUILT
M	AD	ROB	MCG	3/17/99	AS-BUILT
L	LM		MG	4/11/97	AUTOCAD CONVERSION
K	RG		RG	10/30/96	REMOVED TR 124 & TR 136
J	JBR		RG	4/9/89	ADDED ICS XMTRS BLDGS 1,10A,62B
H	JBR			1/27/89	ADDED BLDG 2

00 SITE WIDE
FIRE ALARM LOOPS
SOUTH SECTION

UNIVERSITY OF CALIFORNIA LAWRENCE BERKELEY LABORATORY
FACILITIES DEPARTMENT

DRAWN BY	HW	DATE 03/08/84
CHECKED BY	RG	03/08/84
APPROVED BY	BHS	03/08/84
CAD FILE PATH		
SCALE	As Noted	
DRAWING NO.	4B00E2550	SHEET 1
PROJECT NO.	FM9210	1 OF 1