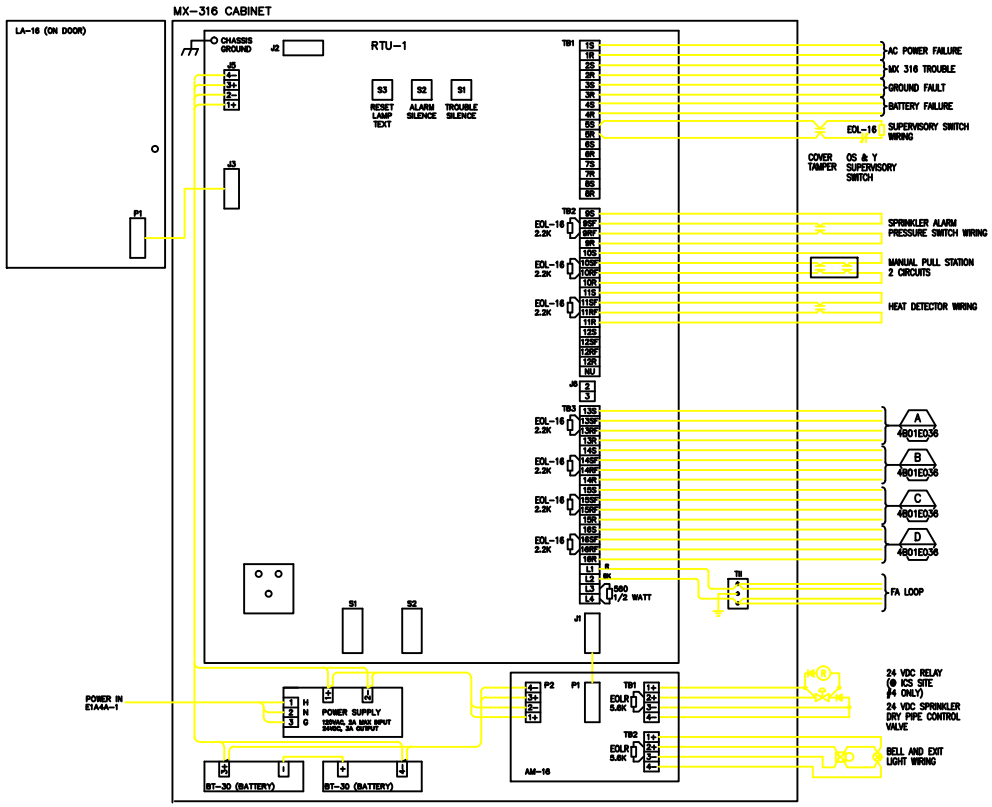

A	LM	ROB	MCG	9/19/97	CONVERTED TO AUTOCAD & AS-BUILT
REVISION	DRAWN BY	CHECKED BY	APPROVED BY	DATE	REMARKS

01 ICS NODE FIRE ALARM
MX-316 TRANSMITTER 123
WIRING DIAGRAM

UNIVERSITY OF CALIFORNIA LAWRENCE BERKELEY LABORATORY
FACILITIES DEPARTMENT

DRAWN BY	LMR	10/28/97
CHECKED BY	ROB	04/28/97
APPROVED BY	MCG	05/27/97
CAD FILE PATH	00001884	
SCALE	As Noted	
DRAWING NO.	4B01E035A	SHEET E1 1 OF 1
PROJECT NO.	1537184	