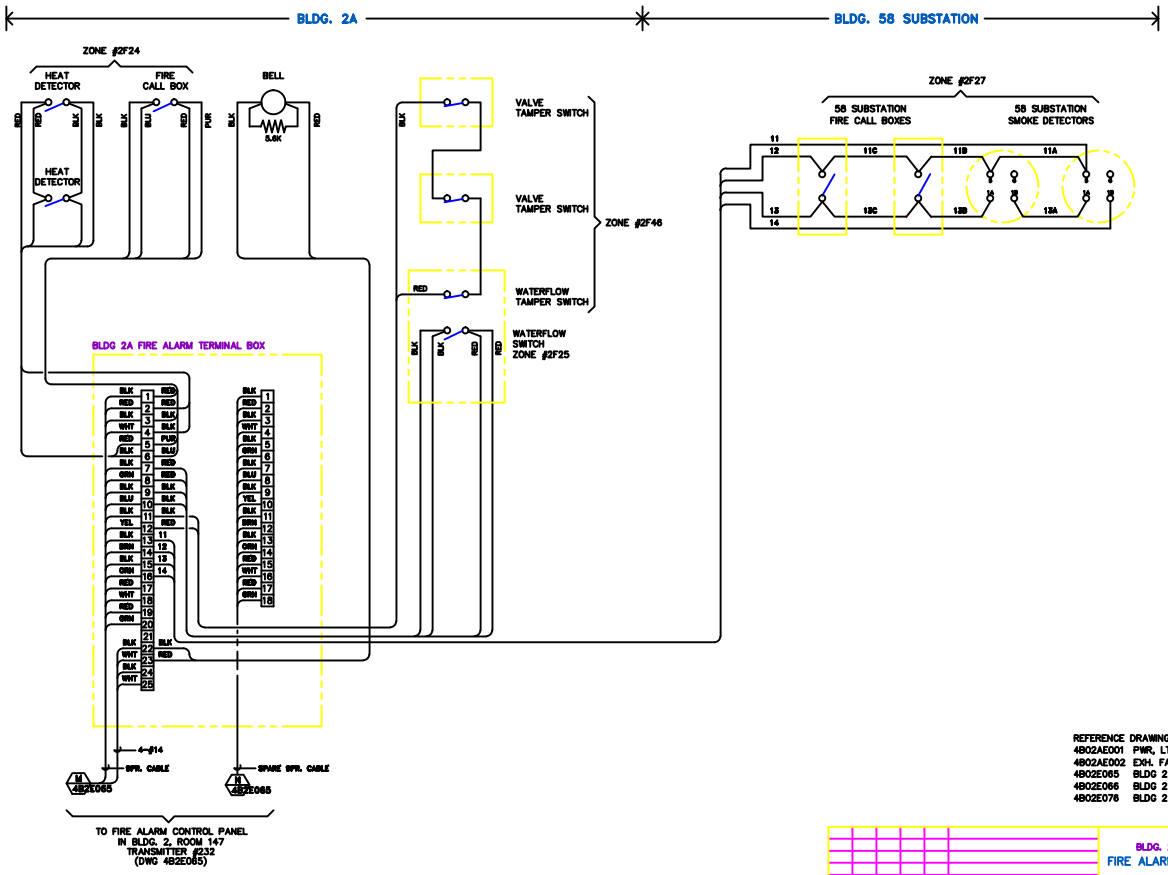

REFERENCE DRAWINGS:
4B02AE001 PWR, LTG & GRD PLAN & ELEV.
4B02AE002 EXH. FAN CONTROL & INDICATION DIAG. & ONE LINE DIAG.
4B02E065 BLDG 2 SYS 3 WIRING PANEL FAP-01B-002
4B02E066 BLDG 2 SYS 3 WIRING PANEL FAP-01A-002
4B02E076 BLDG 2 SYS 3 WIRING PANEL FAP-01B-002 SR-33 & PM-32 WIRING

PROJ. NO. 000000

LETTER	DRAWN BY	CHECKED BY	APPR'D BY	DATE	REVISIONS
B	LDD	LDD	MG	2.1.05	AS BUILT
A	LDD	LDD	MG	1.11.05	ADDED 58 SUBSTATION FA CIRCUITS

AUTOCAD FILE NO.:

BLDG. 2A AND BLDG. 58 SUBSTATION
FIRE ALARM INTERCONNECTION DIAGRAM

UNIVERSITY OF CALIFORNIA LAWRENCE BERKELEY LABORATORY
FACILITIES DEPARTMENT

DRAWN BY	L. DOMANSKY	DATE 8/17/94
CHECKED BY	L. DOMANSKY	8/17/94
APPROVED BY	R. BAKER	8/17/94
SCALE	NONE	SHEET E3
DRAWING NO.	4B02AE003B	OF 3