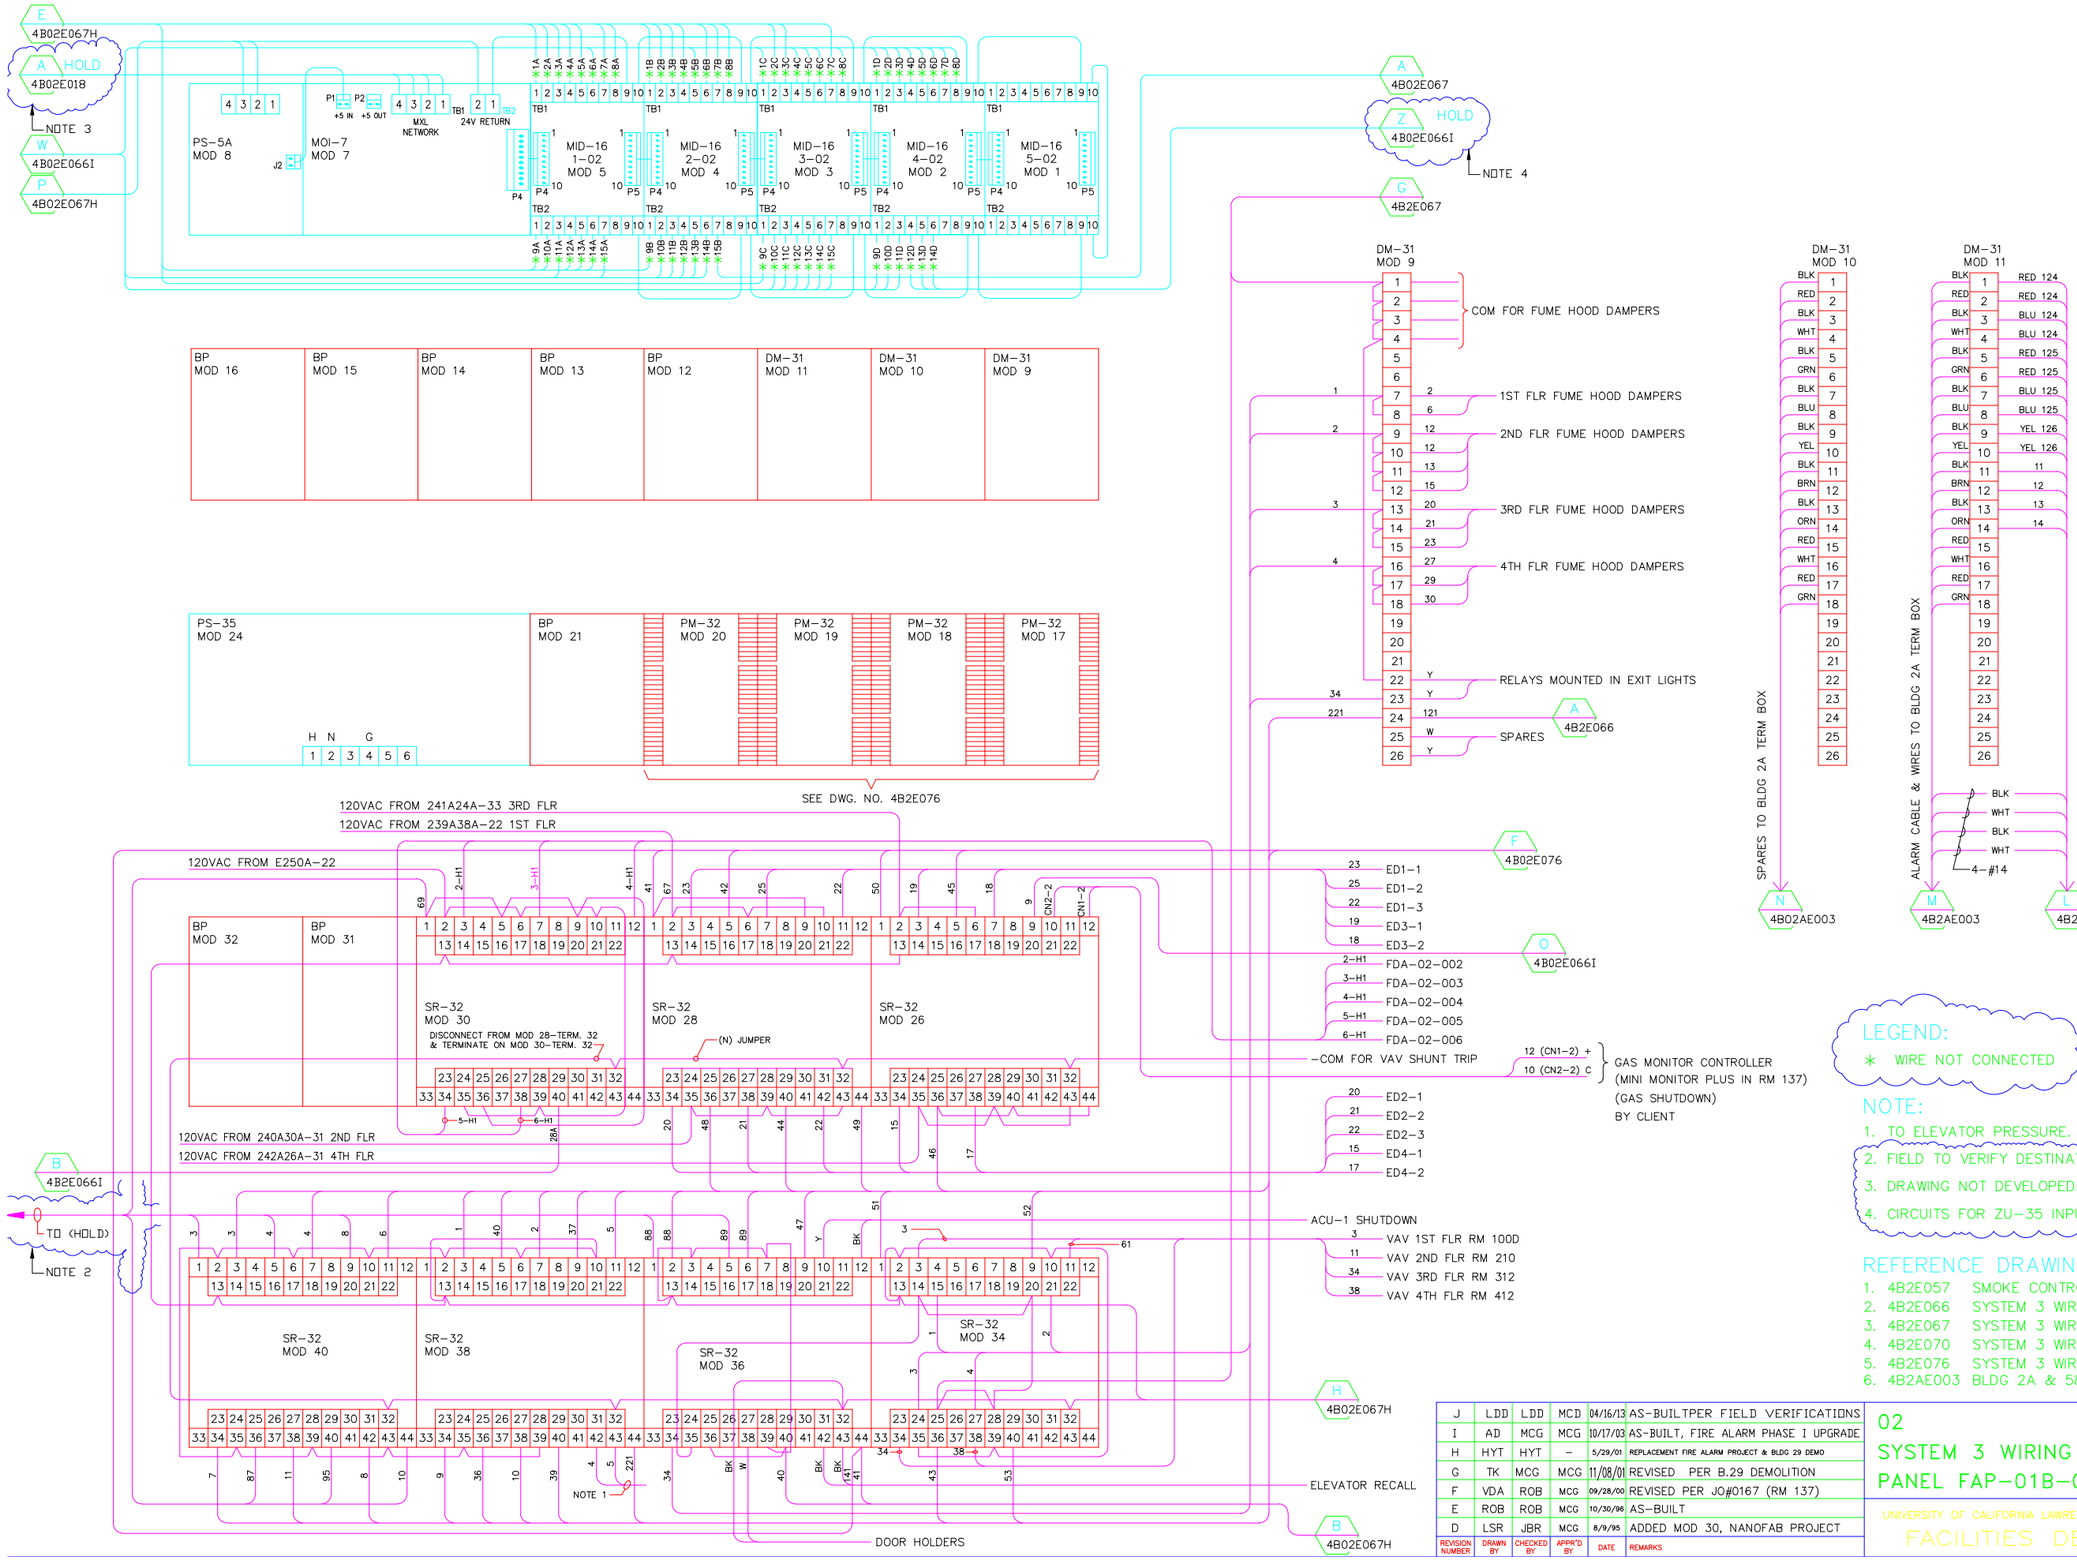

LEGEND:

* WIRE NOT CONNECTED

NOTE:

1. TO ELEVATOR PRESSURE. SEE DRAWING 4B02E077.
2. FIELD TO VERIFY DESTINATION AND TERMINATION.
3. DRAWING NOT DEVELOPED.
4. CIRCUITS FOR ZU-35 INPUT MODULES NOT DESIGNED.

REFERENCE DRAWINGS

1. 4B2E057 SMOKE CONTROL MATRIX
2. 4B2E066 SYSTEM 3 WIRING PANEL FAP-01A-002
3. 4B2E067 SYSTEM 3 WIRING PANEL FAP-01-002
4. 4B2E070 SYSTEM 3 WIRING ROOM 147 PLAN & ELEVATION
5. 4B2E076 SYSTEM 3 WIRING PANEL FAP-01B-002 SR-33 & PM-32 WIRING
6. 4B2AE003 BLDG 2A & 58 SUB INTERCONNECTION WRG DIAG.

REVISION NUMBER	DRAWN BY	CHECKED BY	APPR'D BY	DATE	REMARKS
J	LDD	LDD	MCD	04/16/13	AS-BUILTPER FIELD VERIFICATIONS
I	AD	MCG	MCG	10/17/03	AS-BUILT, FIRE ALARM PHASE I UPGRADE
H	HYT	HYT	–	5/29/01	REPLACEMENT FIRE ALARM PROJECT & BLDG 29 DEMO
G	TK	MCG	MCG	11/08/01	REVISED PER B.29 DEMOLITION
F	VDA	ROB	MCG	09/28/00	REVISED PER JO#0167 (RM 137)
E	ROB	ROB	MCG	10/30/96	AS-BUILT
D	LSR	JBR	MCG	6/9/95	ADDED MOD 30, NANOFAB PROJECT

02

SYSTEM 3 WIRING

PANEL FAP-01B-002

UNIVERSITY OF CALIFORNIA LAWRENCE BERKELEY LABORATORY

FACILITIES DEPARTMENT

DRAWN BY	LSR	DATE 11/11/2
CHECKED BY	JH	11/11/1
APPROVED BY	ROB	11/16/1
CAD FILE PATH		
SCALE	As Noted	
DRAWING NO.	4B02E065J	SHEET
PROJECT NO.	W96832	1 OF 1