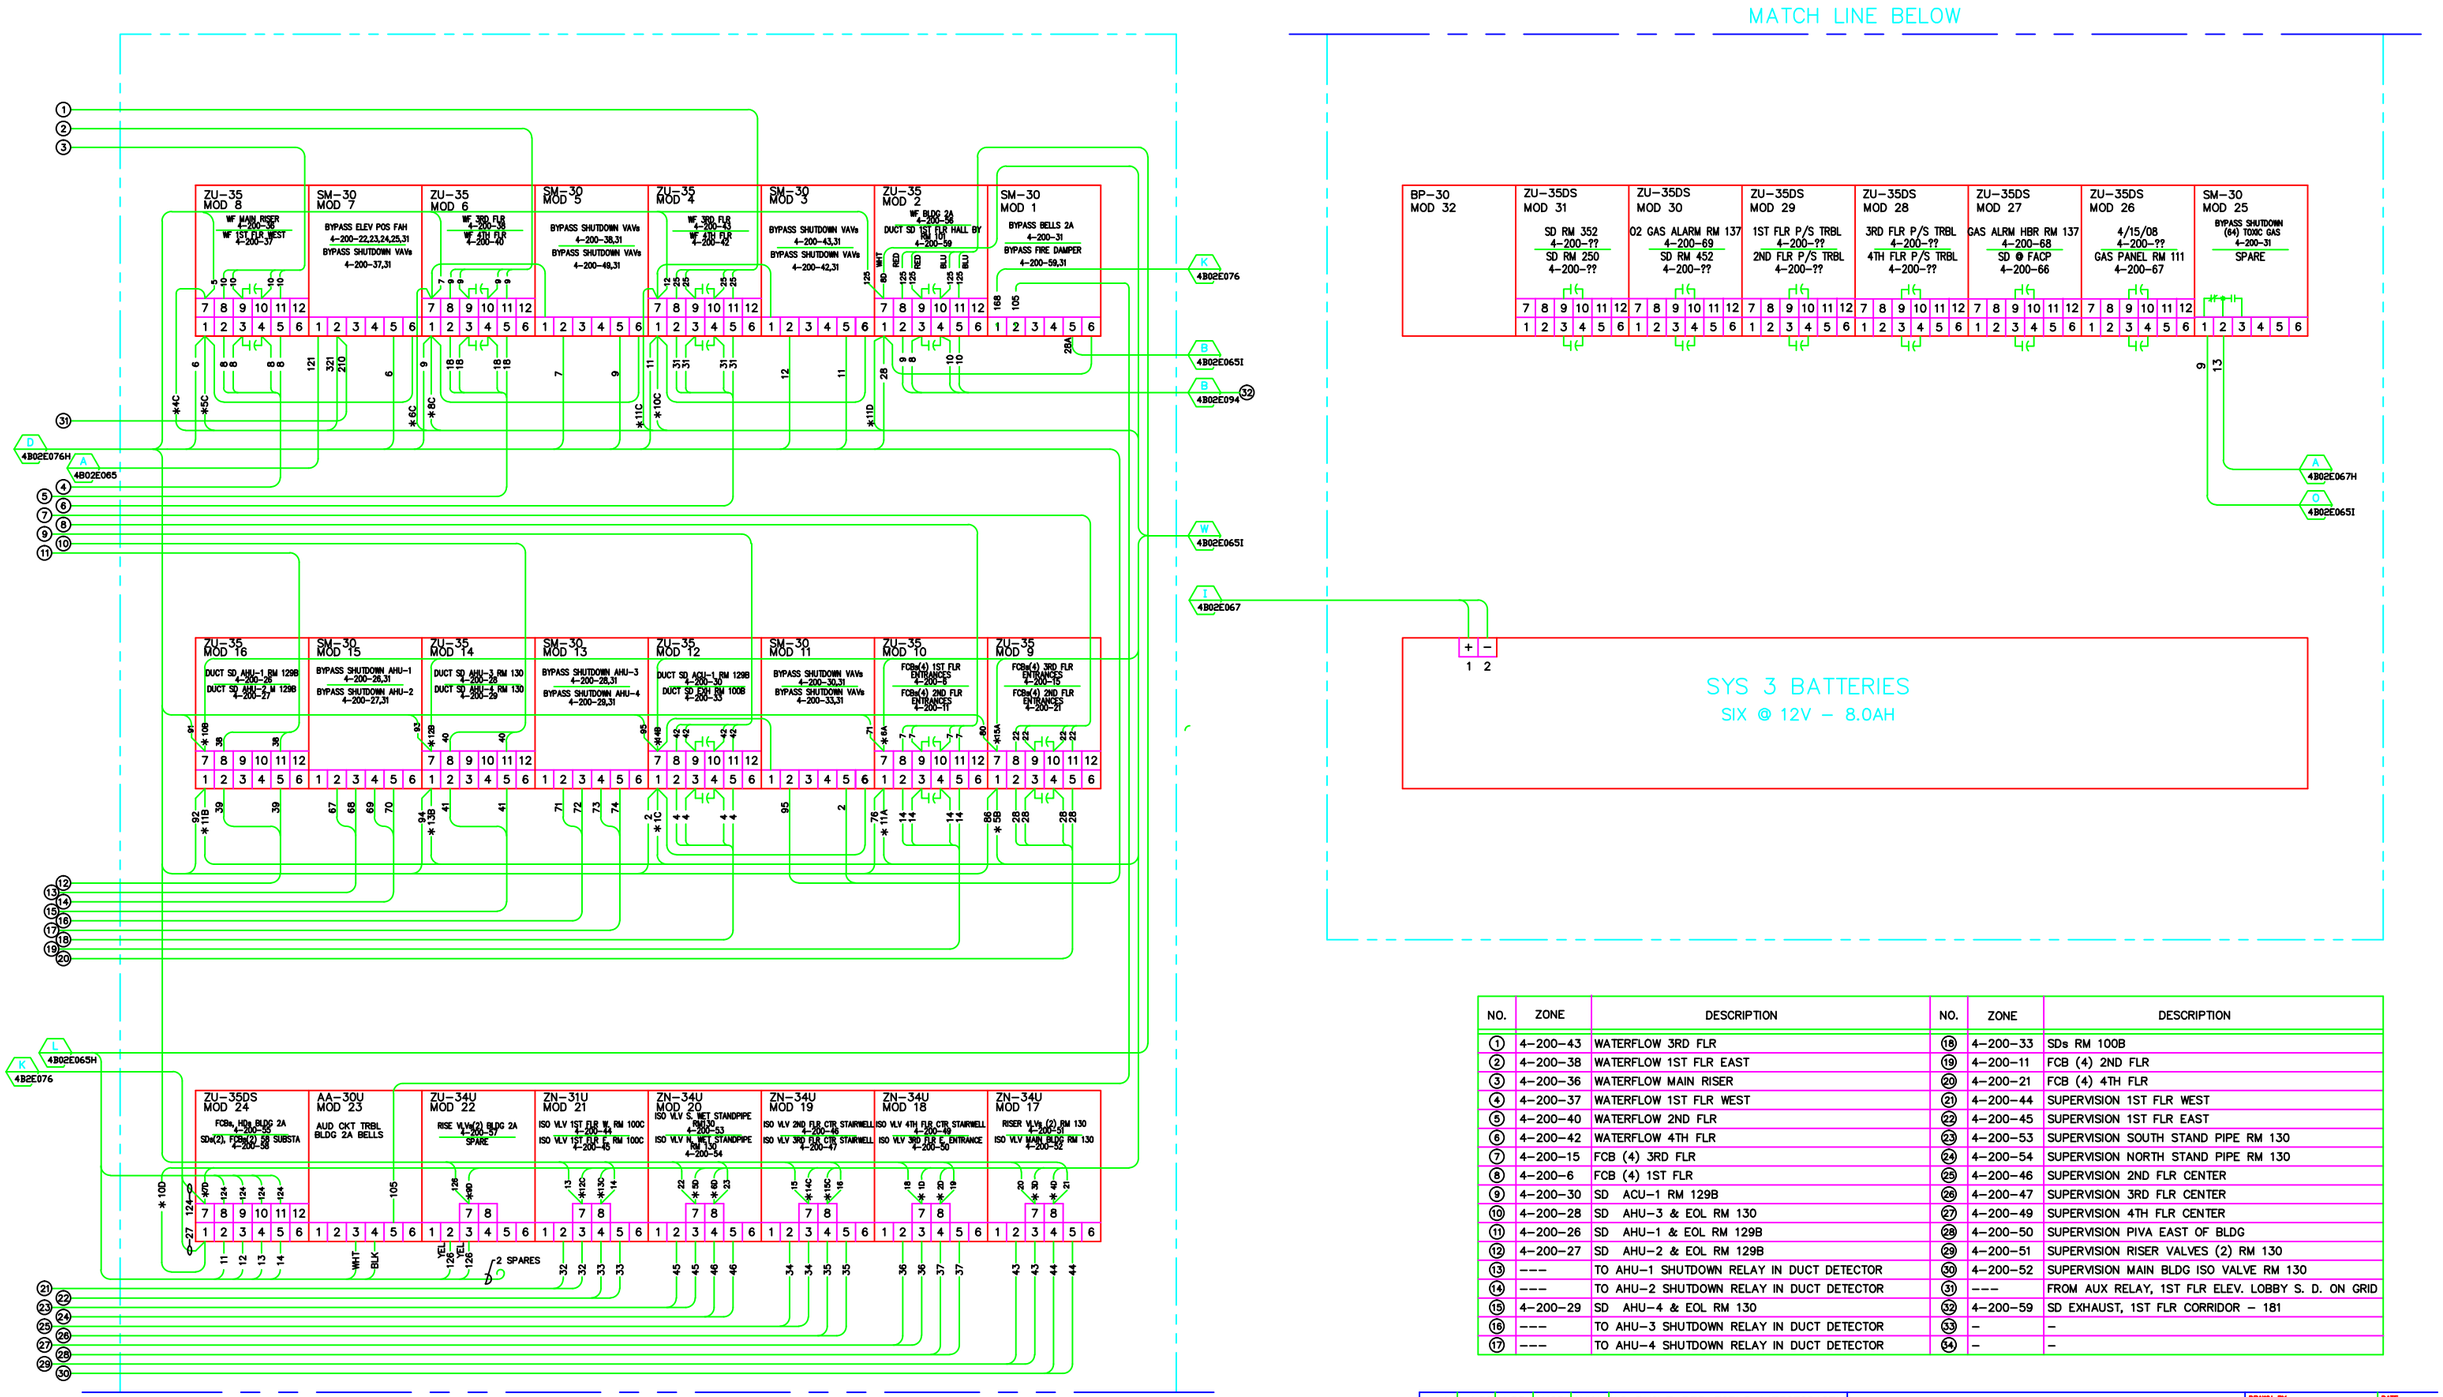

NO.	ZONE	DESCRIPTION	NO.	ZONE	DESCRIPTION
1	4-200-43	WATERFLOW 3RD FLR	18	4-200-33	SDs RM 100B
2	4-200-38	WATERFLOW 1ST FLR EAST	19	4-200-11	FCB (4) 2ND FLR
3	4-200-36	WATERFLOW MAIN RISER	20	4-200-21	FCB (4) 4TH FLR
4	4-200-37	WATERFLOW 1ST FLR WEST	21	4-200-44	SUPERVISION 1ST FLR WEST
5	4-200-40	WATERFLOW 2ND FLR	22	4-200-45	SUPERVISION 1ST FLR EAST
6	4-200-42	WATERFLOW 4TH FLR	23	4-200-53	SUPERVISION SOUTH STAND PIPE RM 130
7	4-200-15	FCB (4) 3RD FLR	24	4-200-54	SUPERVISION NORTH STAND PIPE RM 130
8	4-200-6	FCB (4) 1ST FLR	25	4-200-46	SUPERVISION 2ND FLR CENTER
9	4-200-30	SD ACU-1 RM 129B	26	4-200-47	SUPERVISION 3RD FLR CENTER
10	4-200-28	SD AHU-3 & EOL RM 130	27	4-200-49	SUPERVISION 4TH FLR CENTER
11	4-200-26	SD AHU-1 & EOL RM 129B	28	4-200-50	SUPERVISION PIVA EAST OF BLDG
12	4-200-27	SD AHU-2 & EOL RM 129B	29	4-200-51	SUPERVISION RISER VALVES (2) RM 130
13	---	TO AHU-1 SHUTDOWN RELAY IN DUCT DETECTOR	30	4-200-52	SUPERVISION MAIN BLDG ISO VALVE RM 130
14	---	TO AHU-2 SHUTDOWN RELAY IN DUCT DETECTOR	31	---	FROM AUX RELAY, 1ST FLR ELEV. LOBBY S. D. ON GRID
15	4-200-29	SD AHU-4 & EOL RM 130	32	4-200-59	SD EXHAUST, 1ST FLR CORRIDOR – 181
16	---	TO AHU-3 SHUTDOWN RELAY IN DUCT DETECTOR	33	–	–
17	---	TO AHU-4 SHUTDOWN RELAY IN DUCT DETECTOR	34	–	–

LEGEND:

* WIRE NOT CONNECTED

REFERENCE DRAWINGS

1. 4B2E057 SMOKE CONTROL MATRIX
2. 4B2E065 SYSTEM 3 WIRING PANEL FAP-01-002
3. 4B2E067 SYSTEM 3 WIRING PANEL FAP-1B-002
4. 4B2E070 SYSTEM 3 WIRING ROOM 147 PLAN & ELEVATION
5. 4B2E076 SYSTEM 3 WIRING PANEL FAP-1B-002 SR-33 & PM-32 WIRING
6. 4B2AE003 BLDG 2A & 58 SUB INTERCONNECTION WRG DIAG

REVISION NUMBER	DRAWN BY	CHECKED BY	APPV'D BY	DATE	REMARKS
J	LDD	LDD	MCD	04/16/13	AS-BUILT PER FIELD VERIFICAION
I	AD	MCG	MCG	10/17/03	AS-BUILT, FIRE ALARM PHASE I UPGRADE
H	HYT	HYT	–	–	REPLACEMENT FIRE ALARM PROJECT & BLDG 29 DEMO
G	TK	MCG	MCG	11/08/01	REVISED PER BLDG 29 DEMOLITION
F	VDA	ROB	MCG	09/28/00	REVISED PER JO#FD0167 (RM137)
E	ROB	ROB	MCG	10/30/96	AS-BUILT
D	LSR	JBR	MCG	8/9/95	CIRCUITS ADDED, NANOFAB PROJECT

02
SYSTEM 3 WIRING
PANEL FAP-01A-002

UNIVERSITY OF CALIFORNIA LAWRENCE BERKELEY LABORATORY
FACILITIES DEPARTMENT

		DATE
DRAWN BY	LSR	11/4/19
CHECKED BY	JH	11/11/1
APPROVED BY	ROB	11/16/1
CAD FILE PATH		
SCALE	As Noted	
DRAWING NO.	4B02E066J	SHEET 1 OF 1
PROJECT NO.	W96832	