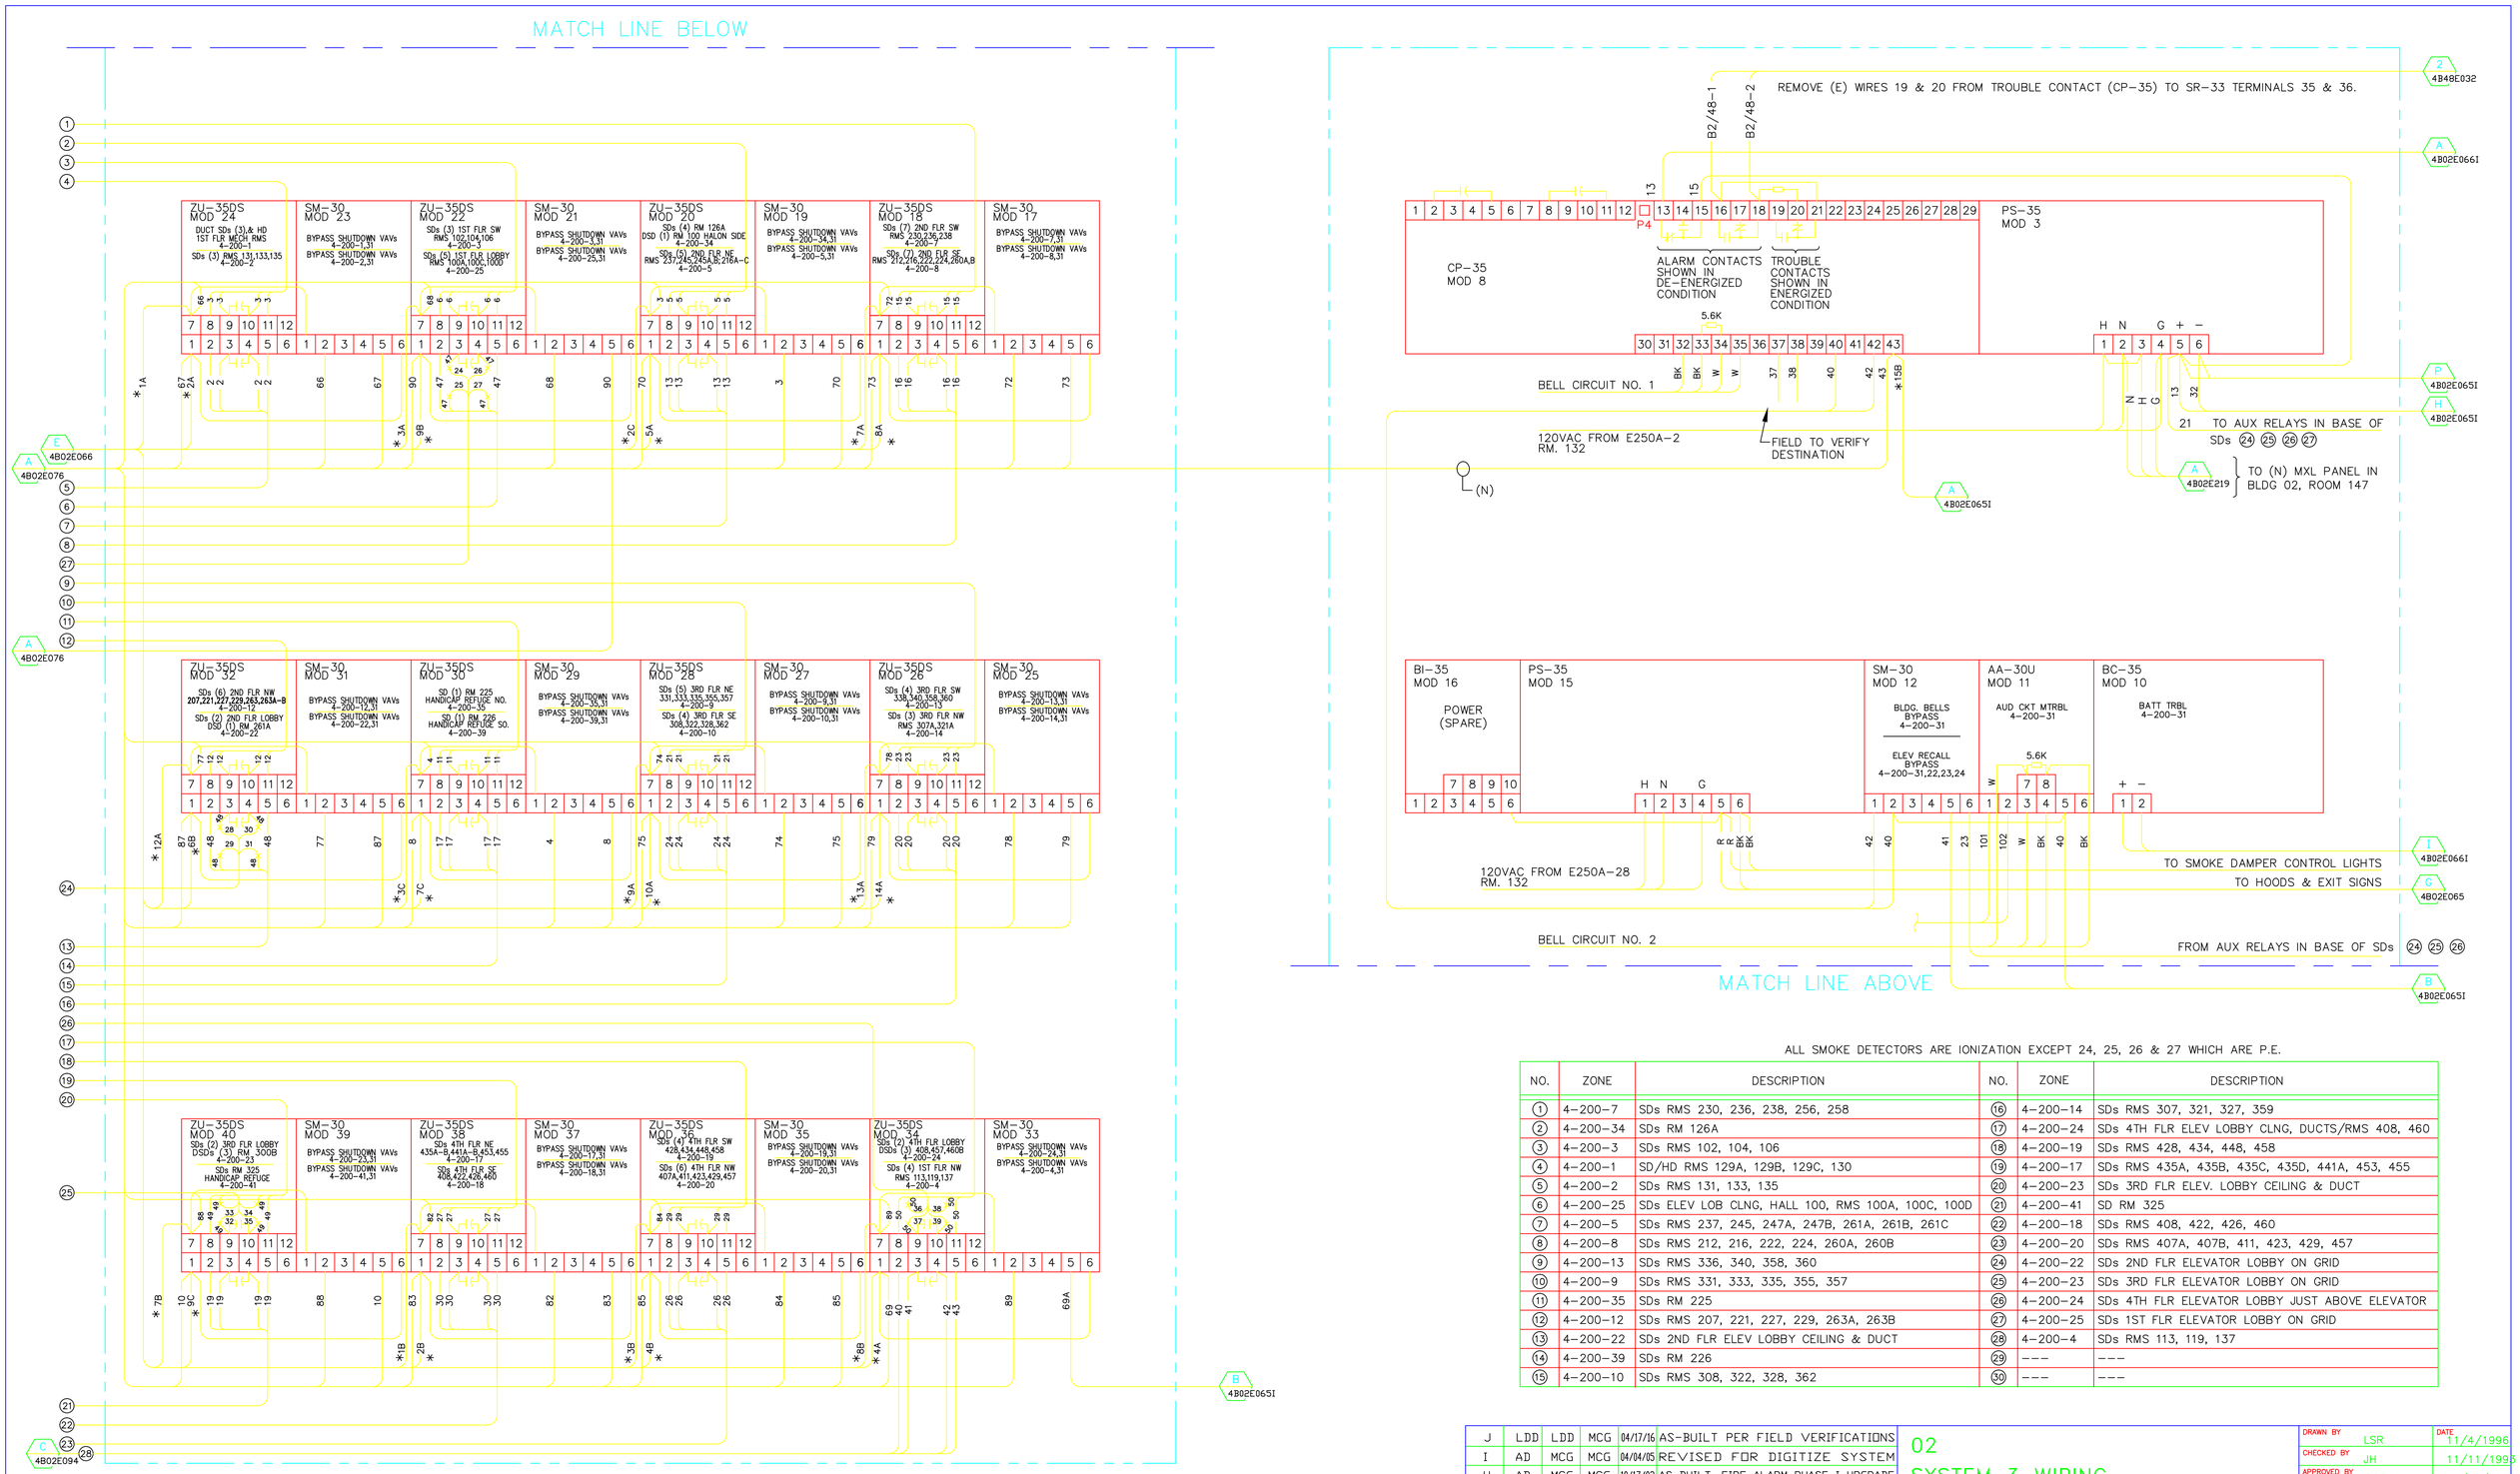

ALL SMOKE DETECTORS ARE IONIZATION EXCEPT 24, 25, 26 & 27 WHICH ARE P.E.

NO.	ZONE	DESCRIPTION	NO.	ZONE	DESCRIPTION
1	4-200-7	SDs RMS 230, 236, 238, 256, 258	16	4-200-14	SDs RMS 307, 321, 327, 359
2	4-200-34	SDs RM 126A	17	4-200-24	SDs 4TH FLR ELEV LOBBY CLNG, DUCTS/RMS 408, 460
3	4-200-3	SDs RMS 102, 104, 106	18	4-200-19	SDs RMS 428, 434, 448, 458
4	4-200-1	SD/HD RMS 129A, 129B, 129C, 130	19	4-200-17	SDs RMS 435A, 435B, 435C, 435D, 441A, 453, 455
5	4-200-2	SDs RMS 131, 133, 135	20	4-200-23	SDs 3RD FLR ELEV. LOBBY CEILING & DUCT
6	4-200-25	SDs ELEV LOB CLNG, HALL 100, RMS 100A, 100C, 100D	21	4-200-41	SD RM 325
7	4-200-5	SDs RMS 237, 245, 247A, 247B, 261A, 261B, 261C	22	4-200-18	SDs RMS 408, 422, 426, 460
8	4-200-8	SDs RMS 212, 216, 222, 224, 260A, 260B	23	4-200-20	SDs RMS 407A, 407B, 411, 423, 429, 457
9	4-200-13	SDs RMS 336, 340, 358, 360	24	4-200-22	SDs 2ND FLR ELEVATOR LOBBY ON GRID
10	4-200-9	SDs RMS 331, 333, 335, 355, 357	25	4-200-23	SDs 3RD FLR ELEVATOR LOBBY ON GRID
11	4-200-35	SDs RM 225	26	4-200-24	SDs 4TH FLR ELEVATOR LOBBY JUST ABOVE ELEVATOR
12	4-200-12	SDs RMS 207, 221, 227, 229, 263A, 263B	27	4-200-25	SDs 1ST FLR ELEVATOR LOBBY ON GRID
13	4-200-22	SDs 2ND FLR ELEV LOBBY CEILING & DUCT	28	4-200-4	SDs RMS 113, 119, 137
14	4-200-39	SDs RM 226	29	---	---
15	4-200-10	SDs RMS 308, 322, 328, 362	30	---	---

REFERENCE DRAWINGS

1. 4B2E057 SMOKE CONTROL MATRIX
2. 4B2E065 SYSTEM 3 WIRING PANEL FAP-01B-002
3. 4B2E066 SYSTEM 3 WIRING PANEL FAP-1A-002
4. 4B2E070 SYSTEM 3 WIRING ROOM 147 PLAN & ELEVATION
5. 4B2E076 SYSTEM 3 WIRING PANEL FAP-01B-002 SR-33 & PM-32 WIRING

LEGEND:

* WIRE NOT CONNECTED

REVISION NUMBER	DRAWN BY	CHECKED BY	APPR'D BY	DATE	REMARKS
J	LDD	LDD	MCG	04/17/16	AS-BUILT PER FIELD VERIFICATIONS
I	AD	MCG	MCG	04/04/05	REVISED FOR DIGITIZE SYSTEM
H	AD	MCG	MCG	10/17/03	AS-BUILT, FIRE ALARM PHASE I UPGRADE
G	HYT	HYT	-	-	REPLACEMENT FIRE ALARM PROJECT & B. 29 DEMO
F	TK	MCG	MCG	11/08/01	REVISED PER BLDG 29 DEMOLITION
E	VDA	ROB	MCG	09/28/00	REVISED PER JO#FD0167 (Rm137)
D	ROB	ROB	MCG	10/30/96	AS-BUILT

02
SYSTEM 3 WIRING
PANEL FAP-01-002

UNIVERSITY OF CALIFORNIA LAWRENCE BERKELEY LABORATORY
FACILITIES DEPARTMENT

DRAWN BY	LSR	DATE 11/4/1996
CHECKED BY	JH	11/11/1996
APPROVED BY	ROB	11/16/1996
CAD FILE PATH		
SCALE	As Noted	
DRAWING NO.	4B02E067J	SHEET
PROJECT NO.	W96832	1 OF 1