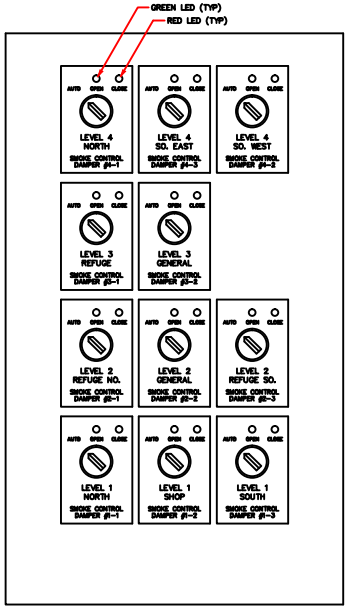

DAMPER CONTROL PANEL

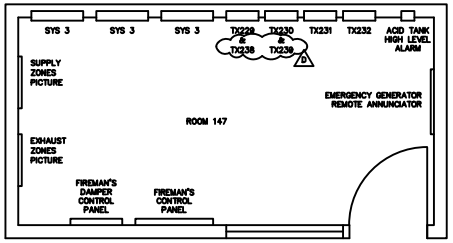

ROOM 147 PLAN

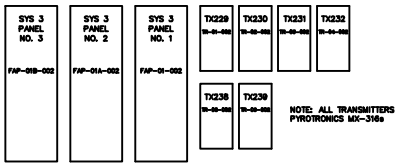

ROOM 147 PANEL ELEVATION

REFERENCE DRAWINGS

1. 4B2E057 SMOKE CONTROL MATRIX
2. 4B2E065 SYSTEM 3 WIRING PANEL FAP-01B-002
3. 4B2E066 SYSTEM 3 WIRING PANEL FAP-01A-002
4. 4B2E067 SYSTEM 3 WIRING PANEL FAP-01-002
5. 4B2E076 SYSTEM 3 WIRING PANEL FAP-01B-002 SR-33 & PM-32 WIRING

REVISION NUMBER	DRAWN BY	DESIGNED BY	CHECKED BY	APPROVED BY	DATE	REMARKS
D	RB	MG	MG	11/17/93		AS-BUILT- ADD XMTRS 238 & 239
C	RB	BHS	BHS	9/8/93		REMOVE ELEVATOR PRESSURE CONTROL
B	RB	BHS	BHS	10/25/93		ADD ELEVATOR PRESSURE CONTROL
A	LSR	JEH	RBaker	11/15/93		AS-BUILT

BLDG. 2 FIRE ALARM SYSTEM
SYSTEM 3 WIRING
ROOM 147 PLAN & ELEVATION

UNIVERSITY OF CALIFORNIA LAWRENCE BERKELEY LABORATORY
FACILITIES DEPARTMENT

DRAWN BY	L. Reibeck	DATE 11-11-93
DESIGNED BY	J. Hutchings	11-11-93
APPROVED BY	R. Baker	11-18-93
CAD FILE NO.	ELECT-SEC\FIREALRM	
SCALE	NONE	
DRAWING NO.	4B02E070D	SHEET
PROJECT NO.	000000	