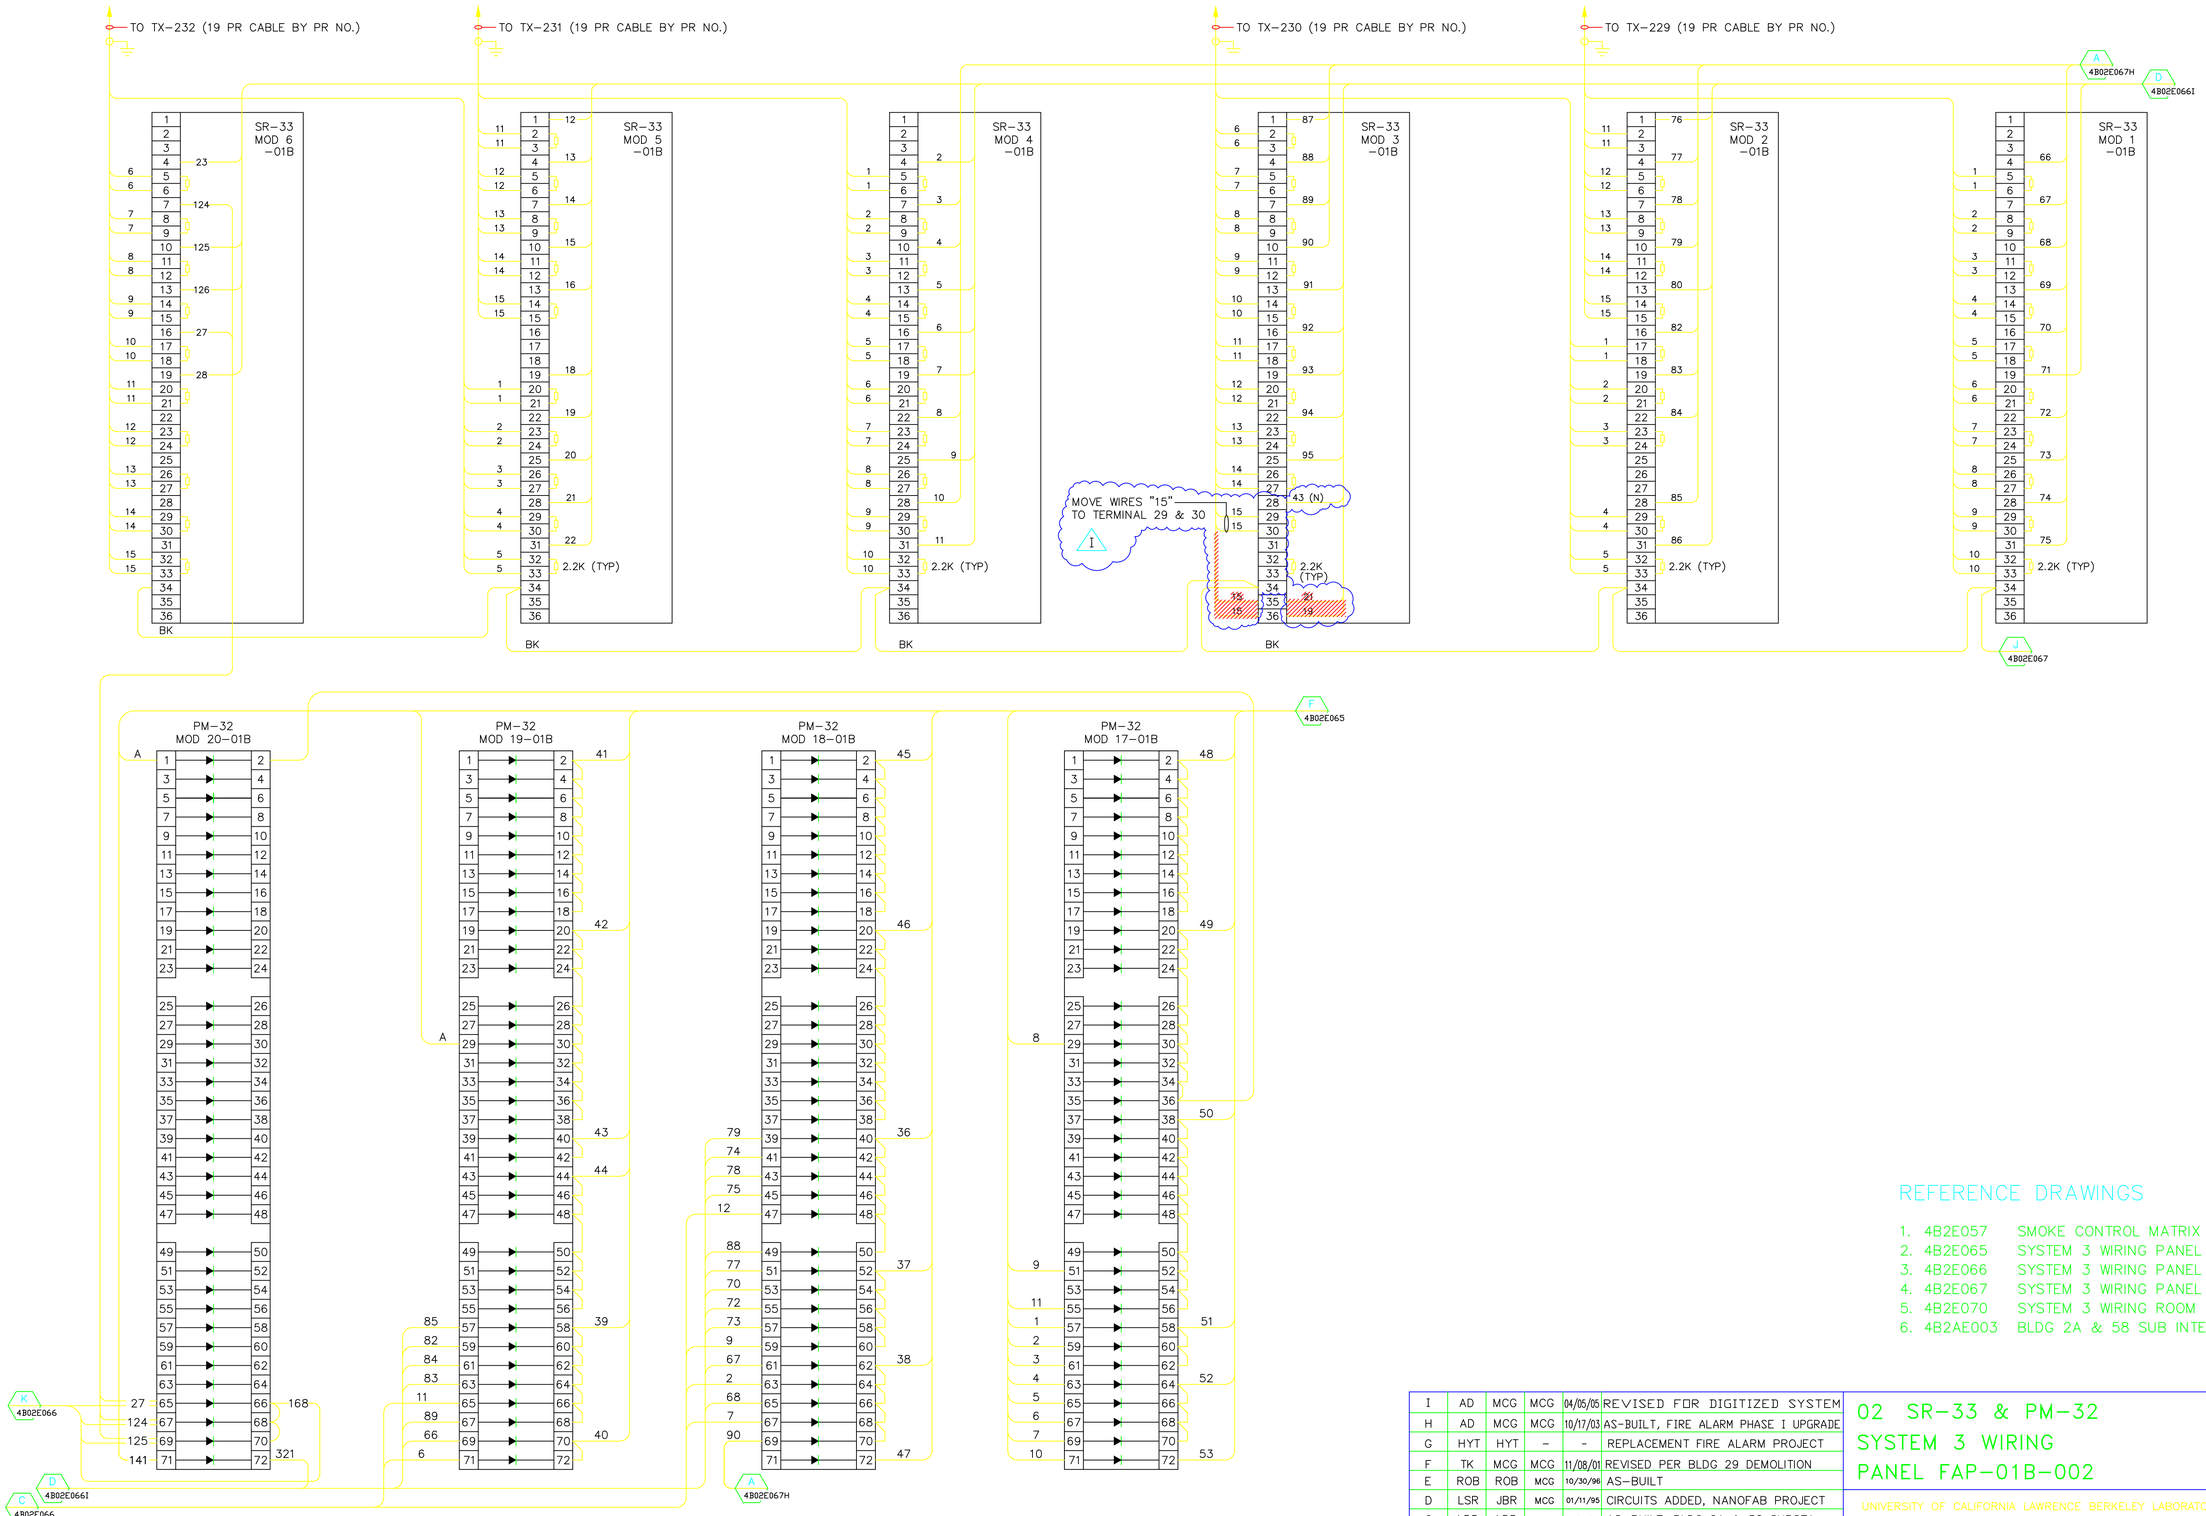

19 PR CABLE

PAIR NO.	COLOR COMBINATION
1.	BLK & RED
2.	BLK & WHT
3.	BLK & GRN
4.	BLK & BLU
5.	BLK & YEL
6.	BLK & BRN
7.	BLK & ORG
8.	RED & WHT
9.	RED & GRN
10.	RED & BLU
11.	RED & YEL
12.	RED & BRN
13.	RED & ORG
14.	GRN & WHT
15.	GRN & BLU
16.	GRN & YEL
17.	GRN & BRN
18.	GRN & ORG
19.	WHT & BLU

REFERENCE DRAWINGS

1. 4B2E057 SMOKE CONTROL MATRIX
2. 4B2E065 SYSTEM 3 WIRING PANEL FAP-01B-002
3. 4B2E066 SYSTEM 3 WIRING PANEL FAP-01A-002
4. 4B2E067 SYSTEM 3 WIRING PANEL FAP-01-002
5. 4B2E070 SYSTEM 3 WIRING ROOM 147 PLAN & ELEVATION
6. 4B2AE003 BLDG 2A & 58 SUB INTERCONNECTION WRG DIAG

REVISION NUMBER	DRAWN BY	CHECKED BY	APPR'D BY	DATE	REMARKS
I	AD	MCG	MCG	04/05/05	REVISED FOR DIGITIZED SYSTEM
H	AD	MCG	MCG	10/17/03	AS-BUILT, FIRE ALARM PHASE I UPGRADE
G	HYT	HYT	-	-	REPLACEMENT FIRE ALARM PROJECT
F	TK	MCG	MCG	11/08/01	REVISED PER BLDG 29 DEMOLITION
E	ROB	ROB	MCG	10/30/96	AS-BUILT
D	LSR	JBR	MCG	01/11/95	CIRCUITS ADDED, NANOFAB PROJECT
C	LDD	LDD	MCG	01/11/95	AS-BUILT, BLDG 2A & 58 SUBSTA

02 SR-33 & PM-32
SYSTEM 3 WIRING
PANEL FAP-01B-002

UNIVERSITY OF CALIFORNIA LAWRENCE BERKELEY LABORATORY
FACILITIES DEPARTMENT

DRAWN BY	LSR	DATE 11/11/93
CHECKED BY	JH	11/11/93
APPROVED BY	ROB	11/16/93
CAD FILE PATH	00019176	
SCALE	Full	
DRAWING NO.	4B02E076I	SHEET
PROJECT NO.	W96832	1 OF 1