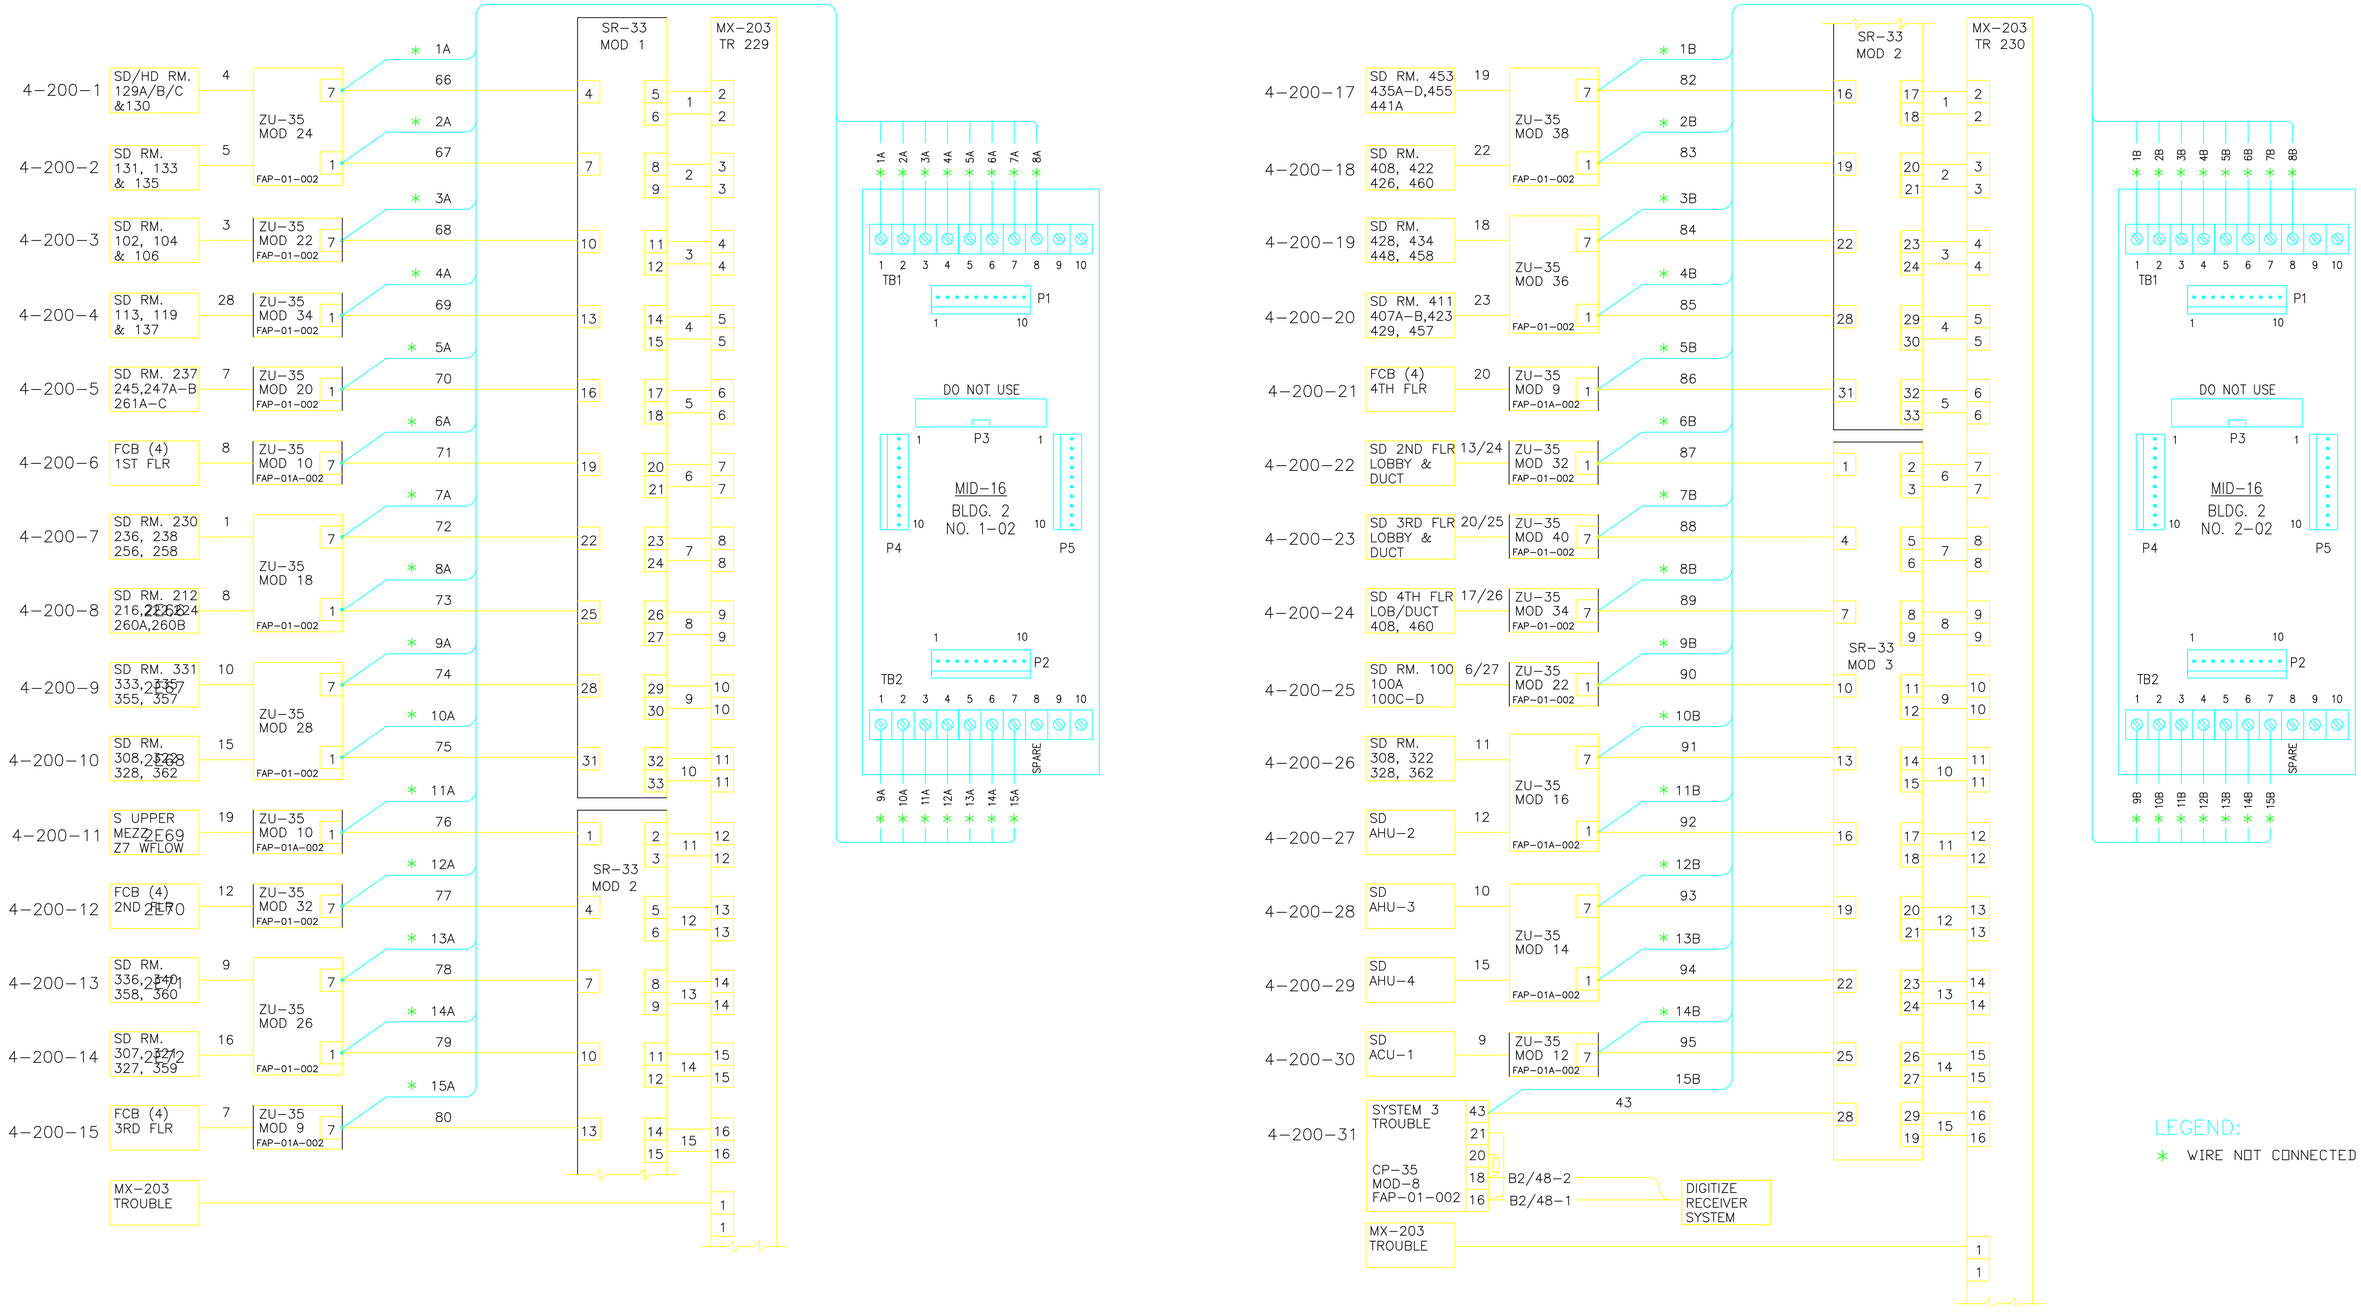

		D	LDD	LDD	MCD	04/23/13	AS BUILT PER FIELD VERIFICATIONS
		C	AD	MCG	MCG	03/31/05	REVISED FOR DIGITIZE SYSTEM
		B	AD	MCG	MCG	10/17/03	AS-BUILT, FIRE ALARM PHASE I UPGRADE
		A	HYT	HYT			FIRE ALARM PHASE I UPGRADE
PROFESSIONAL SEAL (IF REVISION, APPLIES ONLY TO REVISED WORK)	ISSUE (PROGRESS, ESTIMATE, BID, CONSTRUCTION, CONFORMED, REVISION, RECORD)	REVISION NUMBER	DRAWN BY	CHECKED BY	APPR'D BY	DATE	REMARKS

AS BUILT

D
4/23/2013

02 BLDG 2/2A

REPLACEMENT FIRE ALARM SYSTEM
FIELD DEVICE CONNECTIVITY

UNIVERSITY OF CALIFORNIA
LAWRENCE BERKELEY NATIONAL LABORATORY
FACILITIES DIVISION

DRAWN BY AD	DATE 2/14/2003	
CHECKED BY MCG	2/14/2003	
APPROVED BY MCG	2/14/2003	
CAD FILE PATH		
SCALE Full		
DRAWING NO. 4B02E163D	SHEET 1 OF 1	
PROJECT NO. 120863		