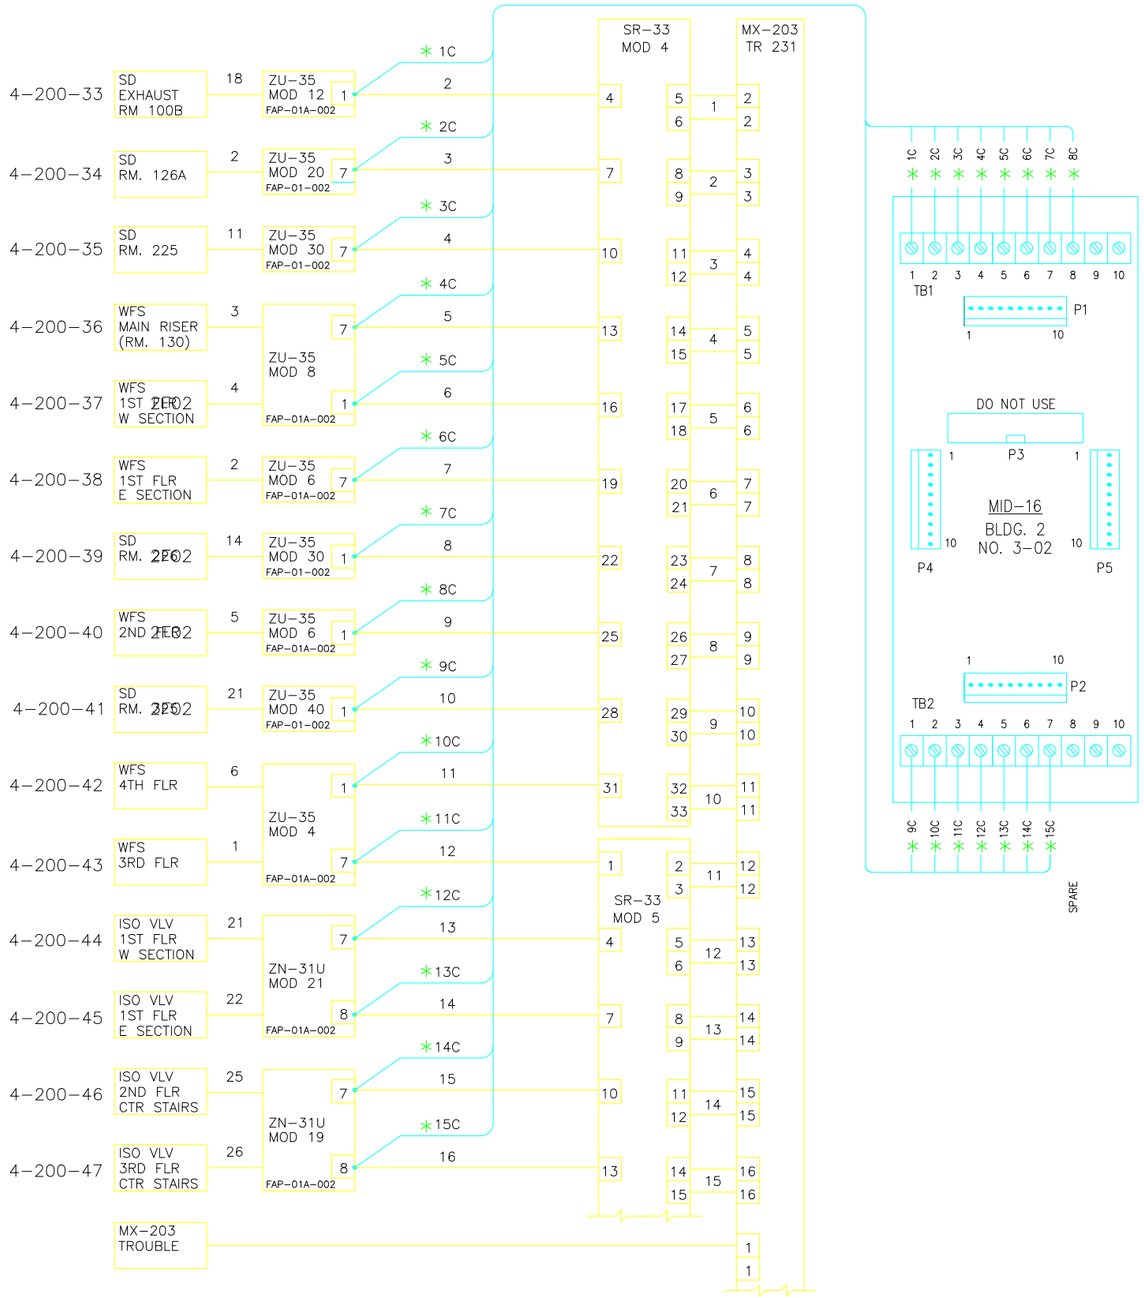

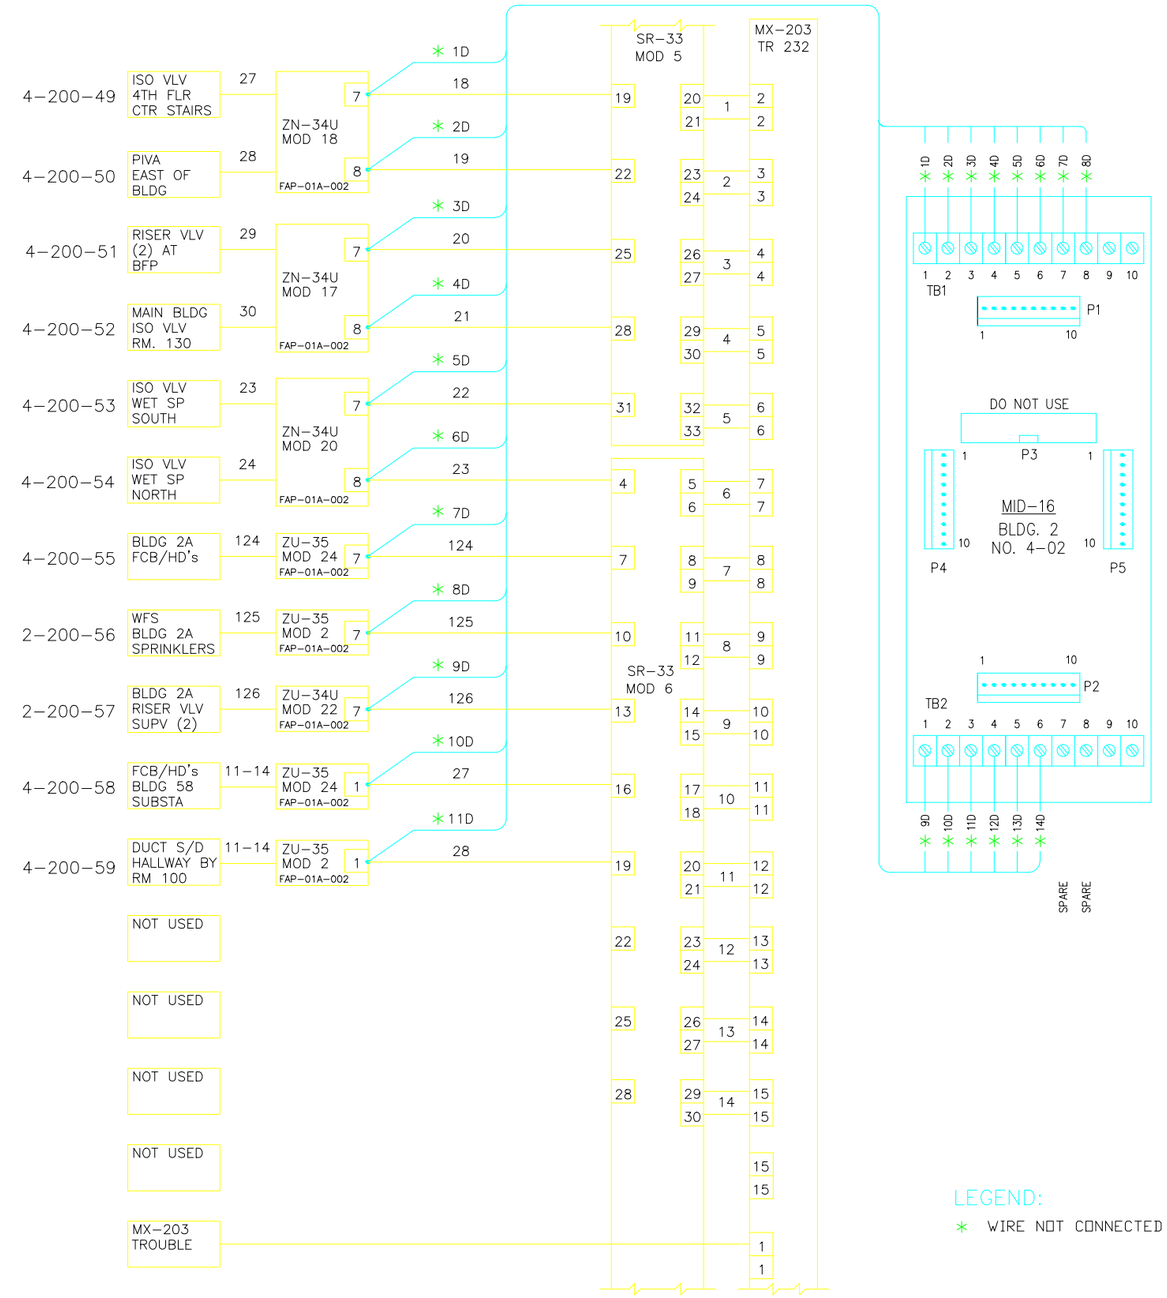

LEGEND:

* WIRE NOT CONNECTED

PROFESSIONAL SEAL (IF REVISION, APPLIES ONLY TO REVISED WORK)	ISSUE (PROGRESS, ESTIMATE, BID, CONSTRUCTION, CONFORMED, REVISION, RECORD)	REVISION NUMBER	DRAWN BY	CHECKED BY	APPR'D BY	DATE	REMARKS
	AS BUILT						
	D 4/23/2013						
		D	LDD	LDD	MCD	04/23/13	AS BUILT PER FIELD VERIFICATIONS
		C	LDD		MCD	03/27/13	AS BUILT
		B	LDD	VDA	MCD	02/23/07	REMOVE B29A, B & C – FC7009
		A	AD	MCG	MCG	10/17/03	AS-BUILT, FIRE ALARM PHASE I UPGRADE

02 BLDG 2/2A
REPLACEMENT FIRE ALARM SYSTEM
FIELD DEVICE CONNECTIVITY

UNIVERSITY OF CALIFORNIA
LAWRENCE BERKELEY NATIONAL LABORATORY
FACILITIES DIVISION

DRAWN BY AD	DATE 2/14/2003	
CHECKED BY MCG	2/14/2003	
APPROVED BY MCG	2/14/2003	
CAD FILE PATH		
SCALE Full		
DRAWING NO. 4B02E164D		SHEET 2
PROJECT NO. 120863		1 OF 1