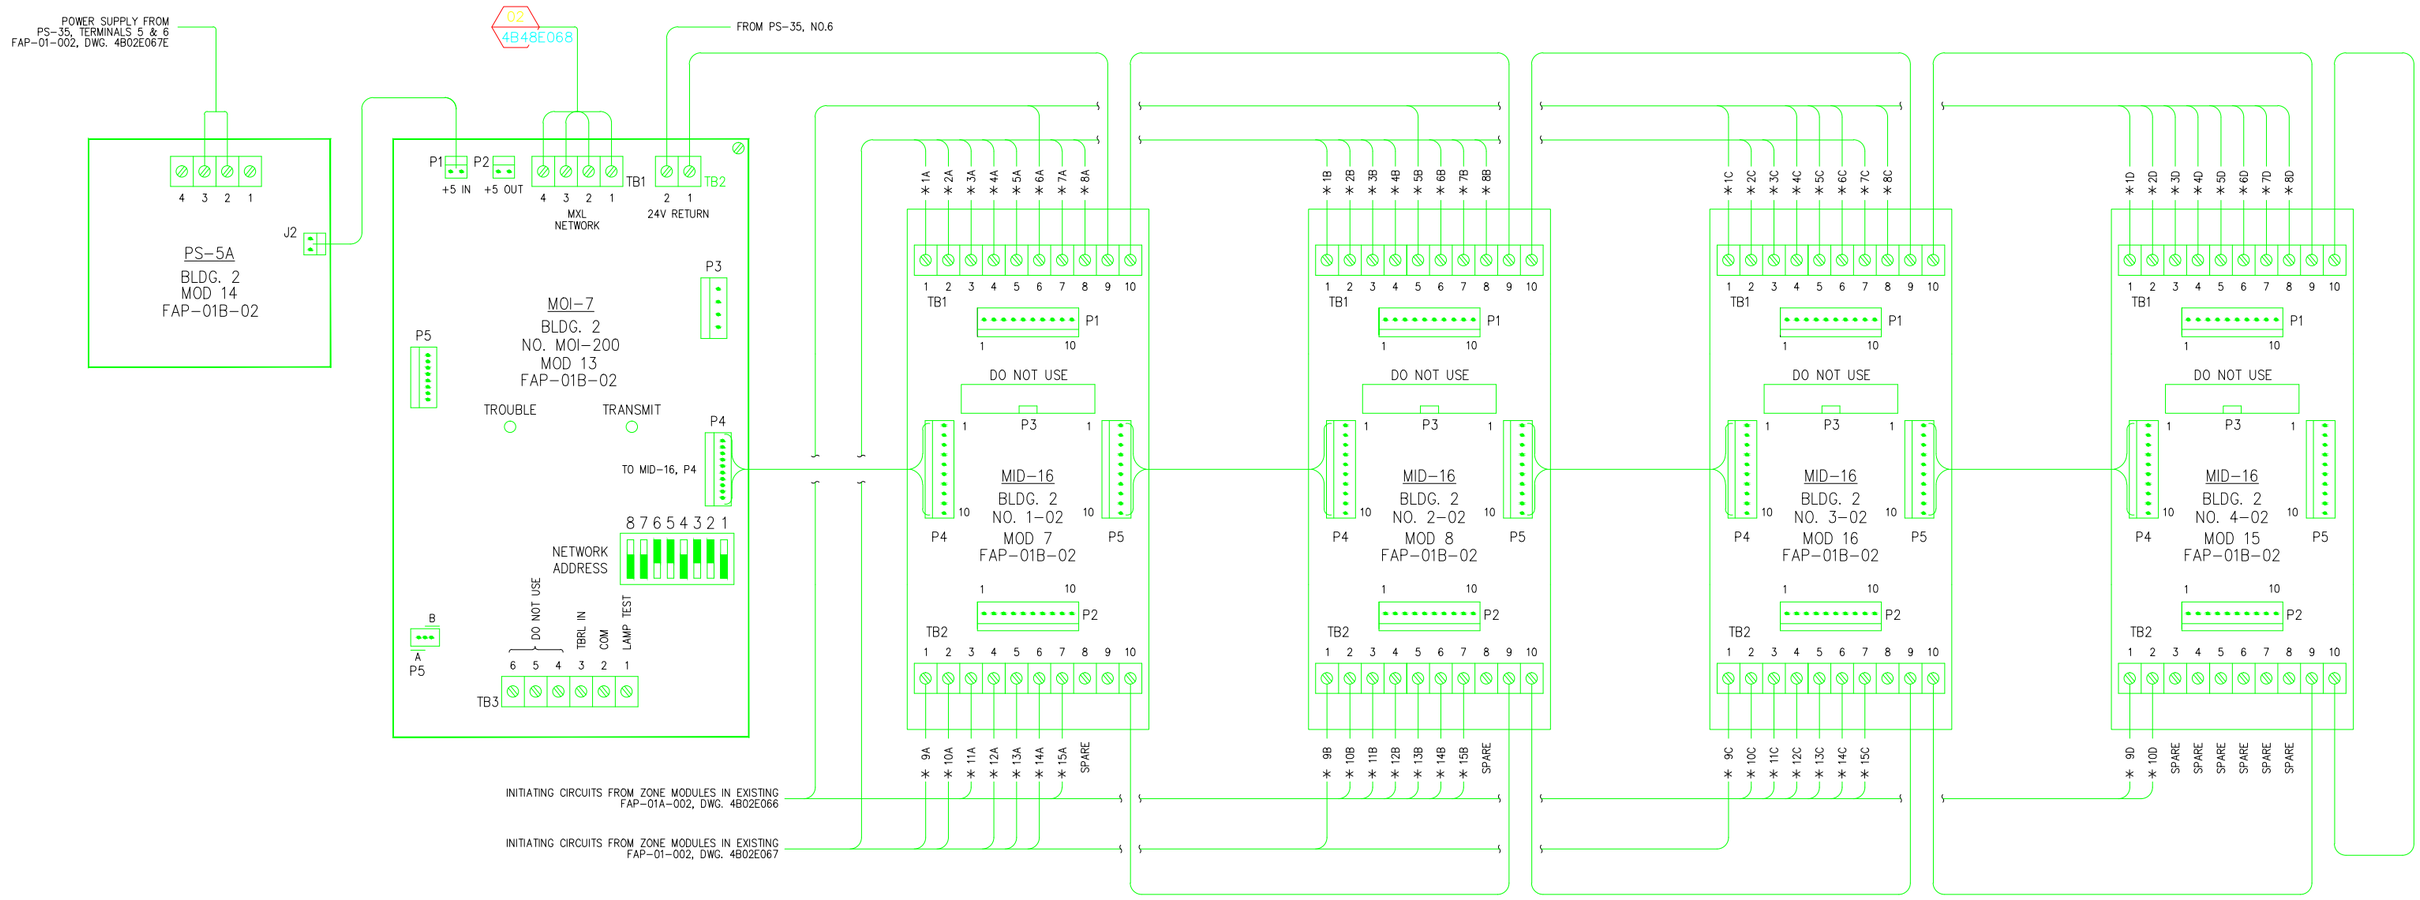

OLD ADDRESS	DESCRIPTION	MID-16 TERMINATION	MODULE TYPE & NO.	MXL NO. 04-02 ADDRESS
2E66	SD/HD/DD RM 129A-C, 130	TB. 1 NO. 1	MID-16 NO. 1-02	4-200-1
2E67	SD RM 131, 133, 135	TB. 1 NO. 2	MID-16 NO. 1-02	4-200-2
2E68	SD RM 102, 104, 106	TB. 1 NO. 3	MID-16 NO. 1-02	4-200-3
2E69	SD RM 113, 119, 137	TB. 1 NO. 4	MID-16 NO. 1-02	4-200-4
2E70	SD 237,245,247A-B,261A-C	TB. 1 NO. 5	MID-16 NO. 1-02	4-200-5
2E71	FCB (4) 1ST FLOOR	TB. 1 NO. 6	MID-16 NO. 1-02	4-200-6
2E72	SD RM 230,236,256,258	TB. 1 NO. 7	MID-16 NO. 1-02	4-200-7
2E73	SD 212,216,222,224,260A-B	TB. 1 NO. 8	MID-16 NO. 1-02	4-200-8
2E74	SD RM 331,333,335,355,357	TB. 2 NO. 1	MID-16 NO. 1-02	4-200-9
2E75	SD RM 308,322,328,362	TB. 2 NO. 2	MID-16 NO. 1-02	4-200-10
2E76	FCB (4) 2ND FLOOR	TB. 2 NO. 3	MID-16 NO. 1-02	4-200-11
2E77	SD 207,221,227,229,263A-B	TB. 2 NO. 4	MID-16 NO. 1-02	4-200-12
2E78	SD RM 336,340,358,360	TB. 2 NO. 5	MID-16 NO. 1-02	4-200-13
2E79	SD RM 307,321,327,359	TB. 2 NO. 6	MID-16 NO. 1-02	4-200-14
2E80	FCB (4) 3RD FLOOR	TB. 2 NO. 7	MID-16 NO. 1-02	4-200-15
N/A	FUTURE/SPARE	N/A	N/A	N/A

OLD ADDRESS	DESCRIPTION	MID-16 TERMINATION	MODULE TYPE & NO.	MXL NO. 04-02 ADDRESS
2E82	SD RM 435A-D,441A,453,455	TB. 1 NO. 2	MID-16 NO. 2-02	4-200-17
2E83	SD RM 408,422,426,460	TB. 1 NO. 2	MID-16 NO. 2-02	4-200-18
2E84	SD RM 428,434,448,458	TB. 1 NO. 3	MID-16 NO. 2-02	4-200-19
2E85	SD RM 407A-B,411,423,429,457	TB. 1 NO. 4	MID-16 NO. 2-02	4-200-20
2E86	FCB (4) 4TH FLOOR	TB. 1 NO. 5	MID-16 NO. 2-02	4-200-21
2E87	SD 2ND FLR LOBBY & DUCT	TB. 1 NO. 6	MID-16 NO. 2-02	4-200-22
2E88	SD 3RD FLR LOBBY & DUCT	TB. 1 NO. 7	MID-16 NO. 2-02	4-200-23
2E89	SD 4TH FLR LOB/DUCT/408/460	TB. 1 NO. 8	MID-16 NO. 2-02	4-200-24
2E90	SD RM HALL 100, 100A,100C-D	TB. 2 NO. 1	MID-16 NO. 2-02	4-200-25
2E91	SD AHU-1	TB. 2 NO. 2	MID-16 NO. 2-02	4-200-26
2E92	SD AHU-2	TB. 2 NO. 3	MID-16 NO. 2-02	4-200-27
2E93	SD AHU-3	TB. 2 NO. 4	MID-16 NO. 2-02	4-200-28
2E94	SD AHU-4	TB. 2 NO. 5	MID-16 NO. 2-02	4-200-29
2E95	SD ACU-1	TB. 2 NO. 6	MID-16 NO. 2-02	4-200-30
2E96	SYSTEM 3 TROUBLE	TB. 2 NO. 7	MID-16 NO. 2-02	4-200-31
N/A	FUTURE/SPARE	N/A	N/A	N/A

OLD ADDRESS	DESCRIPTION	MID-16 TERMINATION	MODULE TYPE & NO.	MXL NO. 04-02 ADDRESS
2F02	SD EXHAUST RM 100B	TB. 1 NO. 1	MID-16 NO. 3-02	4-200-33
2F03	SD RM. 126A	TB. 1 NO. 2	MID-16 NO. 3-02	4-200-34
2F04	SD RM. 225	TB. 1 NO. 3	MID-16 NO. 3-02	4-200-35
2F05	WFS MAIN RISER RM. 130	TB. 1 NO. 4	MID-16 NO. 3-02	4-200-36
2F06	WFS 1ST FLOOR WEST SECTION	TB. 1 NO. 5	MID-16 NO. 3-02	4-200-37
2F07	WFS 1ST FLOOR EAST SECTION	TB. 1 NO. 6	MID-16 NO. 3-02	4-200-38
2F08	SD RM. 226	TB. 1 NO. 7	MID-16 NO. 3-02	4-200-39
2F09	WFS 2ND FLOOR	TB. 1 NO. 8	MID-16 NO. 3-02	4-200-40
2F10	SD RM. 325	TB. 2 NO. 1	MID-16 NO. 3-02	4-200-41
2F11	WFS 4TH FLOOR	TB. 2 NO. 2	MID-16 NO. 3-02	4-200-42
2F12	WFS 3RD FLOOR	TB. 2 NO. 3	MID-16 NO. 3-02	4-200-43
2F13	ISO VLV 1ST FLR WEST SECT	TB. 2 NO. 4	MID-16 NO. 3-02	4-200-44
2F14	ISO VLV 1ST FLR EAST SECT	TB. 2 NO. 5	MID-16 NO. 3-02	4-200-45
2F15	ISO VLV 2ND FLR CTR STAIRS	TB. 2 NO. 6	MID-16 NO. 3-02	4-200-46
2F16	ISO VLV 3RD FLR CTR STAIRS	TB. 2 NO. 7	MID-16 NO. 3-02	4-200-47
N/A	FUTURE/SPARE	N/A	N/A	N/A

OLD ADDRESS	DESCRIPTION	MID-16 TERMINATION	MODULE TYPE & NO.	MXL NO. 04-02 ADDRESS
2F18	ISO VLV 4TH FLR CTR STAIRS	TB. 1 NO. 1	MID-16 NO. 4-02	4-200-49
2F19	SUPV PIVA EAST OF BLDG	TB. 1 NO. 2	MID-16 NO. 4-02	4-200-50
2F20	SUPV RISER VLV (2) AT BFP	TB. 1 NO. 3	MID-16 NO. 4-02	4-200-51
2F21	SUPV MAIN ISO VLV RM. 130	TB. 1 NO. 4	MID-16 NO. 4-02	4-200-52
2F22	SUPV ISO VLV WET SP NORTH	TB. 1 NO. 5	MID-16 NO. 4-02	4-200-53
2F23	SUPV ISO VLV WET SP SOUTH	TB. 1 NO. 6	MID-16 NO. 4-02	4-200-54
2F24	BLDG 2A FCB/HD	TB. 1 NO. 7	MID-16 NO. 4-02	4-200-55
2F25	WFS BLDG 2A SPRINKLERS	TB. 1 NO. 8	MID-16 NO. 4-02	4-200-56
2F26	BLDG 2A RISER ISO VLV SUPV	TB. 2 NO. 1	MID-16 NO. 4-02	4-200-57
2F27	BLDG 58 SUB STA FCB/SD	TB. 2 NO. 2	MID-16 NO. 4-02	4-200-58
2F28	DUCT DET NEAR ROOM 101	TB. 2 NO. 3	MID-16 NO. 4-02	4-200-59
2F29	FUTURE/SPARE	N/A	N/A	N/A
2F30	FUTURE/SPARE	N/A	N/A	N/A
2F31	FUTURE/SPARE	N/A	N/A	N/A
2F32	FUTURE/SPARE	N/A	N/A	N/A
N/A	FUTURE/SPARE	N/A	N/A	N/A

AS BUILT

D
4/23/2013

PROFESSIONAL SEAL (IF REVISION, APPLIES ONLY TO REVISED WORK)

ISSUE (PROGRESS, ESTIMATE, BID, CONSTRUCTION, CONFORMED, REVISION, RECORD)	REVISION NUMBER	DRAWN BY	CHECKED BY	APPR'D BY	DATE	REMARKS
	D	LDD	LDD	MCD	04/23/13	AS BUILT PER FIELD VERIFICATIONS
	C	AD	LDD	MCD	09/01/06	REVISED FOR MXL COPPER LOOP
	B	AD	MCG	MCG	04/04/05	CHANGED MXL NODE NUMBERS AND WIRING CONNECTIONS
	A	AD	MCG	MCG	10/17/03	AS-BUILT, FIRE ALARM PHASE I UPGRADE

02 BLDG 2/2A

REPLACEMENT FIRE ALARM SYSTEM

MOI/MID MODULE ARRANGEMENT

UNIVERSITY OF CALIFORNIA
LAWRENCE BERKELEY NATIONAL LABORATORY
FACILITIES DIVISION

DRAWN BY AD	DATE 2/14/2003	
CHECKED BY MCG	2/14/2003	
APPROVED BY MCG	2/14/2003	
CAD FILE PATH		
SCALE Full		
DRAWING NO. 4B02E165D	SHEET 1 OF 1	
PROJECT NO. 120863		