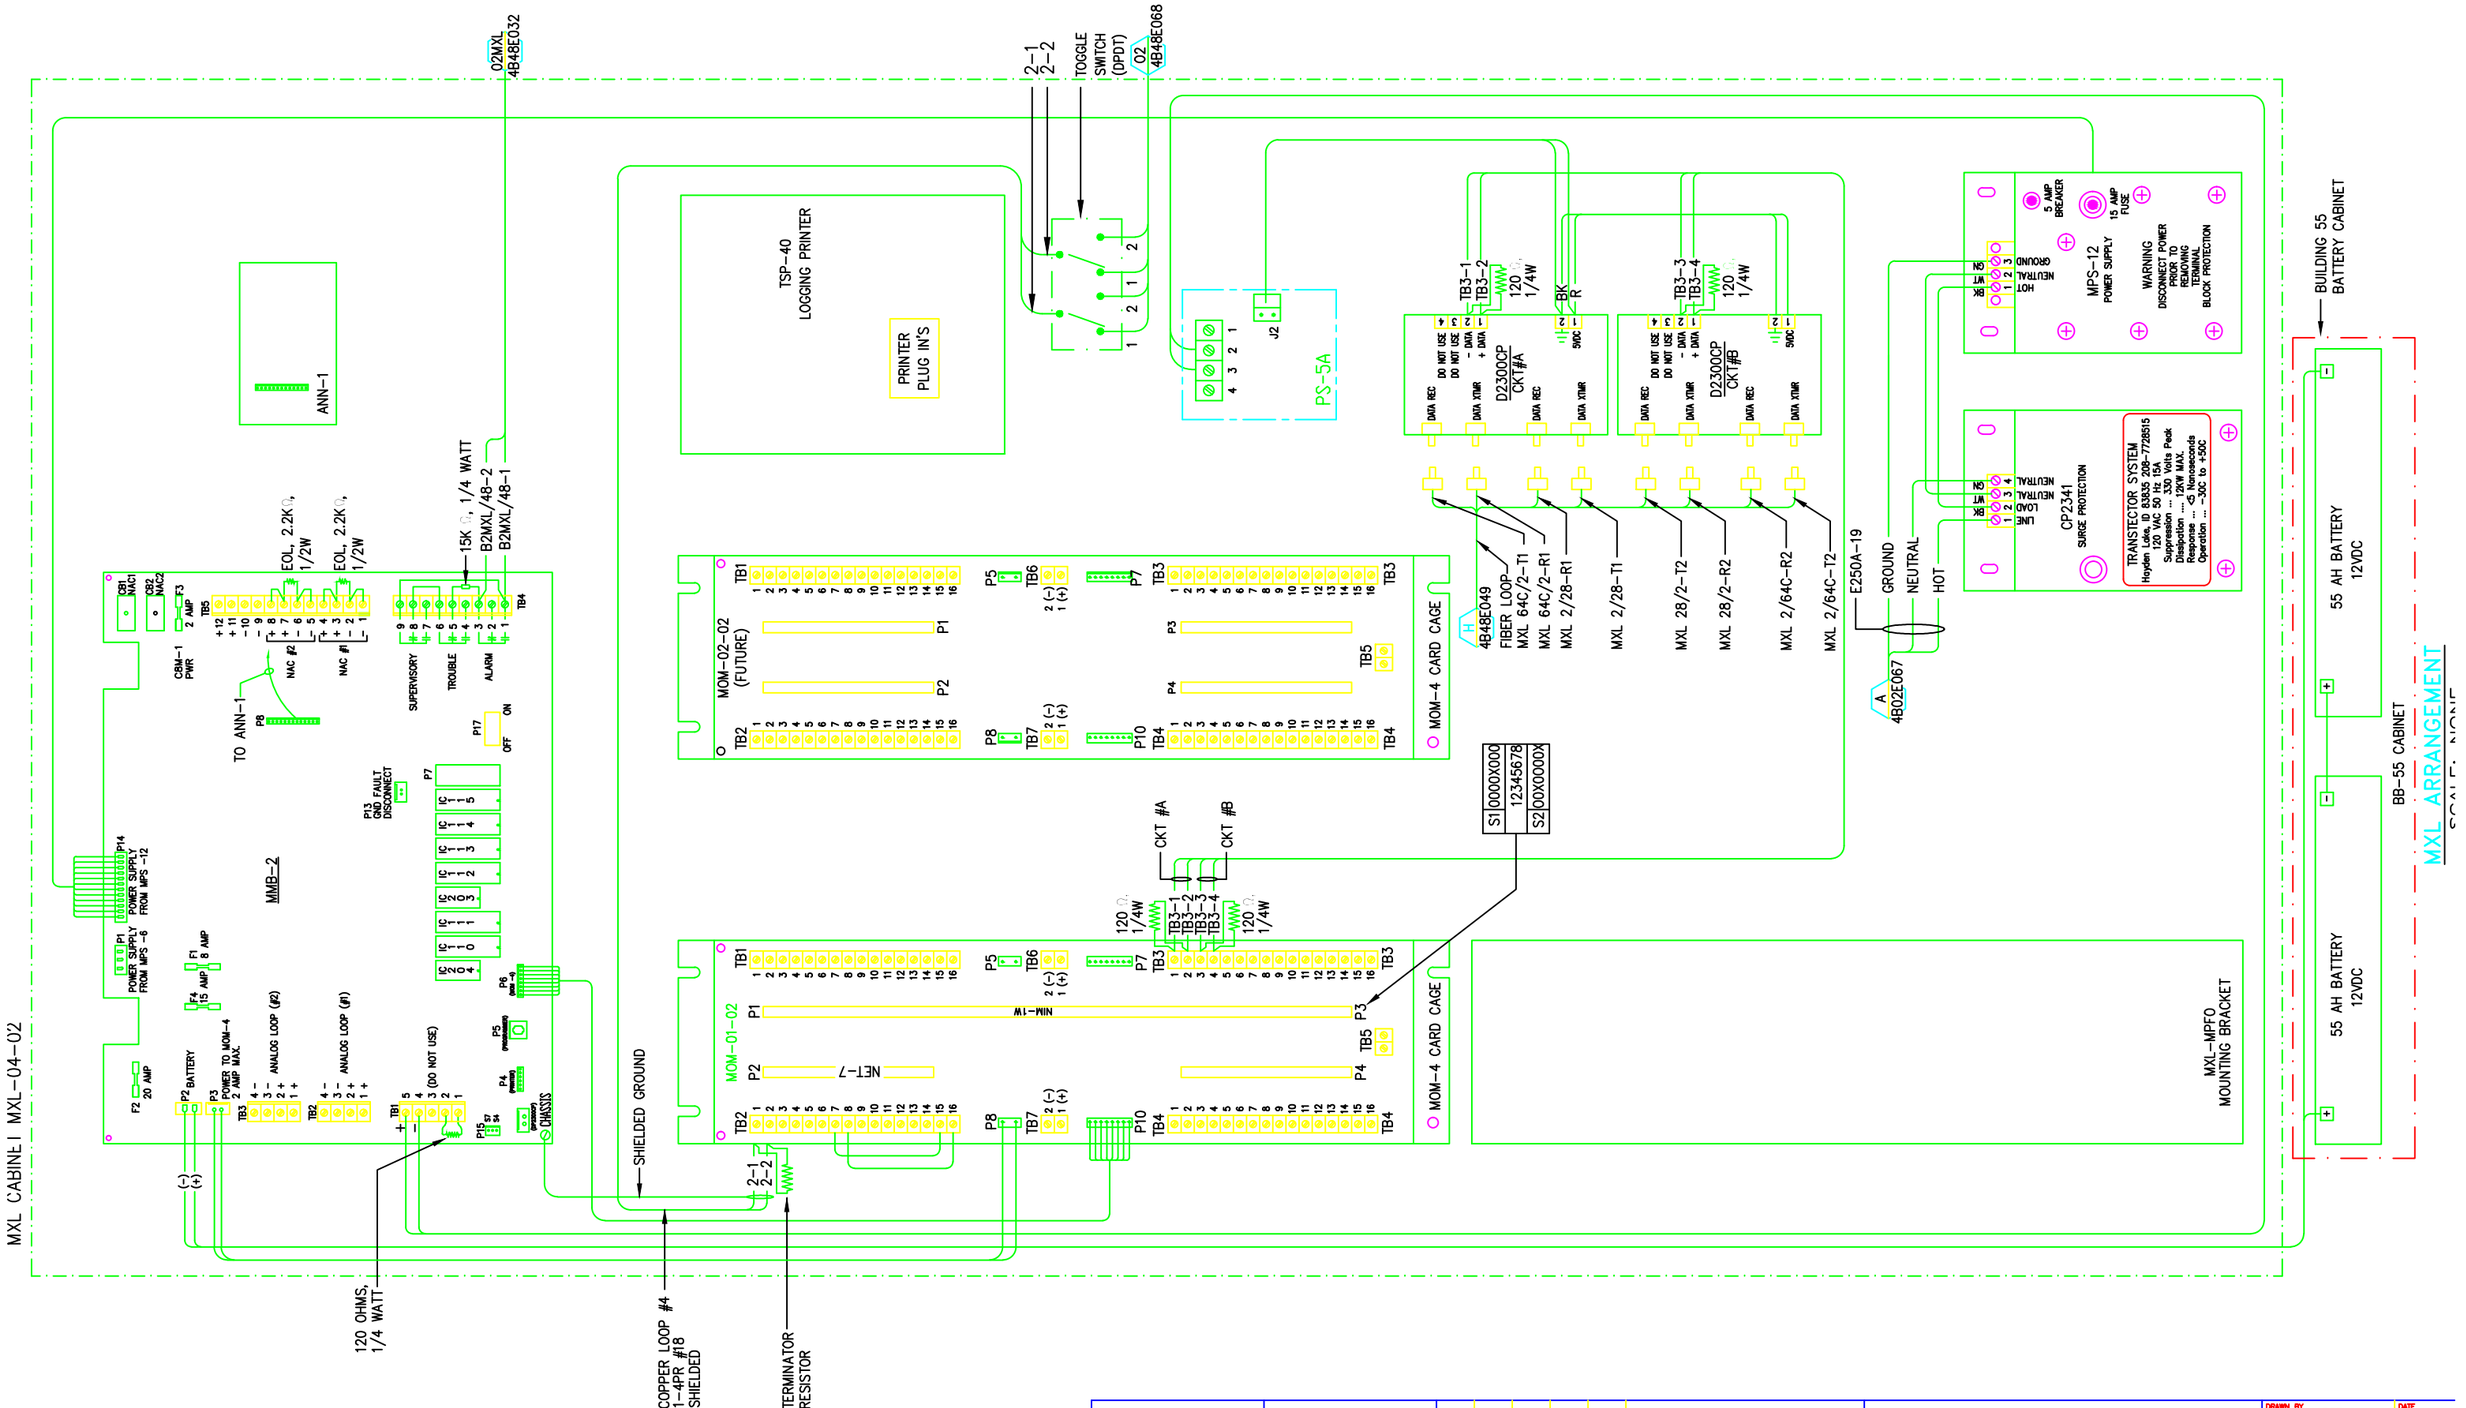


| | | | | | | | |
|---|---|---|---|---|---|---|---|
| D | LDD | LDD | MCD | 04/23/13 | AS-BUILT PER FIELD VERIFICATION |
| C | AD | LDD | MCD | 02/07/07 | AS-BUILT RECORD DRAWING PER CLIENT COMMENTS |
| B | AD | LDD | MCD | 03/20/06 | REVISED FOR MXL COPPER LOOP |
| A | AD | MCG | MCG | 12/05/05 | REVISED PER SEIMENS REVIEW |
| REVISION NUMBER | DRAWN BY | CHECKED BY | APPR'D BY | DATE | REMARKS |

PROFESSIONAL SEAL (IF REVISION, APPLIES ONLY TO REVISED WORK)

ISSUE (PROGRESS, ESTIMATE, BID, CONSTRUCTION, CONFORMED, REVISION, RECORD)

ASBUILT REVISION D 4/23/2013

02 FIRE ALARM

MXL FIRE ALARM SYSTEM, MXL #4

FAP ARRANGEMENT/WIRING DIAGRAM

UNIVERSITY OF CALIFORNIA
LAWRENCE BERKELEY NATIONAL LABORATORY
FACILITIES DIVISION

| | | |
|---|---|---|
| DRAWN BY | RZT | DATE 3/10/200 |
| CHECKED BY | MCG | 3/10/200 |
| APPROVED BY | MCG | 3/10/200 |
| CAD FILE PATH | | |
| SCALE | Full | |
| DRAWING NO. | 4B02E219D | SHEET |
| PROJECT NO. | FE5200 | 1 OF 1 |