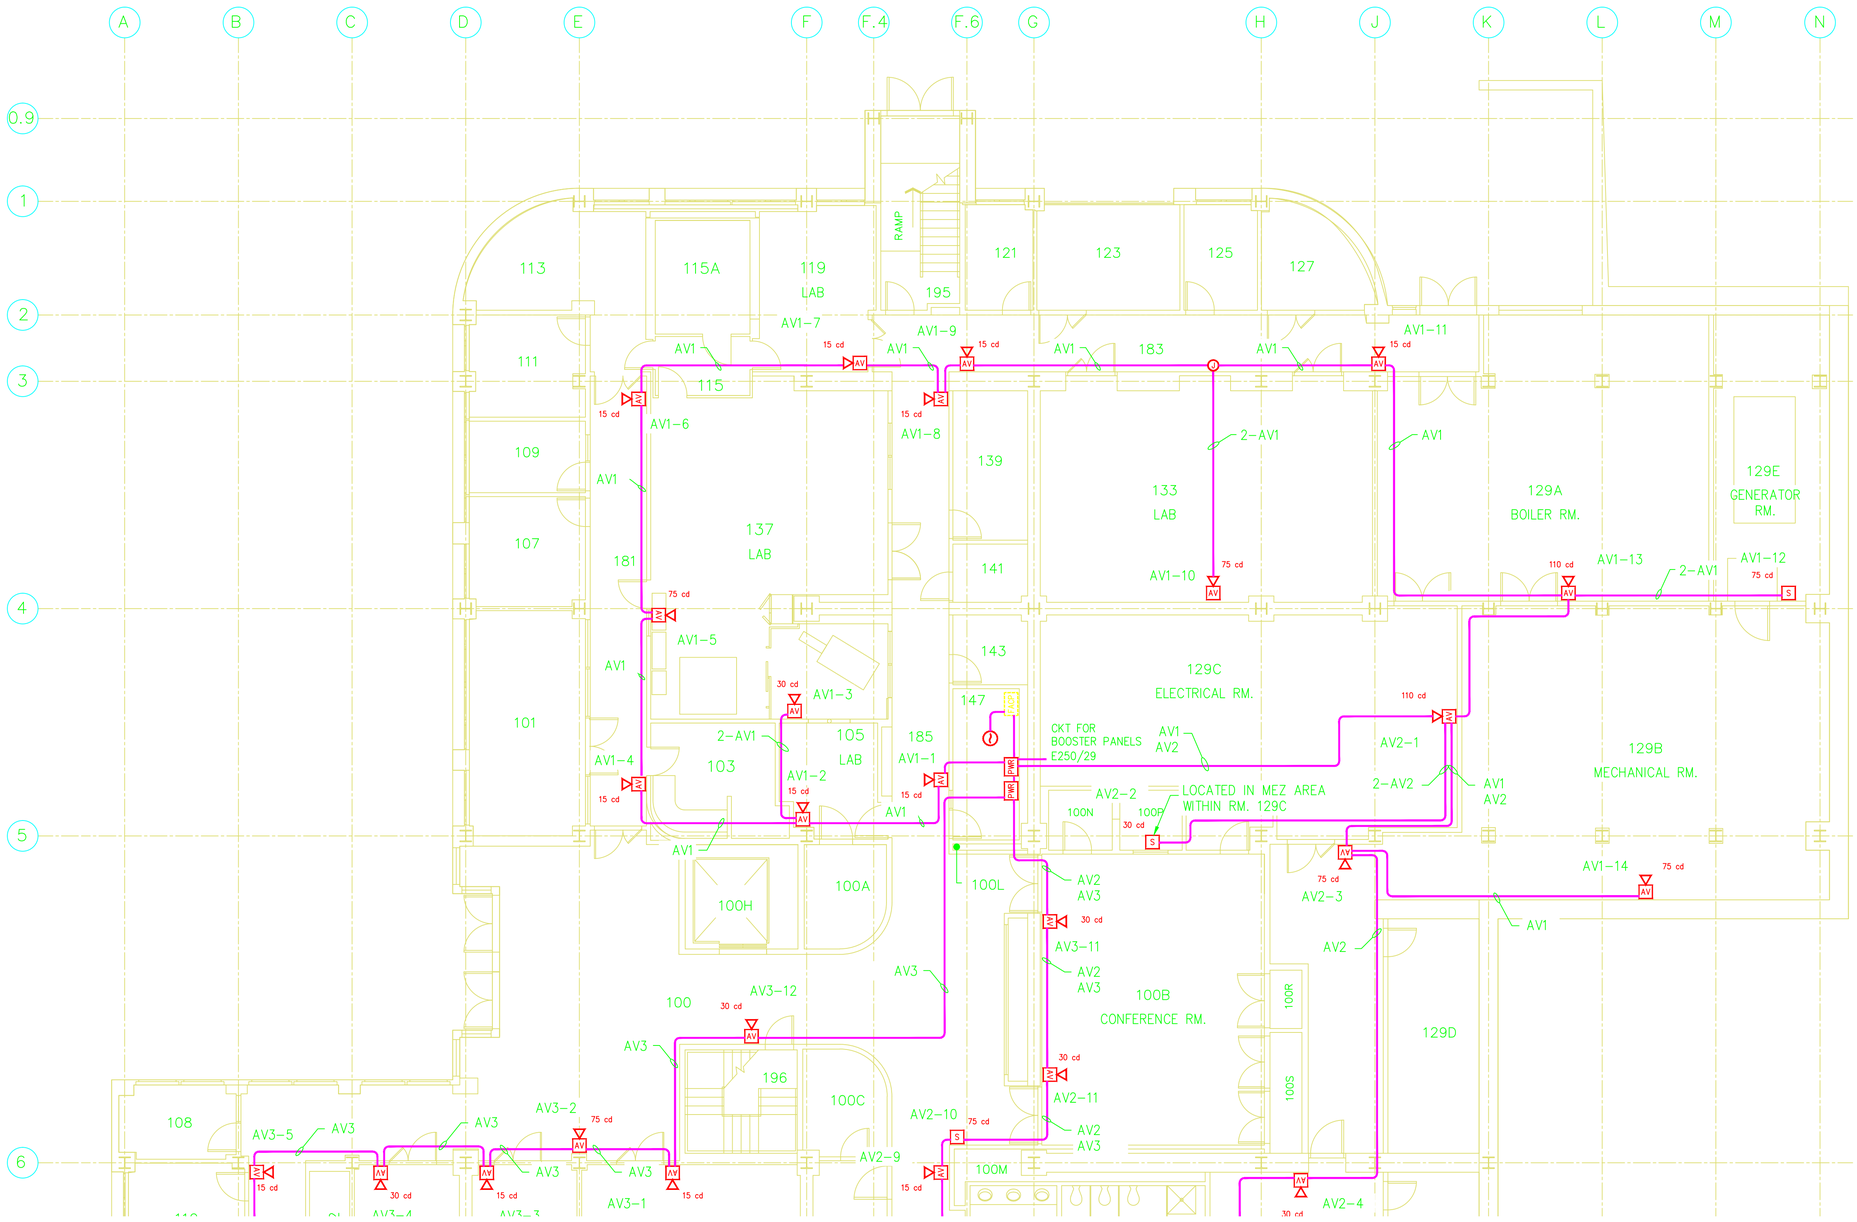

LEGEND

- NEW WALL MOUNTED NOTIFICATION APPLIANCE (HORN/STROBE).
- CM 15 cd NEW WALL MOUNTED NOTIFICATION APPLIANCE (STROBE).
- 15 cd NEW CEILING MOUNTED NOTIFICATION APPLIANCE (HORN/STROBE).
- NEW PHOTOELECTRIC SMOKE DETECTOR.
- PWR NEW NOTIFICATION APPLIANCE CIRCUIT POWER PANEL.
- FAP EXISTING FIRE ALARM CONTROL UNIT.
- NEW ¾ INCH FIRE ALARM CONDUIT.

CONDUCTOR IDENTIFICATION LEGEND

AV1 1 PAIR #14 NOTIFICATION APPLIANCE CIRCUIT CONDUCTORS (CKT AV1).

2-AV1 2 PAIR #14 NOTIFICATION APPLIANCE CIRCUIT CONDUCTORS (CKT AV1). BROWN & ORANGE (STROBE); BLACK & WHITE (HORN)

BUILDING KEY PLAN

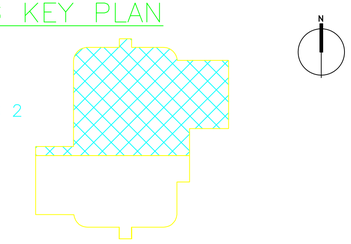

1 FA1.1 1ST FLOOR PARTIAL FIRE ALARM PLAN

SCALE: 1/8"=1'-0"

0 8 FT 16 FT 24 FT
SCALE: 1/8"=1'-0" UNO

N W E S

CONSULTING FIRM	PROFESSIONAL SEAL (IF REVISION, APPLIES ONLY TO REVISED WORK)	ISSUE (PROGRESS, ESTIMATE, BID, CONSTRUCTION, CONFORMED, REVISION, RECORD)	REVISION NUMBER	DRAWN BY	CHECKED BY	APPR'D BY	DATE	REMARKS
		RECORD DRAWING 08/26/11						

02
FIRE ALARM SYSTEM – NOTIFICATION APPLIANCES
PARTIAL 1ST FLOOR PLAN

DRAWN BY DWH	DATE	
CHECKED BY BBT	06/12/09	
APPROVED BY	–	
CAD FILE PATH		
SCALE AS NOTED		

UNIVERSITY OF CALIFORNIA
LAWRENCE BERKELEY NATIONAL LABORATORY
FACILITIES DIVISION

DRAWING NO. 4B02E230
PROJECT NO. WAD263
SHEET FA1.1