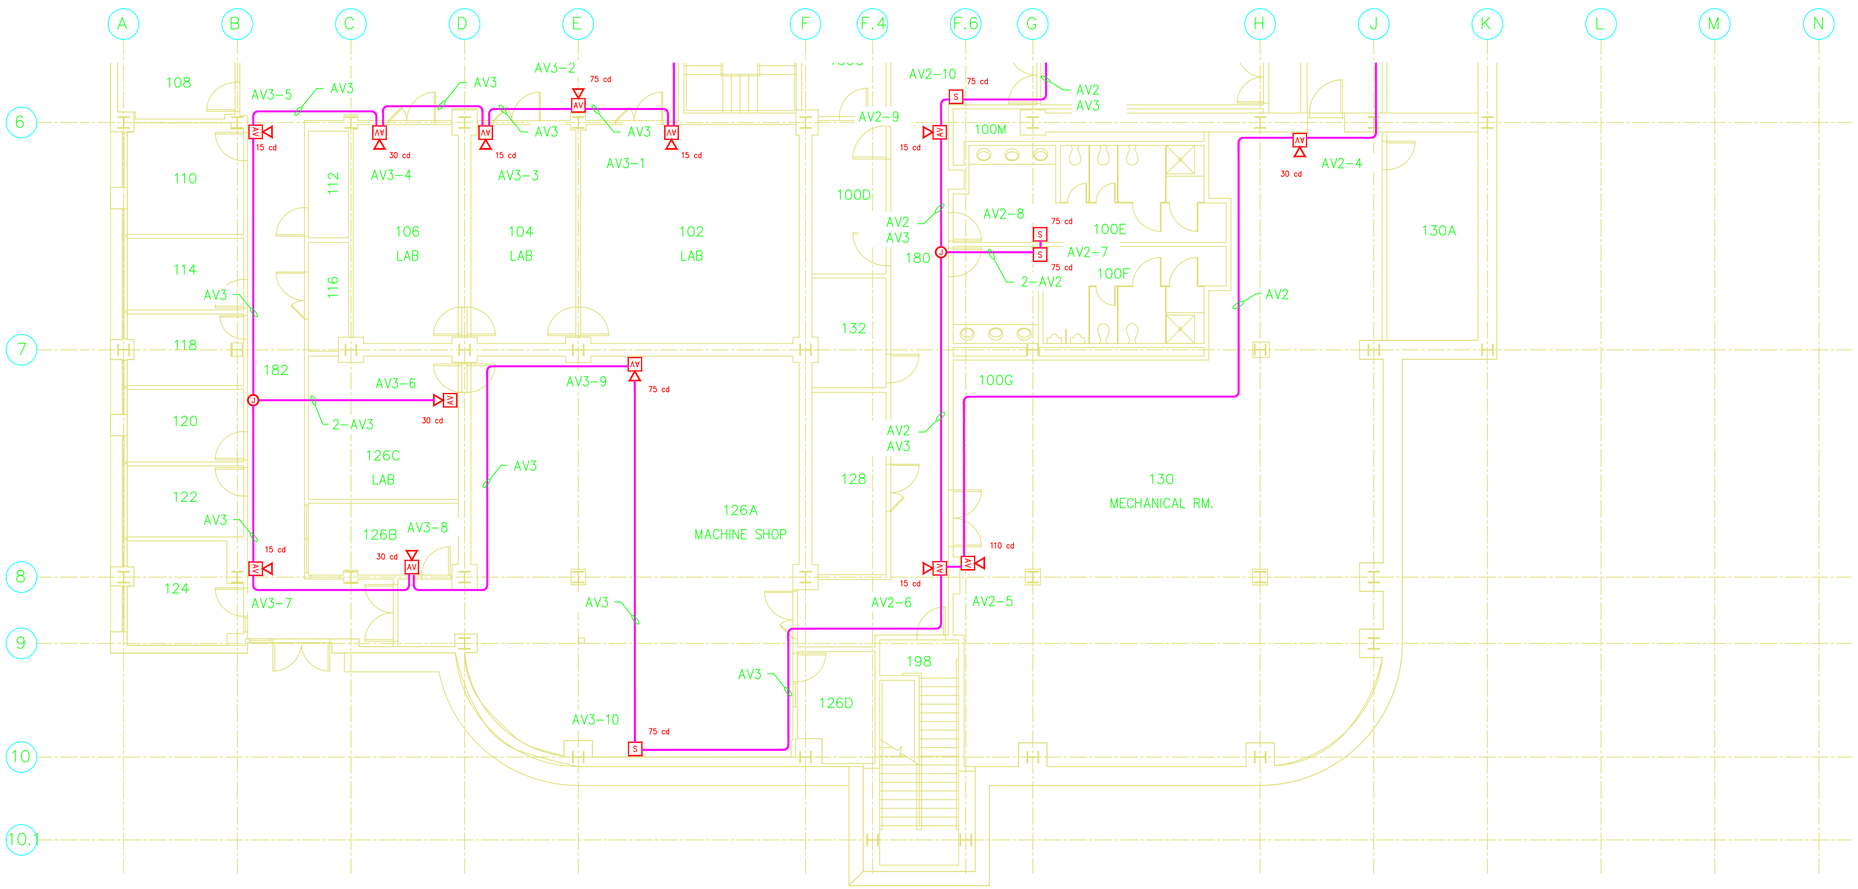

LEGEND

- NEW WALL MOUNTED NOTIFICATION APPLIANCE (HORN/STROBE).
- CM NEW WALL MOUNTED NOTIFICATION APPLIANCE (STROBE).
- NEW CEILING MOUNTED NOTIFICATION APPLIANCE (HORN/STROBE).
- NEW PHOTOELECTRIC SMOKE DETECTOR.
- PWR NEW NOTIFICATION APPLIANCE CIRCUIT POWER PANEL.
- FAP EXISTING FIRE ALARM CONTROL UNIT.
- NEW ¾ INCH FIRE ALARM CONDUIT.

CONDUCTOR IDENTIFICATION LEGEND

AV1 1 PAIR #14 NOTIFICATION APPLIANCE CIRCUIT CONDUCTORS (CKT AV1).

2-AV1 2 PAIR #14 NOTIFICATION APPLIANCE CIRCUIT CONDUCTORS (CKT AV1). BROWN & ORANGE (STROBE); BLACK & WHITE (HORN)

BUILDING KEY PLAN

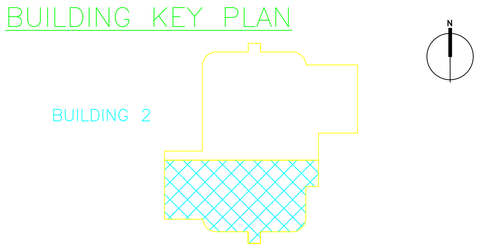

1 FA1.2 1ST FLOOR PARTIAL FIRE ALARM PLAN

SCALE: 1/8"=1'-0"

0 8 FT 16 FT 24 FT

SCALE: 1/8"=1'-0" UNO

N W E S

CONSULTING FIRM	PROFESSIONAL SEAL (IF REVISION, APPLIES ONLY TO REVISED WORK)	ISSUE (PROGRESS, ESTIMATE, BID, CONSTRUCTION, CONFORMED, REVISION, RECORD)	REVISION NUMBER	DRAWN BY	CHECKED BY	APPR'D BY	DATE	REMARKS	
		RECORD DRAWING 08/26/11							

02

FIRE ALARM SYSTEM – NOTIFICATION APPLIANCES

PARTIAL 1ST FLOOR PLAN

UNIVERSITY OF CALIFORNIA
LAWRENCE BERKELEY NATIONAL LABORATORY
FACILITIES DIVISION

DRAWN BY DWH	DATE
CHECKED BY BBT	06/12/09
APPROVED BY	–
CAD FILE PATH	
SCALE AS NOTED	
DRAWING NO. 4B02E231	SHEET FA1.2
PROJECT NO. WAD263	