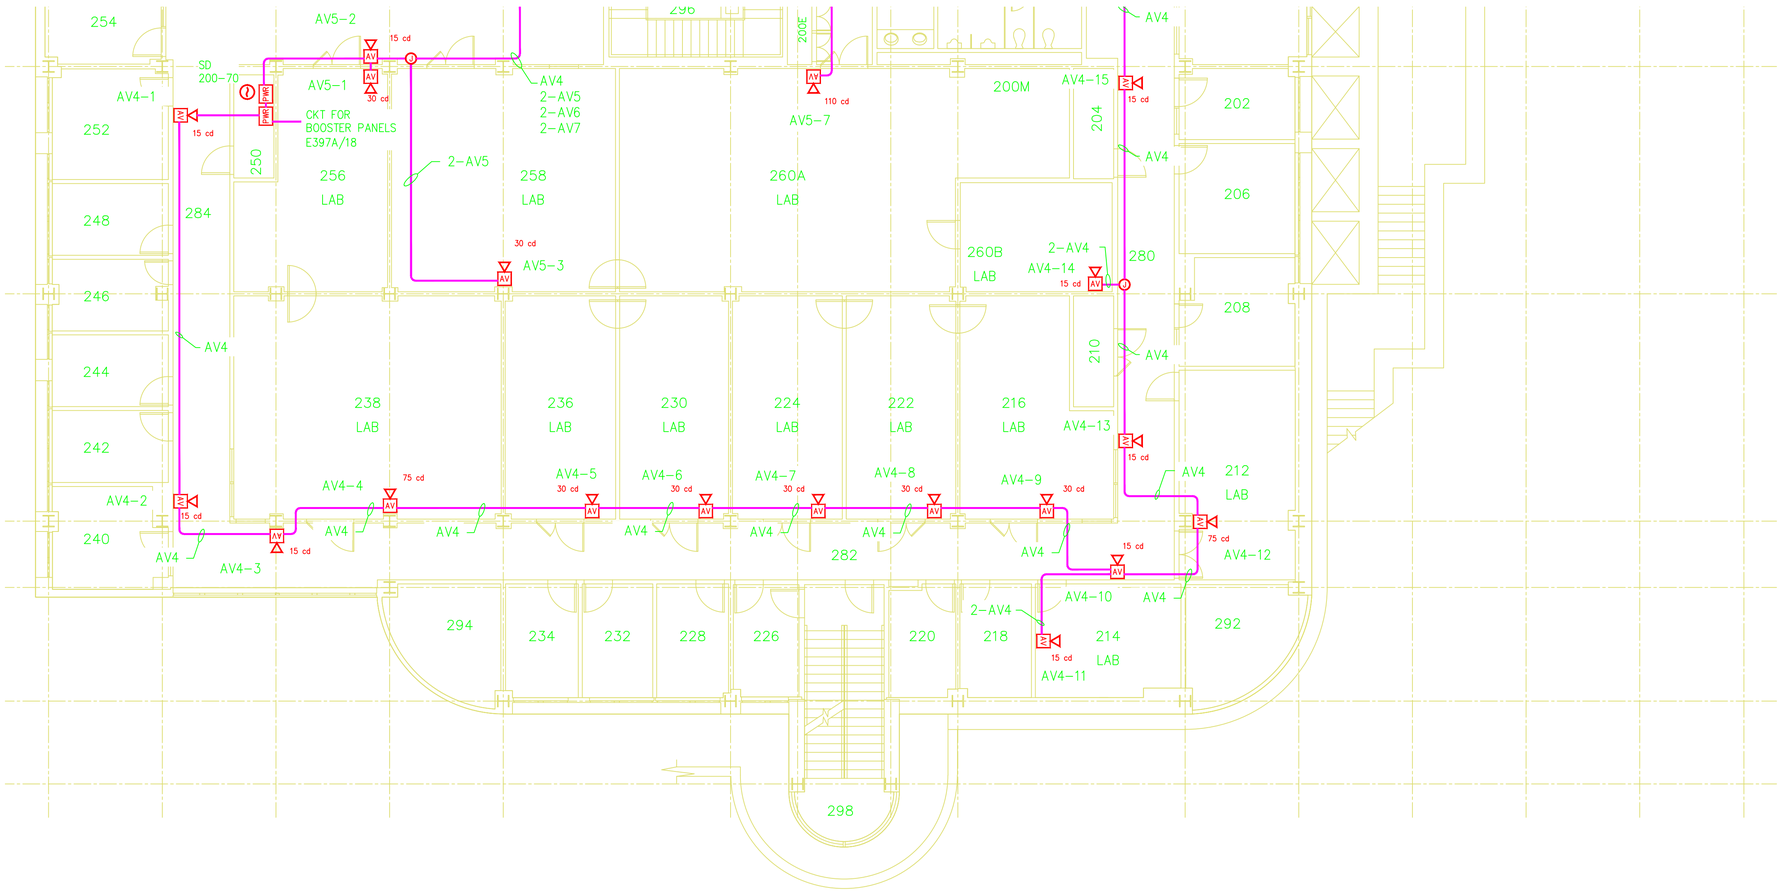

LEGEND

- NEW WALL MOUNTED NOTIFICATION APPLIANCE (HORN/STROBE).
- CM S 15 cd — NEW WALL MOUNTED NOTIFICATION APPLIANCE (STROBE).
- AV 15 cd — NEW CEILING MOUNTED NOTIFICATION APPLIANCE (HORN/STROBE).
- NEW PHOTOELECTRIC SMOKE DETECTOR.
- PWR — NEW NOTIFICATION APPLIANCE CIRCUIT POWER PANEL.
- FAP — EXISTING FIRE ALARM CONTROL UNIT.
- NEW ¾ INCH FIRE ALARM CONDUIT.

CONDUCTOR IDENTIFICATION LEGEND

AV1 — 1 PAIR #14 NOTIFICATION APPLIANCE CIRCUIT CONDUCTORS (CKT AV1).

2-AV1 — 2 PAIR #14 NOTIFICATION APPLIANCE CIRCUIT CONDUCTORS (CKT AV1). BROWN & ORANGE (STROBE); BLACK & WHITE (HORN)

BUILDING KEY PLAN

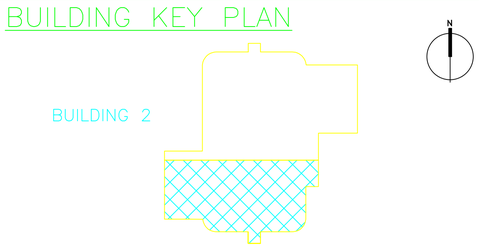

1 / FA2.2 2ND FLOOR PARTIAL FIRE ALARM PLAN

SCALE: 1/8"=1'-0"

0 8 FT 16 FT 24 FT
SCALE: 1/8"=1'-0" UNO

N W E S

RECORD DRAWING

08/26/11

REVISION NUMBER	DRAWN BY	CHECKED BY	APPR'D BY	DATE	REMARKS

CONSULTING FIRM

PROFESSIONAL SEAL (IF REVISION, APPLIES ONLY TO REVISED WORK)

ISSUE (PROGRESS, ESTIMATE, BID, CONSTRUCTION, CONFORMED, REVISION, RECORD)

02
FIRE ALARM SYSTEM – NOTIFICATION APPLIANCES
PARTIAL 2ND FLOOR PLAN

UNIVERSITY OF CALIFORNIA
LAWRENCE BERKELEY NATIONAL LABORATORY
FACILITIES DIVISION

DRAWN BY DWH	DATE	
CHECKED BY BBT	06/12/09	
APPROVED BY	–	
CAD FILE PATH		
SCALE AS NOTED		
DRAWING NO. 4B02E233	SHEET FA2.2	
PROJECT NO. WAD263		