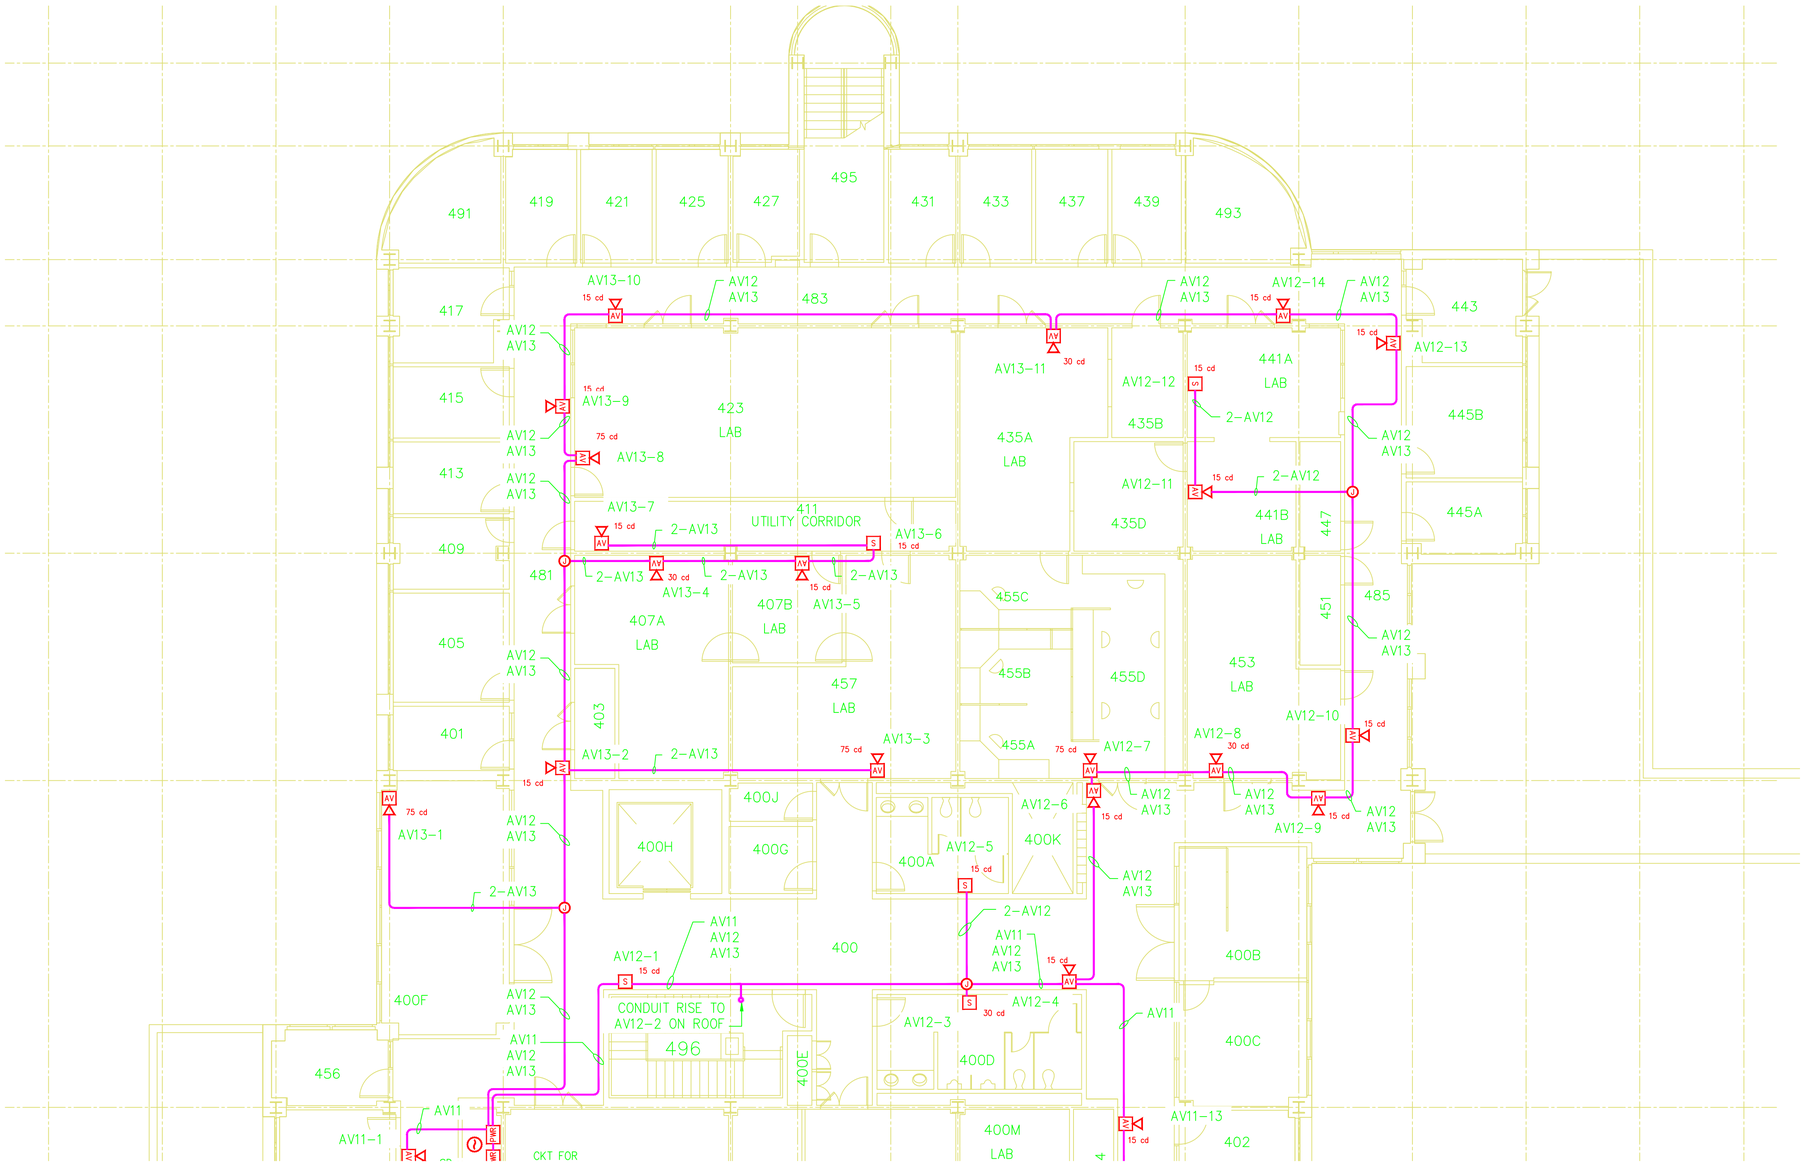

LEGEND

- NEW WALL MOUNTED NOTIFICATION APPLIANCE (HORN/STROBE).
- NEW WALL MOUNTED NOTIFICATION APPLIANCE (STROBE).
- NEW CEILING MOUNTED NOTIFICATION APPLIANCE (HORN/STROBE).
- NEW PHOTOELECTRIC SMOKE DETECTOR.
- NEW NOTIFICATION APPLIANCE CIRCUIT POWER PANEL.
- EXISTING FIRE ALARM CONTROL UNIT.
- NEW $\frac{3}{4}$ INCH FIRE ALARM CONDUIT.

CONDUCTOR IDENTIFICATION LEGEND

AV1	1 PAIR #14 NOTIFICATION APPLIANCE CIRCUIT CONDUCTORS (CKT AV1).
2-AV1	2 PAIR #14 NOTIFICATION APPLIANCE CIRCUIT CONDUCTORS (CKT AV1). BROWN & ORANGE (STROBE); BLACK & WHITE (HORN)

BUILDING KEY PLAN

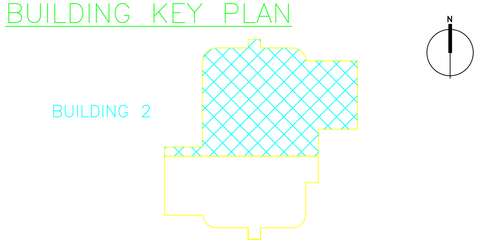

1 FA4.1 4TH FLOOR PARTIAL FIRE ALARM PLAN

SCALE: 1/8"=1'-0"

0 8 FT 16 FT 24 FT
SCALE: 1/8"=1'-0" UNO

N W E S

RECORD DRAWING

08/26/11

02
FIRE ALARM SYSTEM - NOTIFICATION APPLIANCES
PARTIAL 4TH FLOOR PLAN

UNIVERSITY OF CALIFORNIA
LAWRENCE BERKELEY NATIONAL LABORATORY
FACILITIES DIVISION

DRAWN BY DWH	DATE
CHECKED BY BBT	06/12/09
APPROVED BY	–
CAD FILE PATH	
SCALE AS NOTED	
DRAWING NO. 4B02E236	SHEET FA4.1
PROJECT NO. WAD263	

CONSULTING FIRM	PROFESSIONAL SEAL (IF REVISION, APPLIES ONLY TO REVISED WORK)	ISSUE (PROGRESS, ESTIMATE, BID, CONSTRUCTION, CONFORMED, REVISION, RECORD)	REVISION NUMBER	DRAWN BY	CHECKED BY	APPR'D BY	DATE	REMARKS