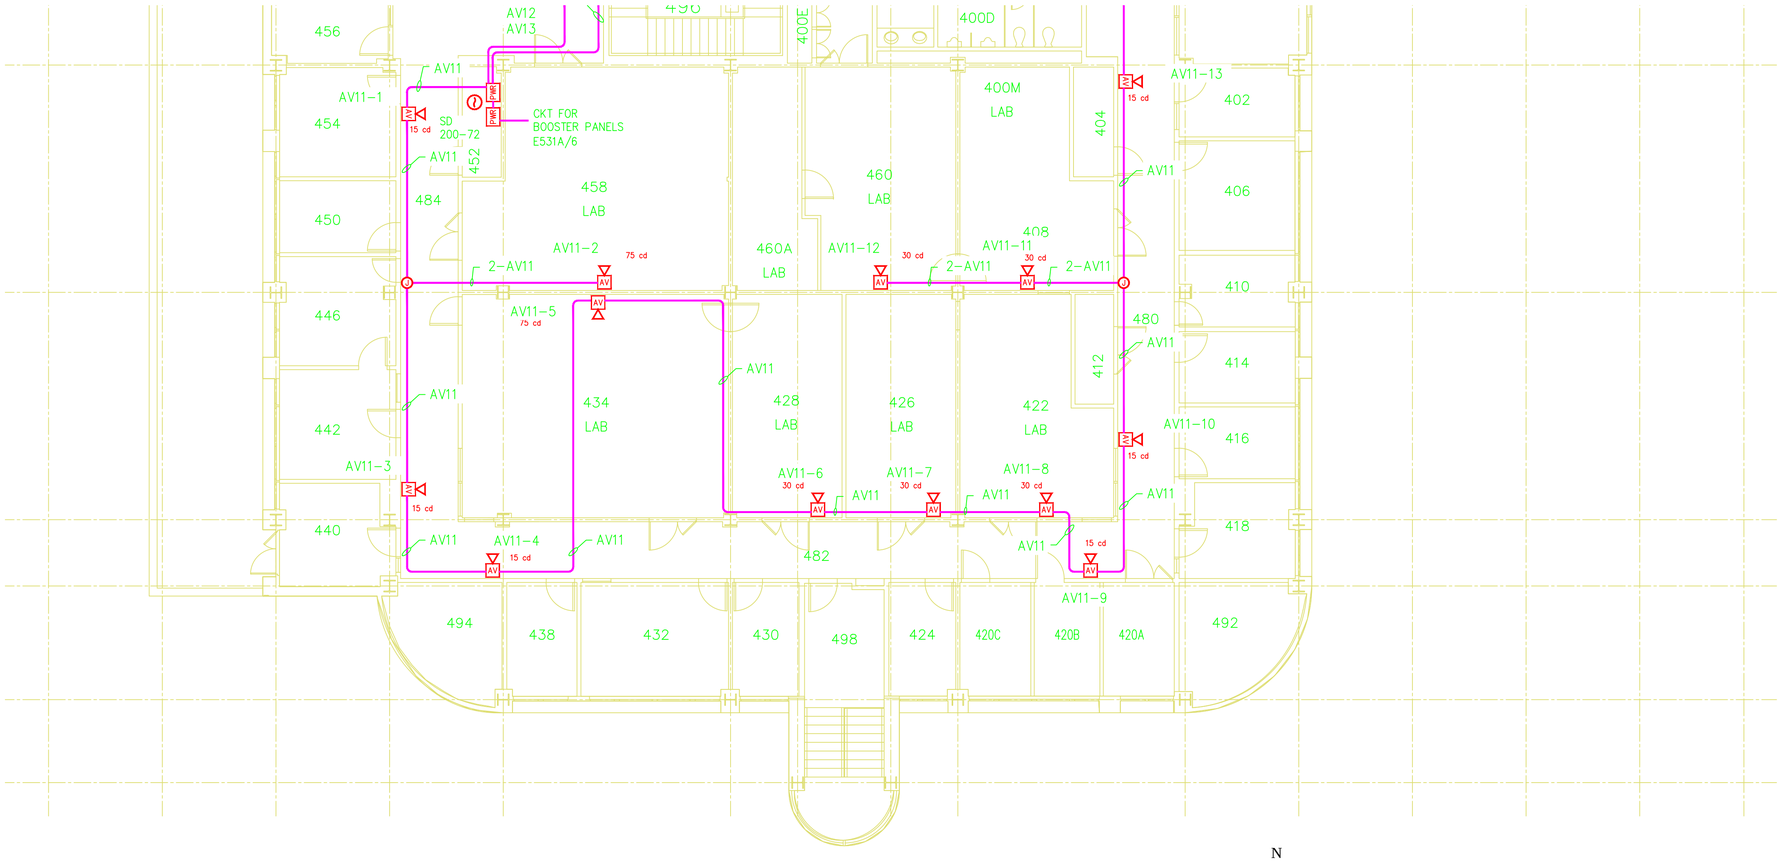

1 FA4.2 4TH FLOOR PARTIAL FIRE ALARM PLAN

SCALE: 1/8"=1'-0"

0 8 FT 16 FT 24 FT
SCALE: 1/8"=1'-0" UNO

N W E S

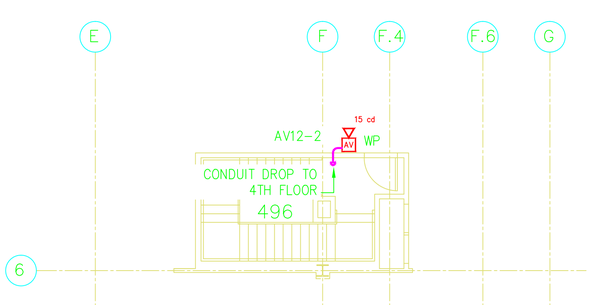

2 FA4.2 ROOF PARTIAL FIRE ALARM PLAN

SCALE: 1/8"=1'-0"

LEGEND

- AV — NEW WALL MOUNTED NOTIFICATION APPLIANCE (HORN/STROBE).
- CM S 15 cd — NEW WALL MOUNTED NOTIFICATION APPLIANCE (STROBE).
- AV 15 cd — NEW CEILING MOUNTED NOTIFICATION APPLIANCE (HORN/STROBE).
- NEW PHOTOELECTRIC SMOKE DETECTOR.
- PWR — NEW NOTIFICATION APPLIANCE CIRCUIT POWER PANEL.
- FAP — EXISTING FIRE ALARM CONTROL UNIT.
- NEW ¾ INCH FIRE ALARM CONDUIT.

CONDUCTOR IDENTIFICATION LEGEND

AV1	1 PAIR #14 NOTIFICATION APPLIANCE CIRCUIT CONDUCTORS (CKT AV1).
2-AV1	2 PAIR #14 NOTIFICATION APPLIANCE CIRCUIT CONDUCTORS (CKT AV1). BROWN & ORANGE (STROBE); BLACK & WHITE (HORN)

BUILDING KEY PLAN

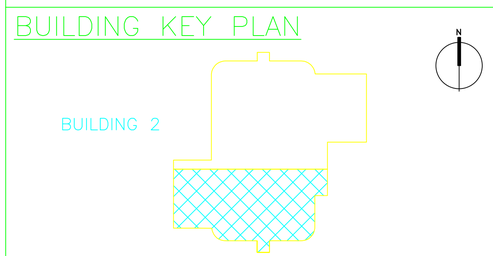

RECORD DRAWING

08/26/11

CONSULTING FIRM	PROFESSIONAL SEAL (IF REVISION, APPLIES ONLY TO REVISED WORK)	ISSUE (PROGRESS, ESTIMATE, BID, CONSTRUCTION, CONFORMED, REVISION, RECORD)	REVISION NUMBER	DRAWN BY	CHECKED BY	APPR'D BY	DATE	REMARKS

02
FIRE ALARM SYSTEM – NOTIFICATION APPLIANCES
PARTIAL 4TH FLOOR & ROOF PLANS

UNIVERSITY OF CALIFORNIA
LAWRENCE BERKELEY NATIONAL LABORATORY
FACILITIES DIVISION

DRAWN BY DWH	DATE	
CHECKED BY BBT	06/12/09	
APPROVED BY	--	
CAD FILE PATH		
SCALE AS NOTED		
DRAWING NO. 4B02E237	SHEET FA4.2	
PROJECT NO. WAD263		