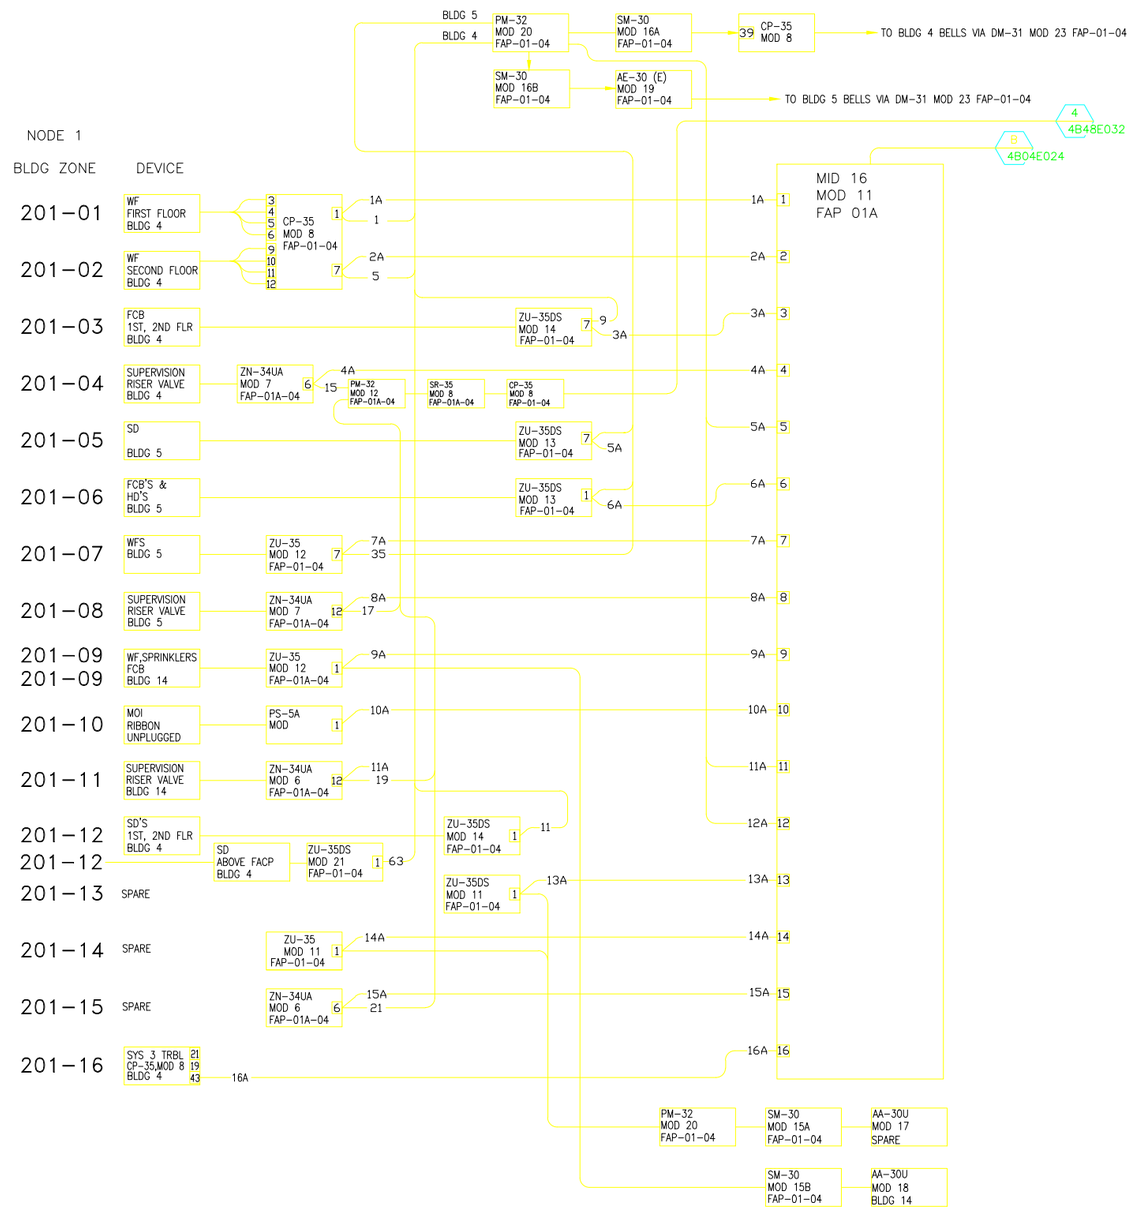

	ASBUILT REVISION G 04/16/13	G	LDD	LDD	MCD	04/16/13	AS-BUILT PER FIELD VERIFICATION
		F	SL			02/08/10	AS BUILT
		E	AD	LDD	MCD	11/28/06	AS-BUILT RECORD DRAWING PER CONSTRUCTION MARK-UP
		D	MRC	AD	MCG	02/11/05	PHASE III FIRE ALARM SYSTEM UP-GRADE
		C	AD	MCG	MCG	03/30/01	ISSUED FOR FIELD VERIFICATION
		B	LM		MG	4/14/97	AUTOCAD CONVERSION, AS BUILT, FIRE & LIFE SAFETY
		A	LSR	LDD		5/13/86	ADDED LED & EP-4 TO BLDG 41 S.D. CIRCUIT
PROFESSIONAL SEAL (IF REVISION, APPLIES ONLY TO REVISED WORK)	ISSUE (PROGRESS, ESTIMATE, BID, CONSTRUCTION, CONFORMED, REVISION, RECORD)	REVISION NUMBER	DRAWN BY	CHECKED BY	APPR'D BY	DATE	REMARKS

04 FIRE ALARM SYSTEM
LOGIC AND WIRING DIAGRAM
MOI 201

UNIVERSITY OF CALIFORNIA
LAWRENCE BERKELEY NATIONAL LABORATORY
FACILITIES DIVISION

DRAWN BY	AD	DATE 3/30/20C
CHECKED BY	MCG	3/30/20C
APPROVED BY	MCG	3/30/20C
CAD FILE PATH	00021632	
SCALE	Full	
DRAWING NO.	4B04E006G	SHEET FA
PROJECT NO.	FB4010	1 OF 1