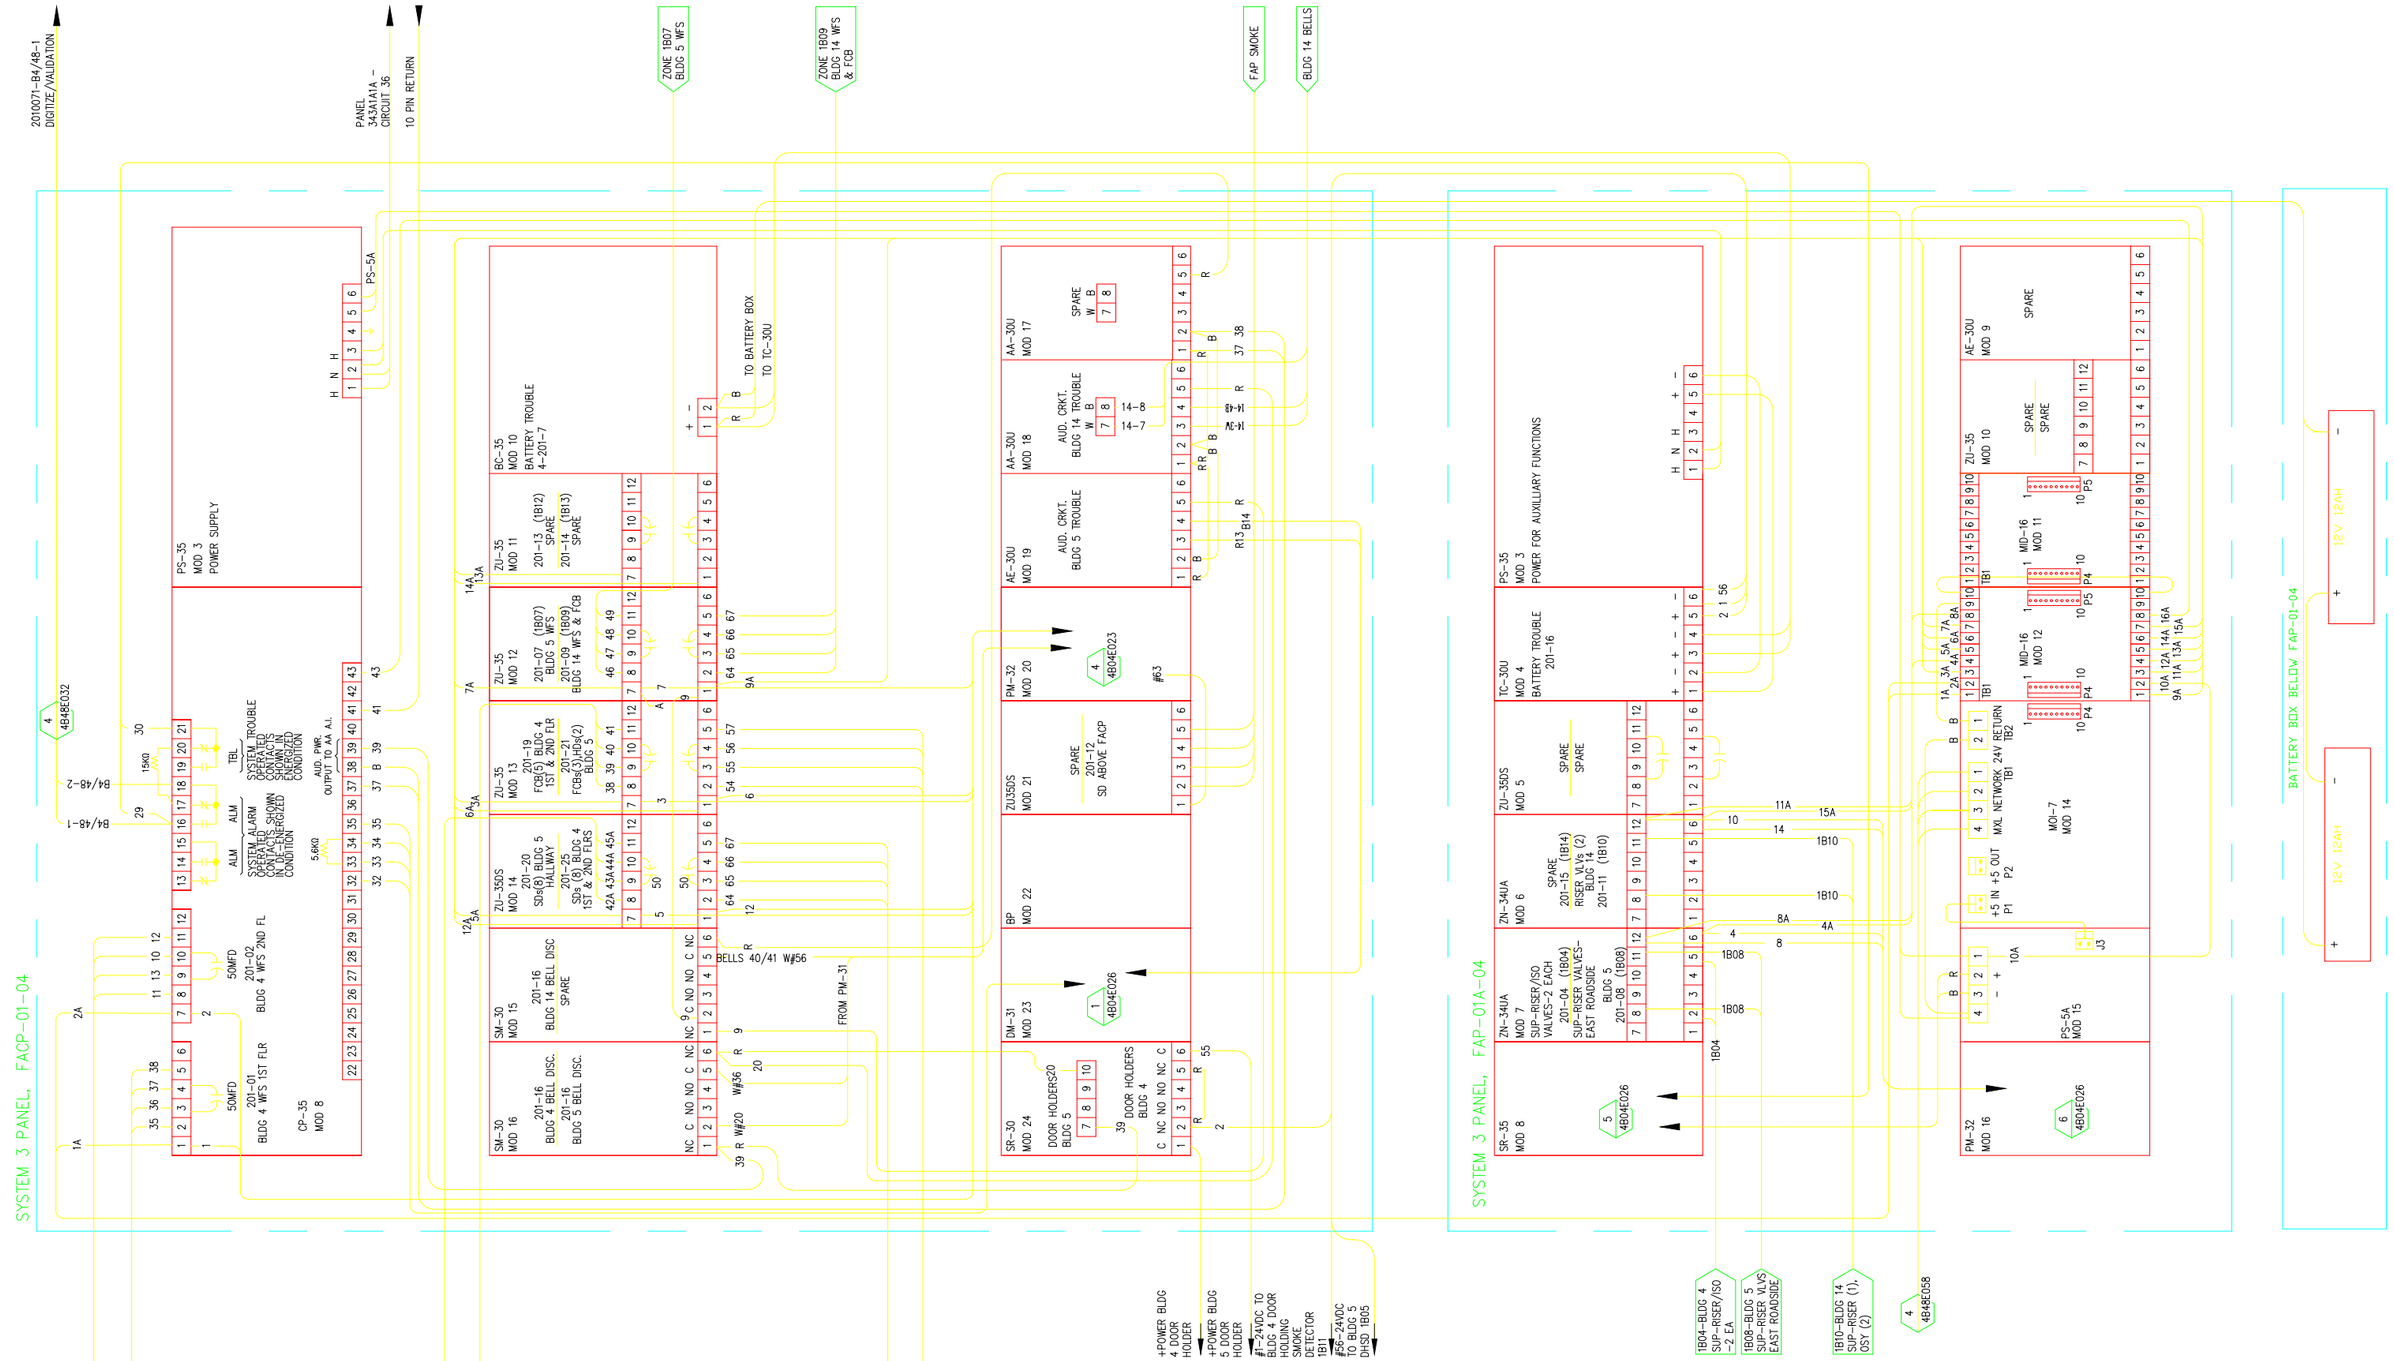

PROFESSIONAL SEAL (IF REVISION, APPLIES ONLY TO REVISED WORK)	ISSUE (PROGRESS, ESTIMATE, BID, CONSTRUCTION, CONFORMED, REVISION, RECORD)	REVISION NUMBER	DRAWN BY	CHECKED BY	APPR'D BY	DATE	REMARKS
	ASBUILT REVISION D 4/10/2013	D	LDD	MCD	MCD	04/10/13	AS BUILT PER FIELD VERIFICATION
		C	SL			02/01/2010	AS BUILT
		B	AD	LDD	MCD	11/07/06	AS-BUILT RECORD DRAWING, PER CONSTRUCTION MARK-UP
		A	AD	MCG	MCG	06/22/04	PHASE III FA UPGRADE

04 FIRE ALARM SYSTEM
SYSTEM 3 PANEL FAP-01-04
INTERCONNECTION DIAGRAM

UNIVERSITY OF CALIFORNIA
LAWRENCE BERKELEY NATIONAL LABORATORY
FACILITIES DIVISION

DRAWN BY LSR	DATE 5/11/199	
CHECKED BY JEH	5/11/199	
APPROVED BY ROB	5/11/199	
CAD FILE PATH		
SCALE As Noted		
DRAWING NO. 4B04E009D	SHEET FA	
PROJECT NO. FB4010	1 OF 1	