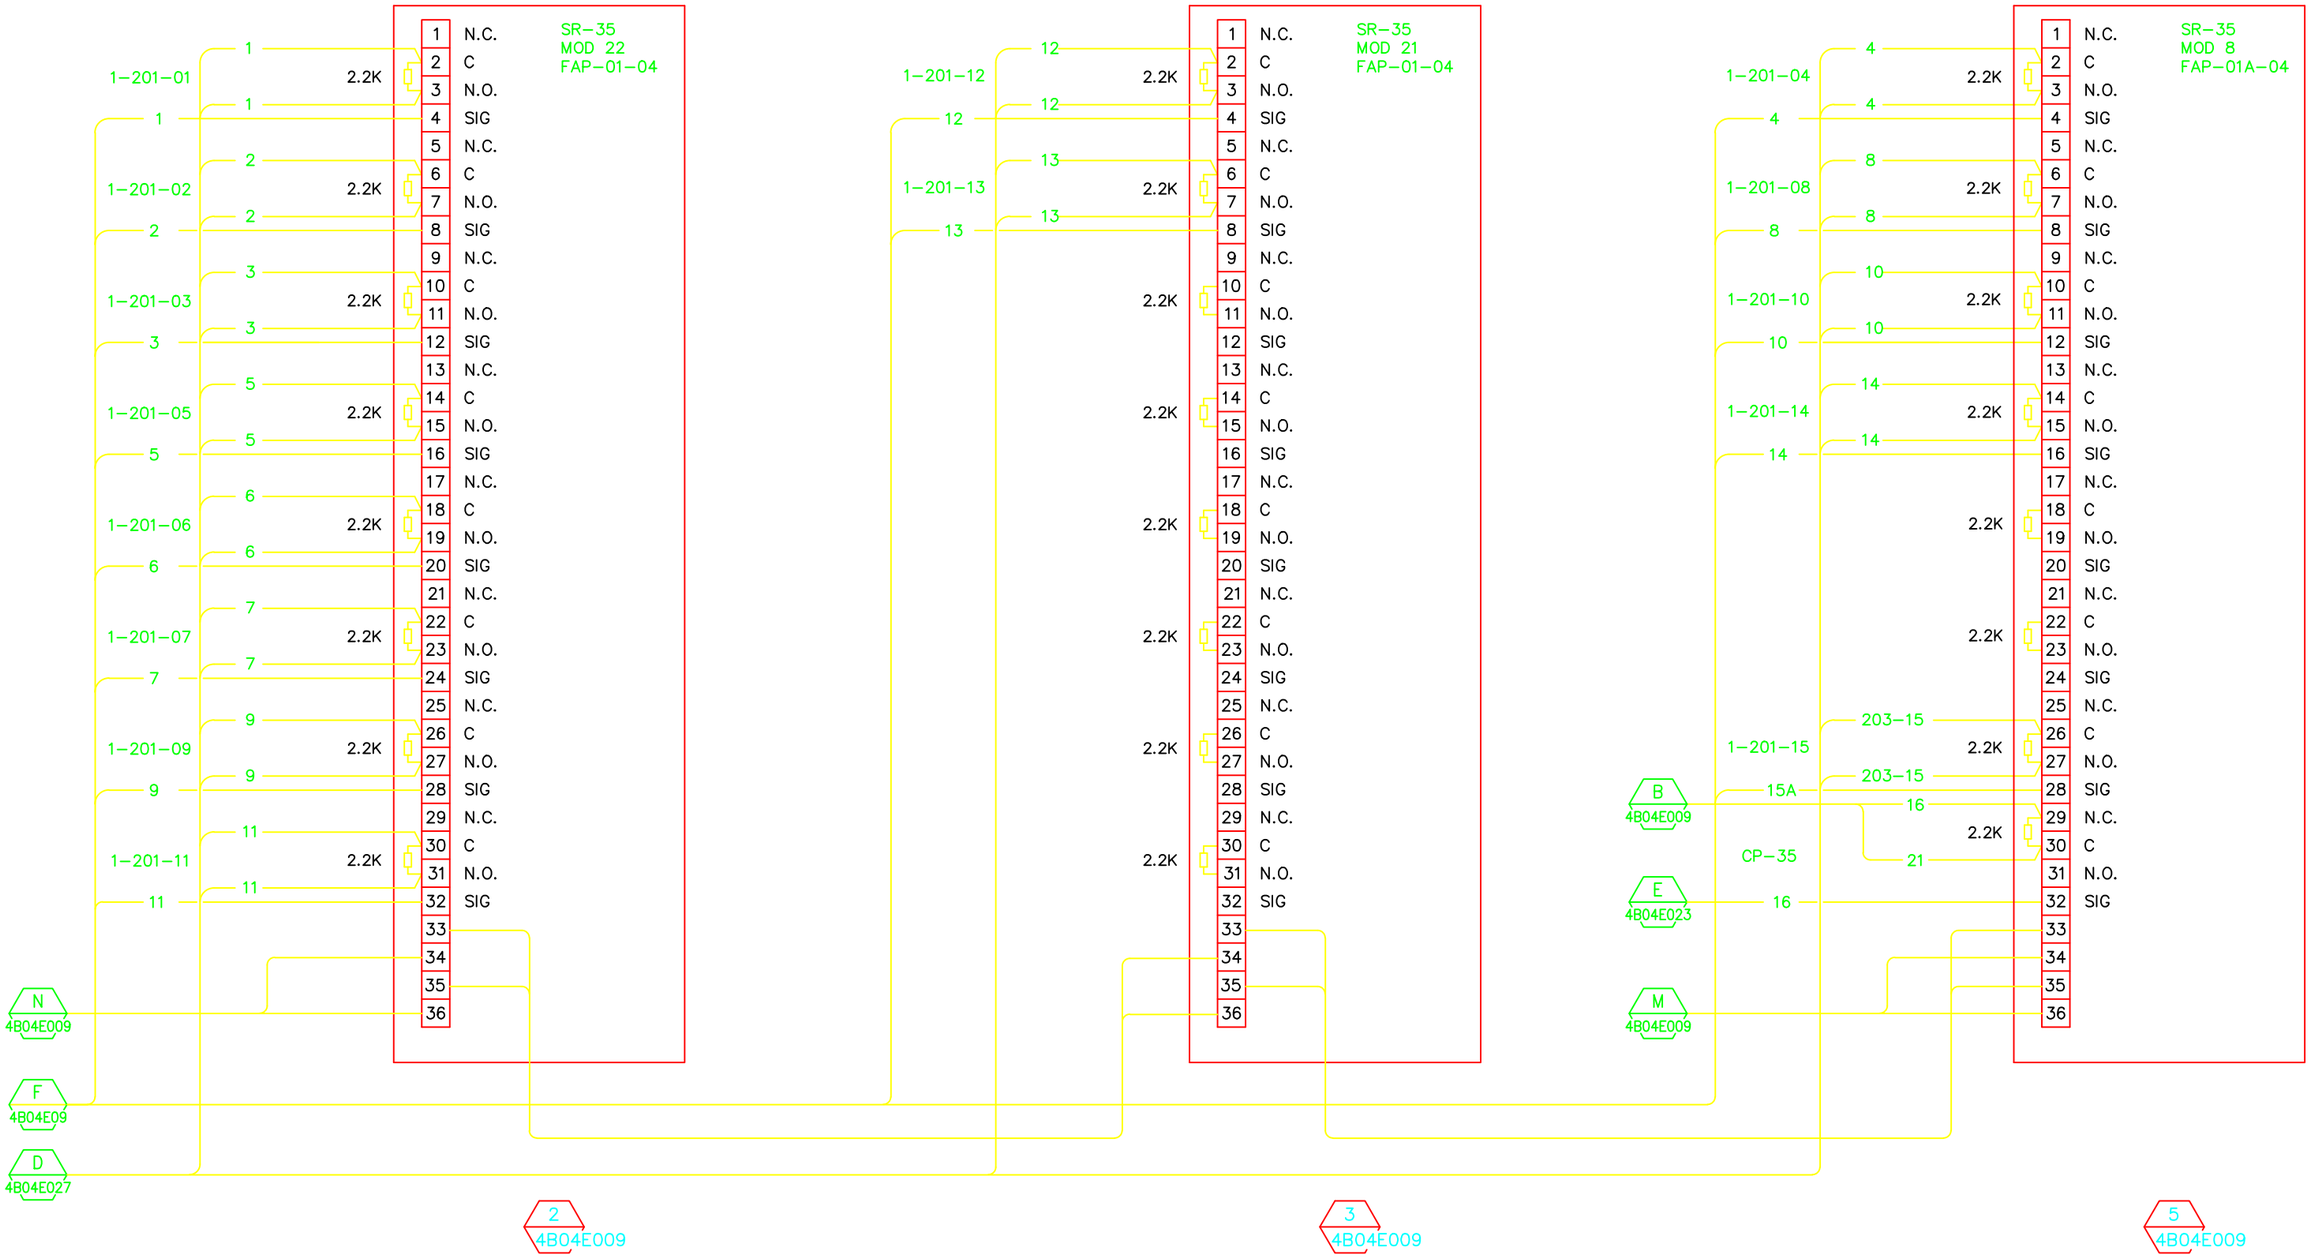

PROFESSIONAL SEAL (IF REVISION, APPLIES ONLY TO REVISED WORK)	ISSUE (PROGRESS, ESTIMATE, BID, CONSTRUCTION, CONFORMED, REVISION, RECORD)	REVISION NUMBER	DRAWN BY	CHECKED BY	APPR'D BY	DATE	REMARKS
	ASBUILT RECORD 04/24/13	A	LDD	MCD	MCD	04/24/13	AS BUILT PER FIELD VERIFICATION

04 FIRE ALARM SYSTEM
SYSTEM 3 PANEL FAP-01-04 AND
FAP-01A-04 SR-35 RELAYS

UNIVERSITY OF CALIFORNIA
LAWRENCE BERKELEY NATIONAL LABORATORY
FACILITIES DIVISION

DRAWN BY	AD	DATE 11/8/2006
CHECKED BY	LDD	11/8/2006
APPROVED BY	MCD	11/9/2006
CAD FILE PATH		
SCALE	Full	
DRAWING NO.	4B04E026A	SHEET
PROJECT NO.	FB4010	1 OF 1