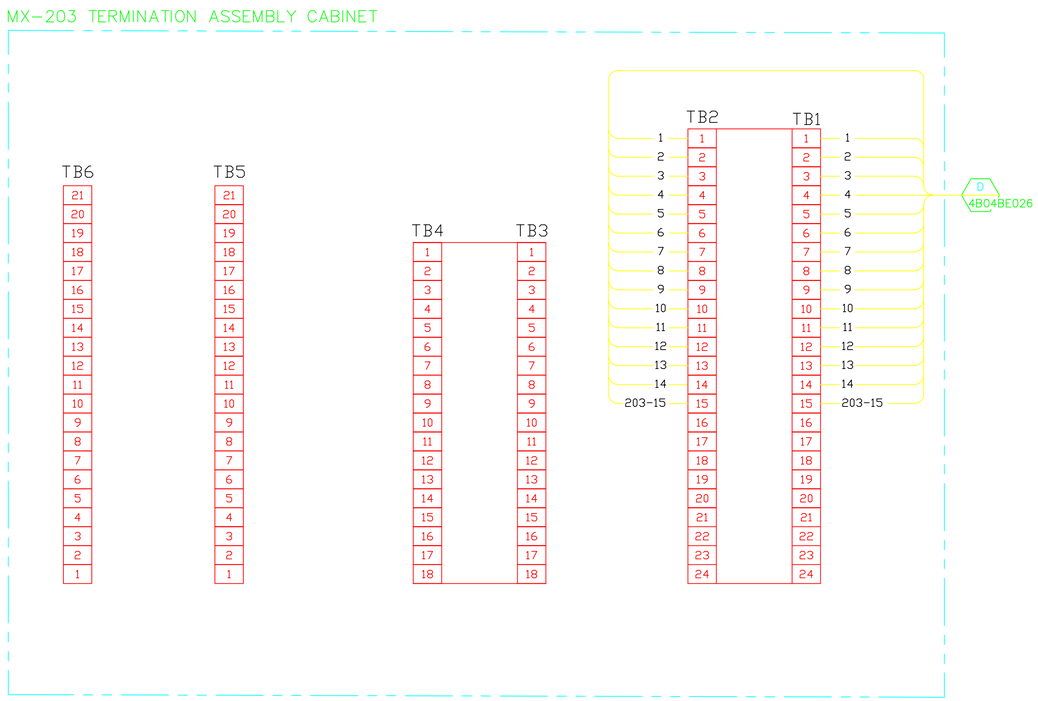

	ASBUILT REVISION A 11/13/2006	A	AD	LDD	MCD	11/13/06	AS-BUILT PER CONSTRUCTION MARK-UP	
PROFESSIONAL SEAL (IF REVISION, APPLIES ONLY TO REVISED WORK)	ISSUE (PROGRESS, ESTIMATE, BID, CONSTRUCTION, CONFORMED, REVISION, RECORD)	REVISION NUMBER	DRAWN BY	CHECKED BY	APPR'D BY	DATE	REMARKS	

04 FIRE ALARM SYSTEM
WIRING DIAGRAM
TRANSMITTER 107

UNIVERSITY OF CALIFORNIA
LAWRENCE BERKELEY NATIONAL LABORATORY
FACILITIES DIVISION

		DATE
DRAWN BY	AD	11/13/2006
CHECKED BY	LDD	11/13/2006
APPROVED BY	MCD	11/13/2006
CAD FILE PATH	00021614	
SCALE	Full	
DRAWING NO.	4B04E027	SHEET
PROJECT NO.	FB4010	1 OF 1