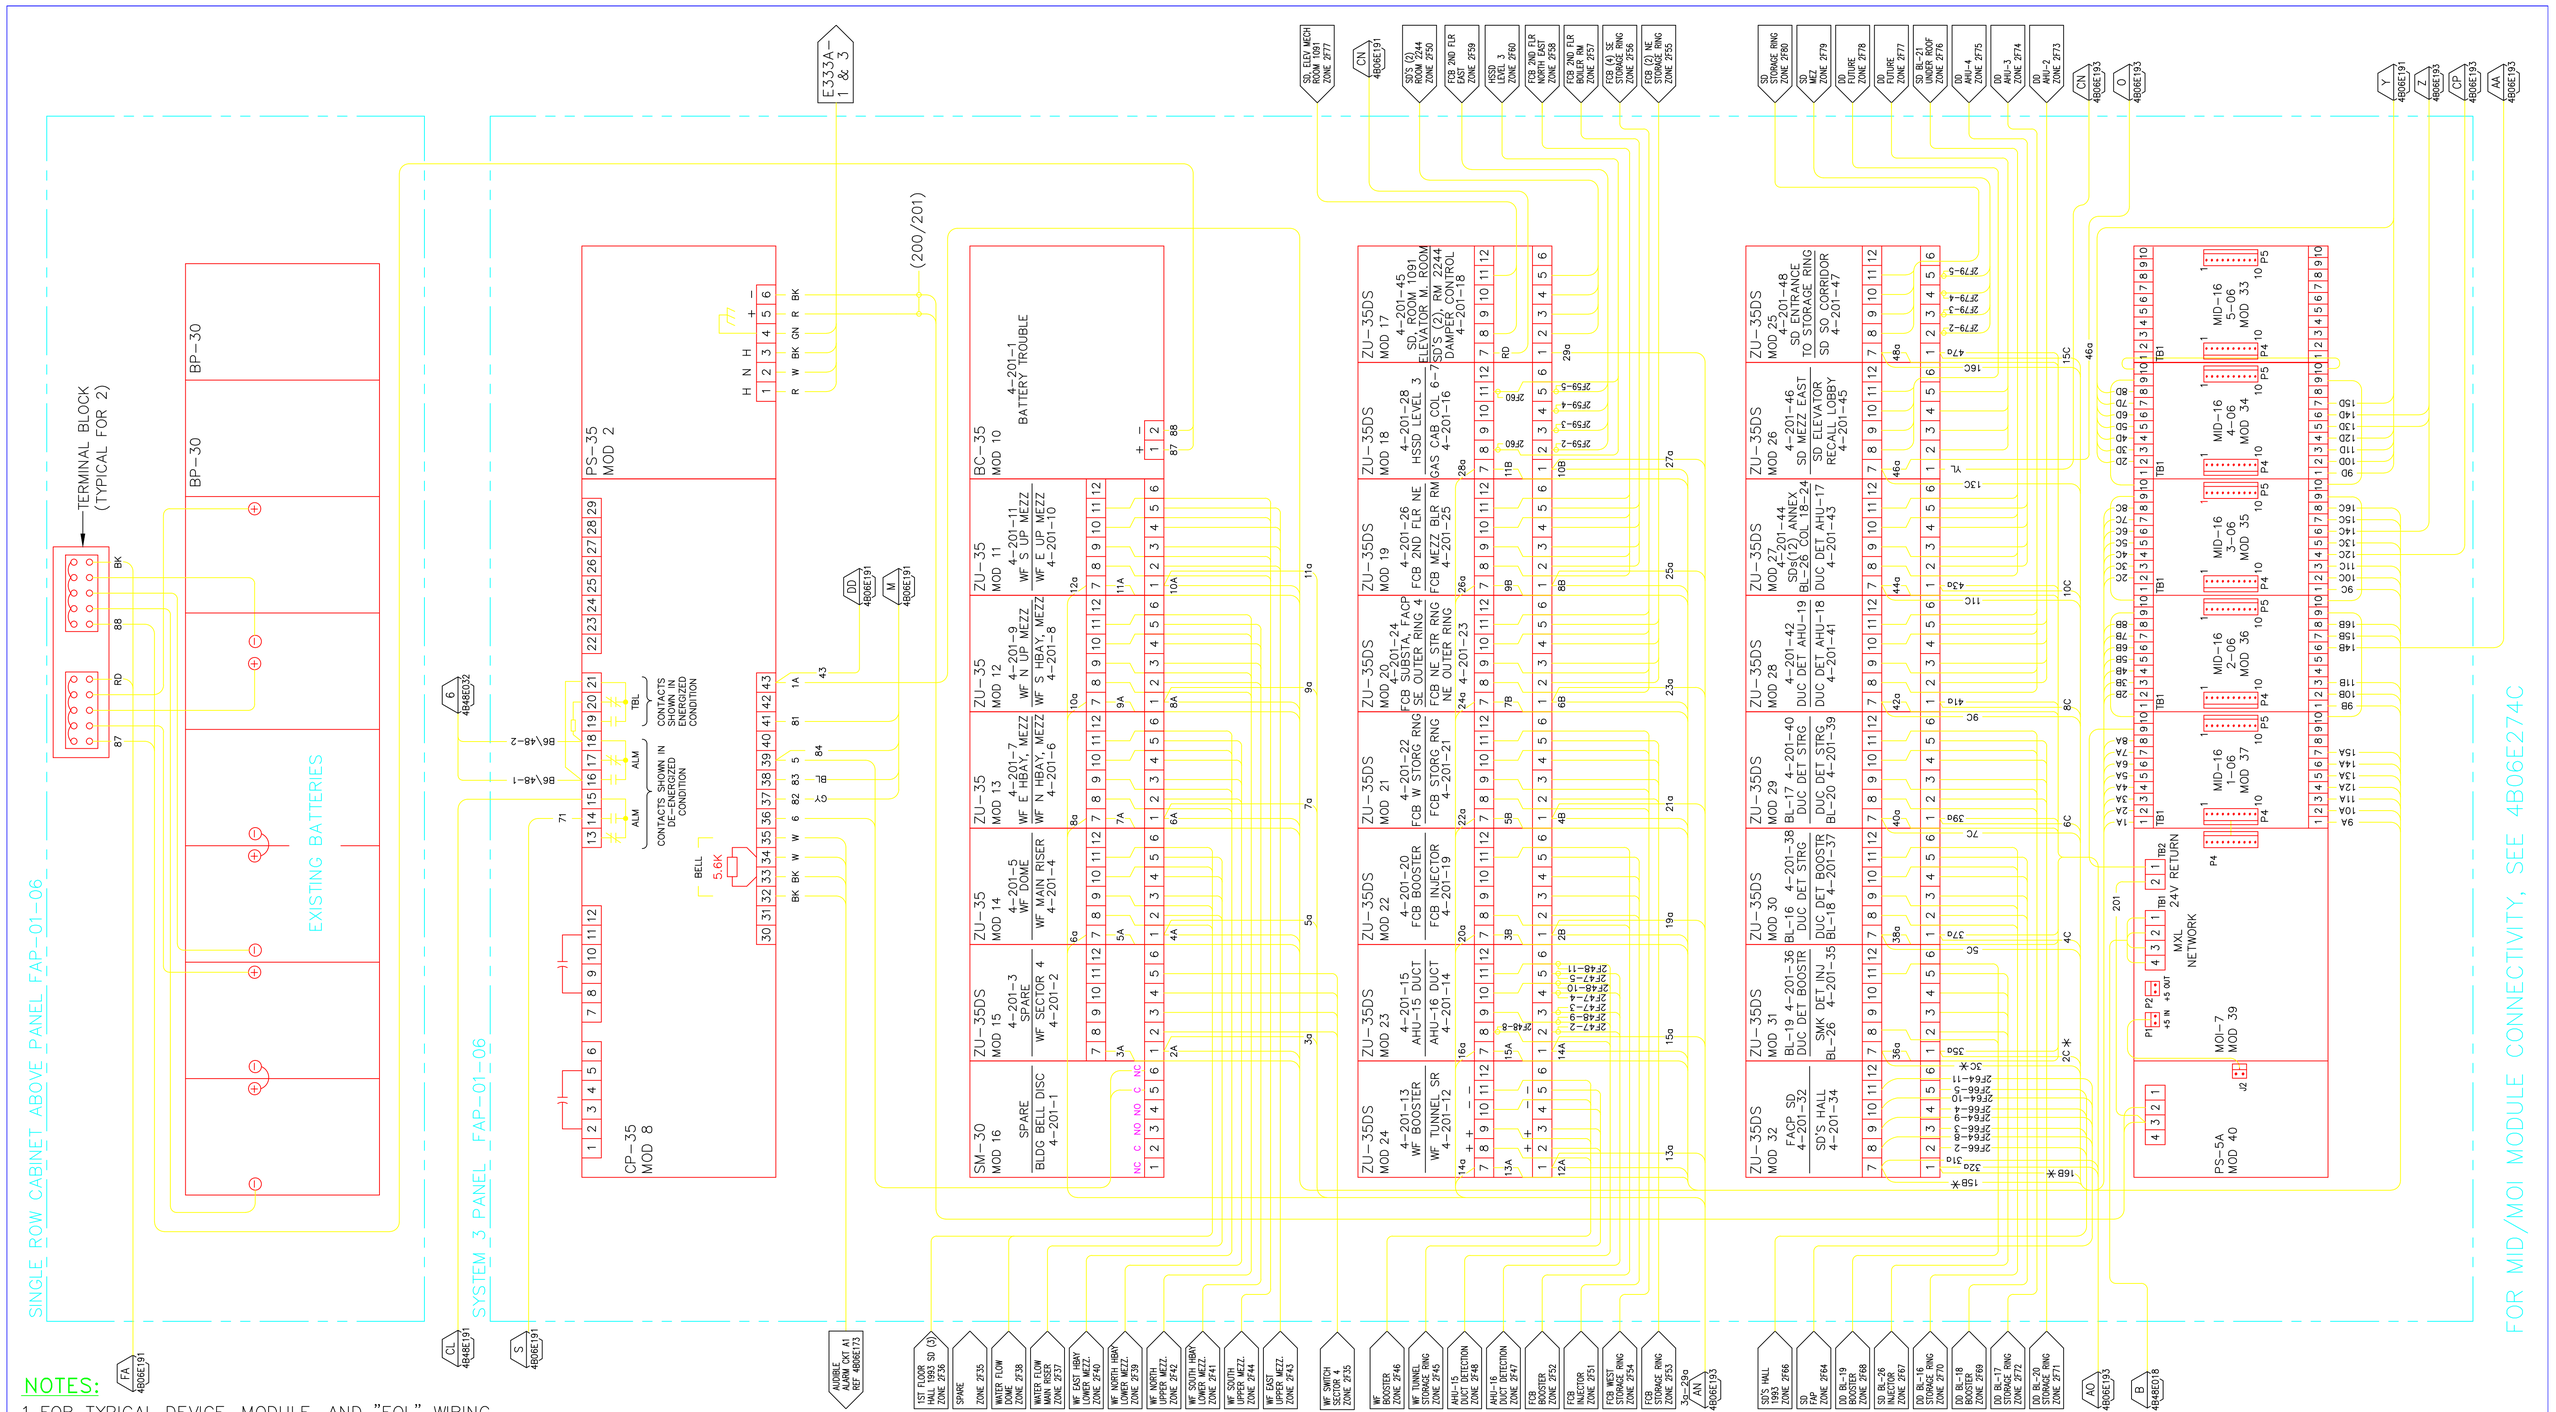

NOTES:

1. FOR TYPICAL DEVICE, MODULE, AND "EOL" WIRING, SEE STANDARD FIRE ALARM DRAWINGS 4BSTE002 AND 4BSTE041 THROUGH 4BSTE051.

LEGEND:

* WIRE NOT CONNECTED

** DESTINATION UNKNOWN (FIELD TO VERIFY)

REFERENCE DRAWINGS

4B06E191	INTERCONNECTION DIAGRAM
4B06E193	DM-31, SR-35, PM-32 CONN
4B48E018	MXL & BUILDING LOOP DIAGRAM
4B06E274	MOI/MID MODULE ARRANGEMENT

ASBUILT

04/24/13

REVISION NUMBER	DRAWN BY	CHECKED BY	APPR'D BY	DATE	REMARKS
I	LDD	LDD	MCD	04/24/13	AS-BUILT PER FIELD VERIFICATIONS
H	AD	MCG	MCG	12/12/05	AS-BUILT RECORD DRAWING
G	AD	MCG	MCG	4/01/05	REVISED FOR DIGITIZE SYSTEM
F	AD	MCG	MCG	9/19/03	AS-BUILT, FIRE ALARM PHASE I UPGRADE
E	DWH	BBT	BBT	7/26/02	SD. EXPANSION PROJ CONFORMED SET
D	HYT	HYT	–	-	SOUTH EXPANSION PROJECT
C	HYT	HYT	–	-	REPLACEMENT FIRE ALARM PROJECT

PROFESSIONAL SEAL (IF REVISION, APPLIES ONLY TO REVISED WORK)

ISSUE (PROGRESS, ESTIMATE, BID, CONSTRUCTION, CONFORMED, REVISION, RECORD)

06 FIRE ALARM SYSTEM

SYSTEM 3 PANEL FAP-01-06

INTERCONNECTION DIAGRAM

UNIVERSITY OF CALIFORNIA
LAWRENCE BERKELEY NATIONAL LABORATORY
FACILITIES DIVISION

		DATE
DRAWN BY	ZLM	5/15/1997
CHECKED BY	PAT	5/15/1997
APPROVED BY	MLS	5/15/1997
CAD FILE PATH		
SCALE	NONE	
DRAWING NO.	4B06E190I	SHEET 1 OF 1
PROJECT NO.	FM8610	