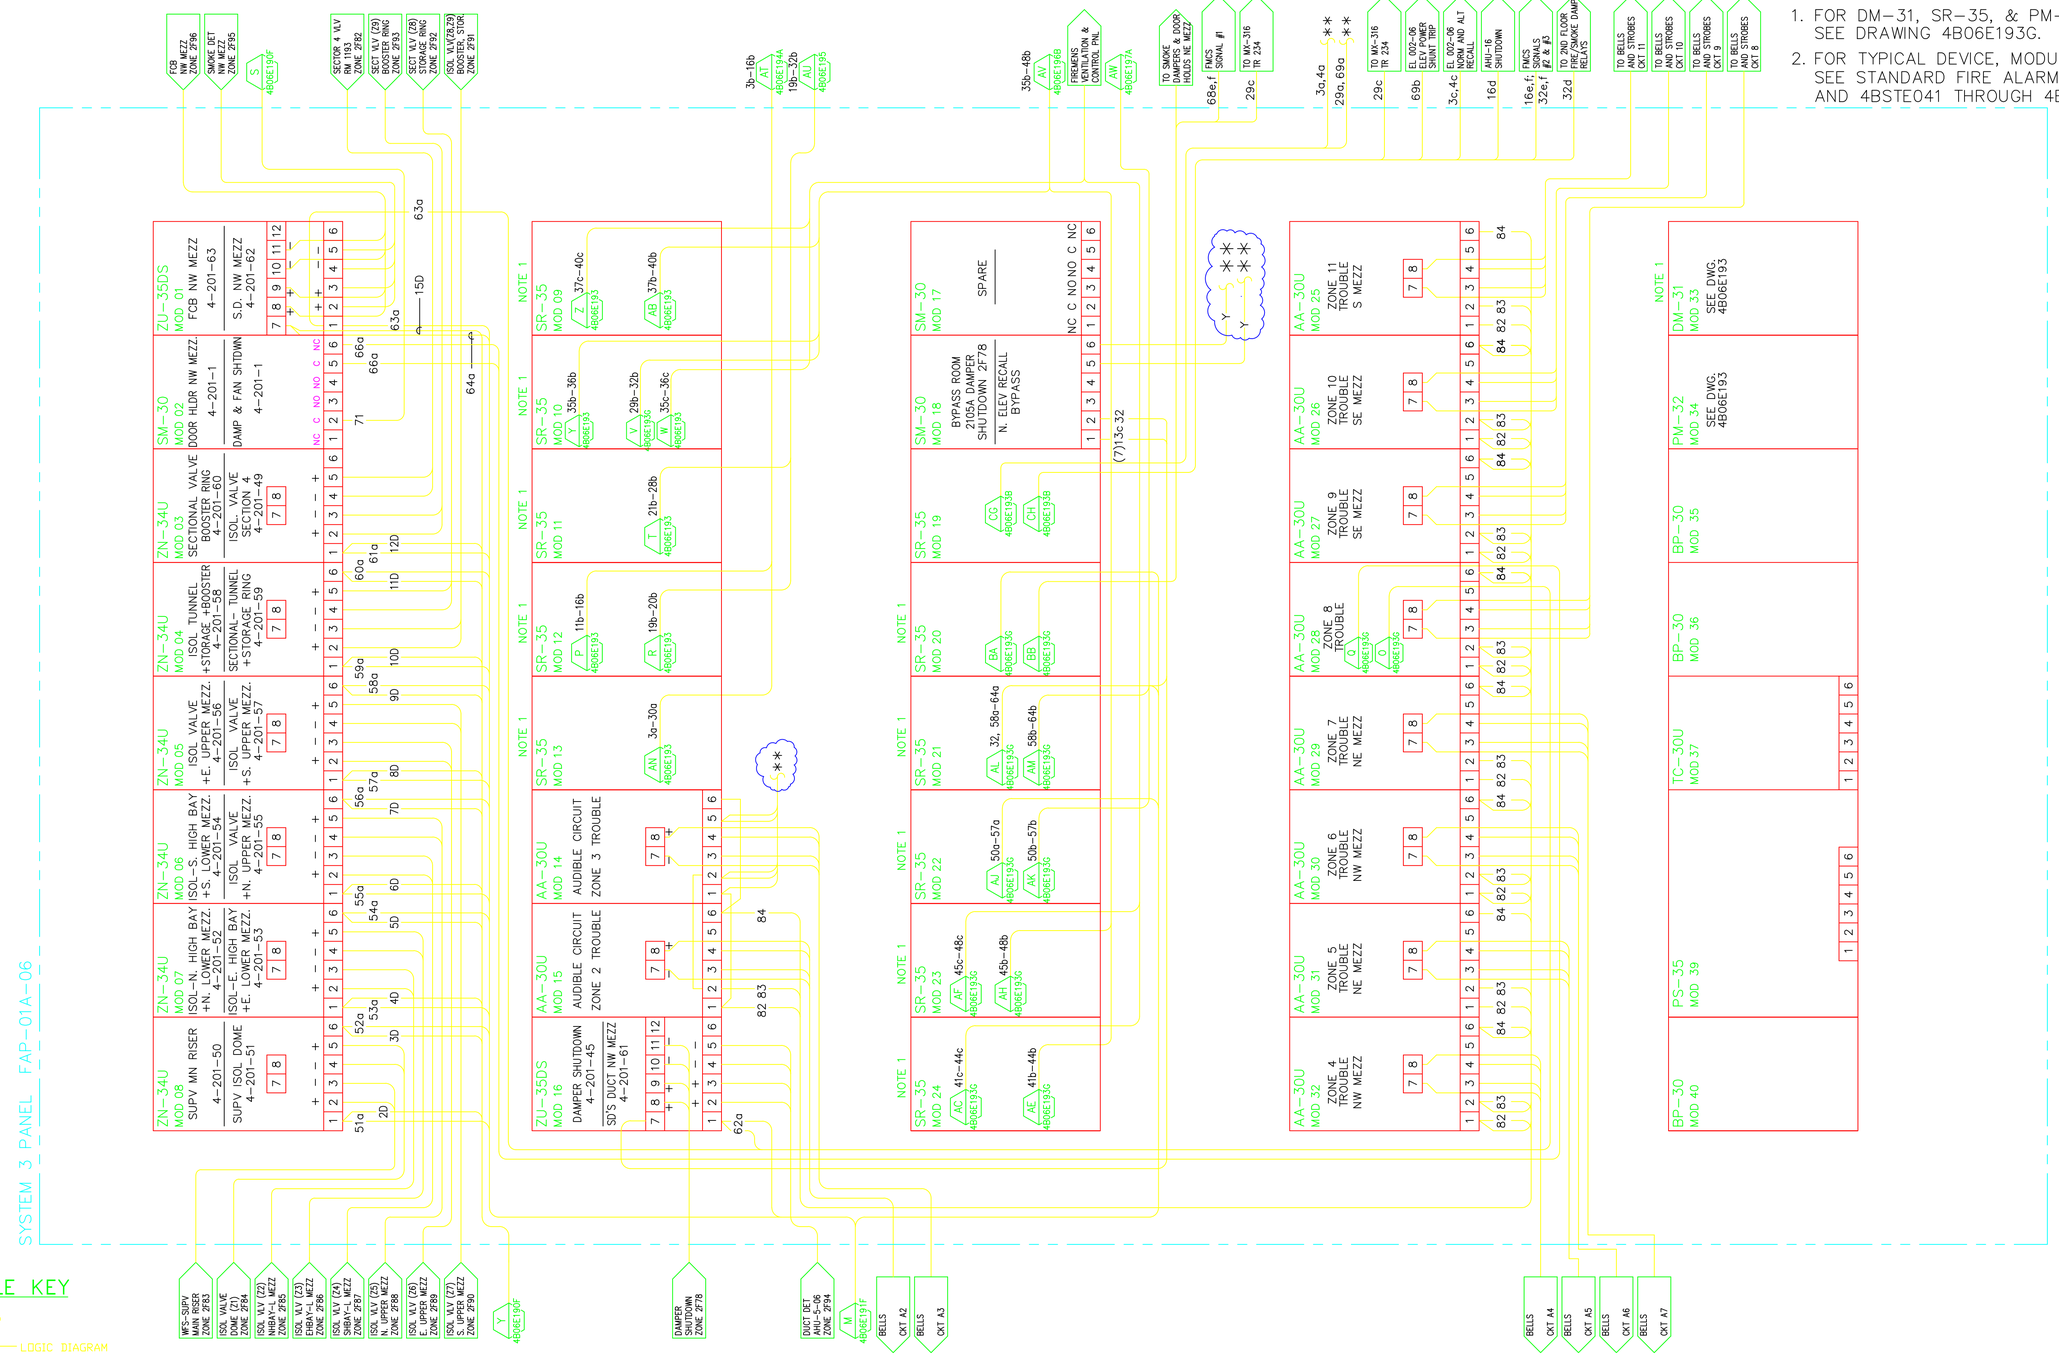

NOTES:

1. FOR DM-31, SR-35, & PM-32, MODULES, SEE DRAWING 4B06E193G.
2. FOR TYPICAL DEVICE, MODULE, AND "EOL" WIRING, SEE STANDARD FIRE ALARM DRAWINGS 4BSTE002 AND 4BSTE041 THROUGH 4BSTE051.

MODULE KEY

MOD 32 (18)
- LOGIC DIAGRAM REFERENCE
- LOCATION IN SYSTEM 3 PANEL

LEGEND:

* WIRE NOT CONNECTED
** DESTINATION UNKNOWN

ASBUILT REVISION F 9/19/2003

PROFESSIONAL SEAL (IF REVISION, APPLIES ONLY TO REVISED WORK)

ISSUE (PROGRESS, ESTIMATE, BID, CONSTRUCTION, CONFORMED, REVISION, RECORD)

REVISION NUMBER	DRAWN BY	CHECKED BY	APPR'D BY	DATE	REMARKS
F	AD	MCG	MCG	9/19/03	AS-BUILT, FIRE ALARM PHASE I UPGRADE
E	DWH	BBT	BBT	7/26/02	SOUTH EXPANSION PROJECT CONFORMED SET
D	HYT	HYT	–	5/23/02	REPLACEMENT FIRE ALARM PROJECT
C	HYT	HYT	–	–	REPLACEMENT FIRE ALARM PROJECT
B	RDB	MCG	MCG	4/10/00	AS-BUILT 2105A FIRE DAMPERS
A	RDB	–	–	01/21/96	ISSUED FOR FIELD VERIFICATION

06 FIRE ALARM SYSTEM
SYSTEM 3 PANEL FAP-01A-06
INTERCONECTION DIAGRAM

UNIVERSITY OF CALIFORNIA
LAWRENCE BERKELEY NATIONAL LABORATORY
FACILITIES DIVISION

DRAWN BY ZLM	DATE 5/7/1997	
CHECKED BY PAT	5/7/1997	
APPROVED BY MSL	5/7/1997	
CAD FILE PATH 00016559		
SCALE NTS		
DRAWING NO. 4B06E191F	SHEET E96	
PROJECT NO. FM8610	1 OF 1	