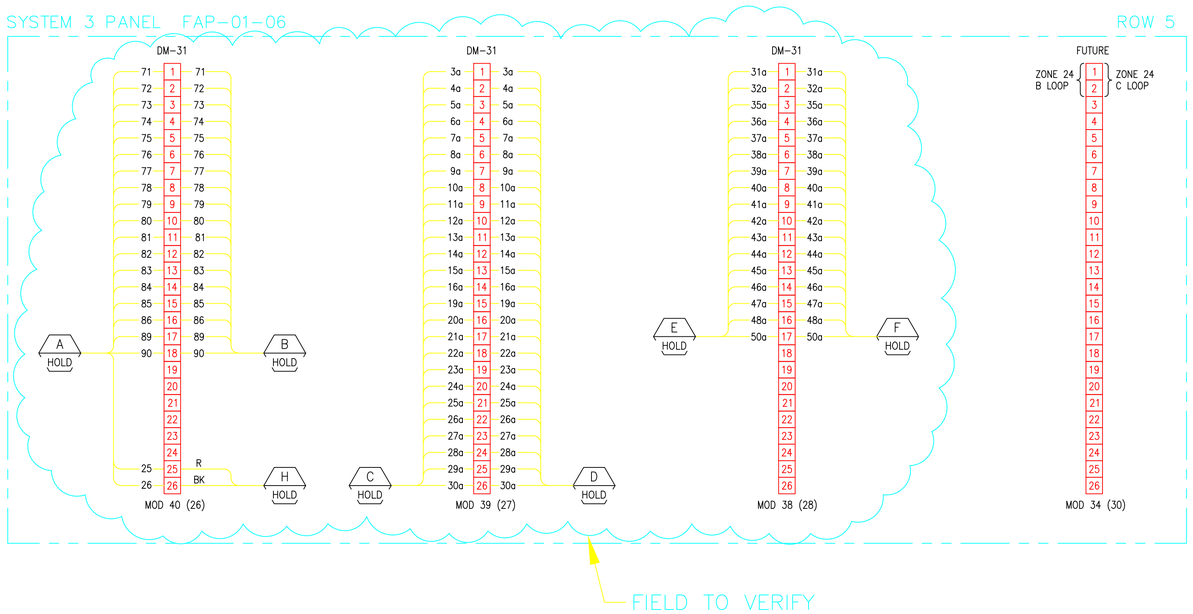

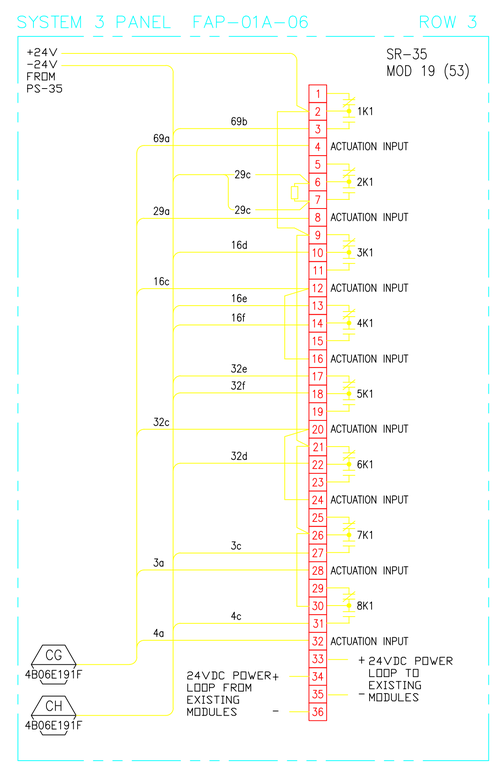

	ASBUILT REVISION C 9/19/2003	C	MRC	MCG	MCG	09/19/03	AS-BUILT, FIRE ALARM PHASE I UPGRADE
		B				11/6/01	AS-BUILT RECORD DWGS PER CONST. MARKUPS
		A	RDB	MCG	MCG	4/10/00	AS-BUILT
PROFESSIONAL SEAL (IF REVISION, APPLIES ONLY TO REVISED WORK)	ISSUE (PROGRESS, ESTIMATE, BID, CONSTRUCTION, CONFORMED, REVISION, RECORD)	REVISION NUMBER	DRAWN BY	CHECKED BY	APPR'D BY	DATE	REMARKS

06 FIRE ALARM SYSTEM
SYSTEM 3 PANEL FAP-01-06
DM-31 CONNECTION DIAGRAM

UNIVERSITY OF CALIFORNIA
LAWRENCE BERKELEY NATIONAL LABORATORY
FACILITIES DIVISION

DRAWN BY	RDB	DATE 5/7/1997
CHECKED BY	MCG	5/15/1997
APPROVED BY	MCG	5/15/1997
CAD FILE PATH	00015820	
SCALE	As Noted	
DRAWING NO.	4B06E192C	SHEET E3
PROJECT NO.	FM8610	1 OF 1