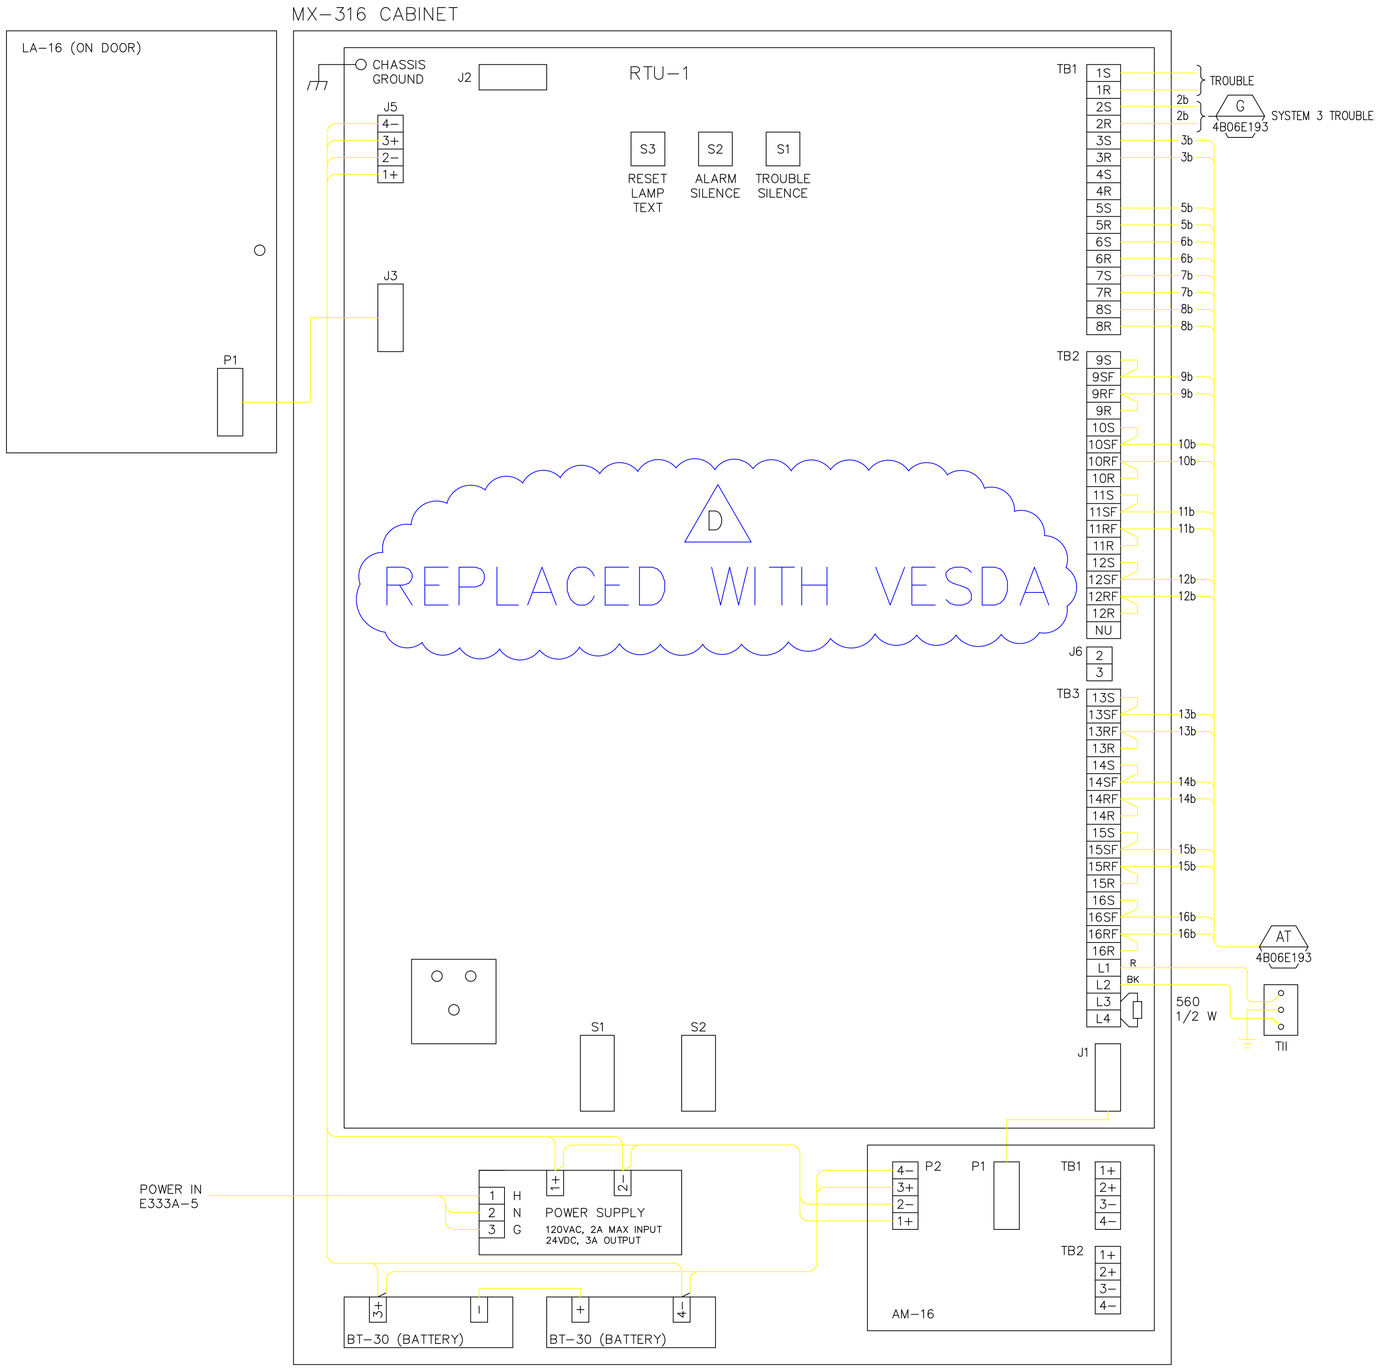


## REFERENCE DRAWINGS

| | |
|---|---|
| 4B06E191 | INTERCONNECTION DIAGRAM |
| 4B06E193 | DM-31, SR-35,PM-32 CONNECTION |

| REVISION NUMBER | DRAWN BY | CHECKED BY | APPR'D BY | DATE | REMARKS |
|---|---|---|---|---|---|
| D | LDD | LDD | MCD | 04/24/13 | AS BUILT PER FIELD VERIFICATIONS |
| C | AD | MCG | MCG | 04/06/05 | REVISED SYSTEM 3 WIRING FOR DIGITIZE SYSTEM |
| B | AD | MCG | MCG | 09/19/03 | AS-BUILT, FIRE ALARM PHASE I UPGRADE |
| A | ROB | – | – | 6/6/97 | ISSUED FOR FIELD VERIFICATION |

06 FIRE ALARM SYSTEM
MX-316 TERMINATIONS
TRANSMITTER #233

UNIVERSITY OF CALIFORNIA LAWRENCE BERKELEY LABORATORY
FACILITIES DEPARTMENT

| | | |
|---|---|---|
| DRAWN BY | LM | DATE 5/7/1997 |
| CHECKED BY | ROB | 5/15/1997 |
| APPROVED BY | | 5/24/2001 |
| CAD FILE PATH | | |
| SCALE | NONE | |
| DRAWING NO. | 4B06E194D | SHEET |
| PROJECT NO. | 120960 | 1 OF 1 |