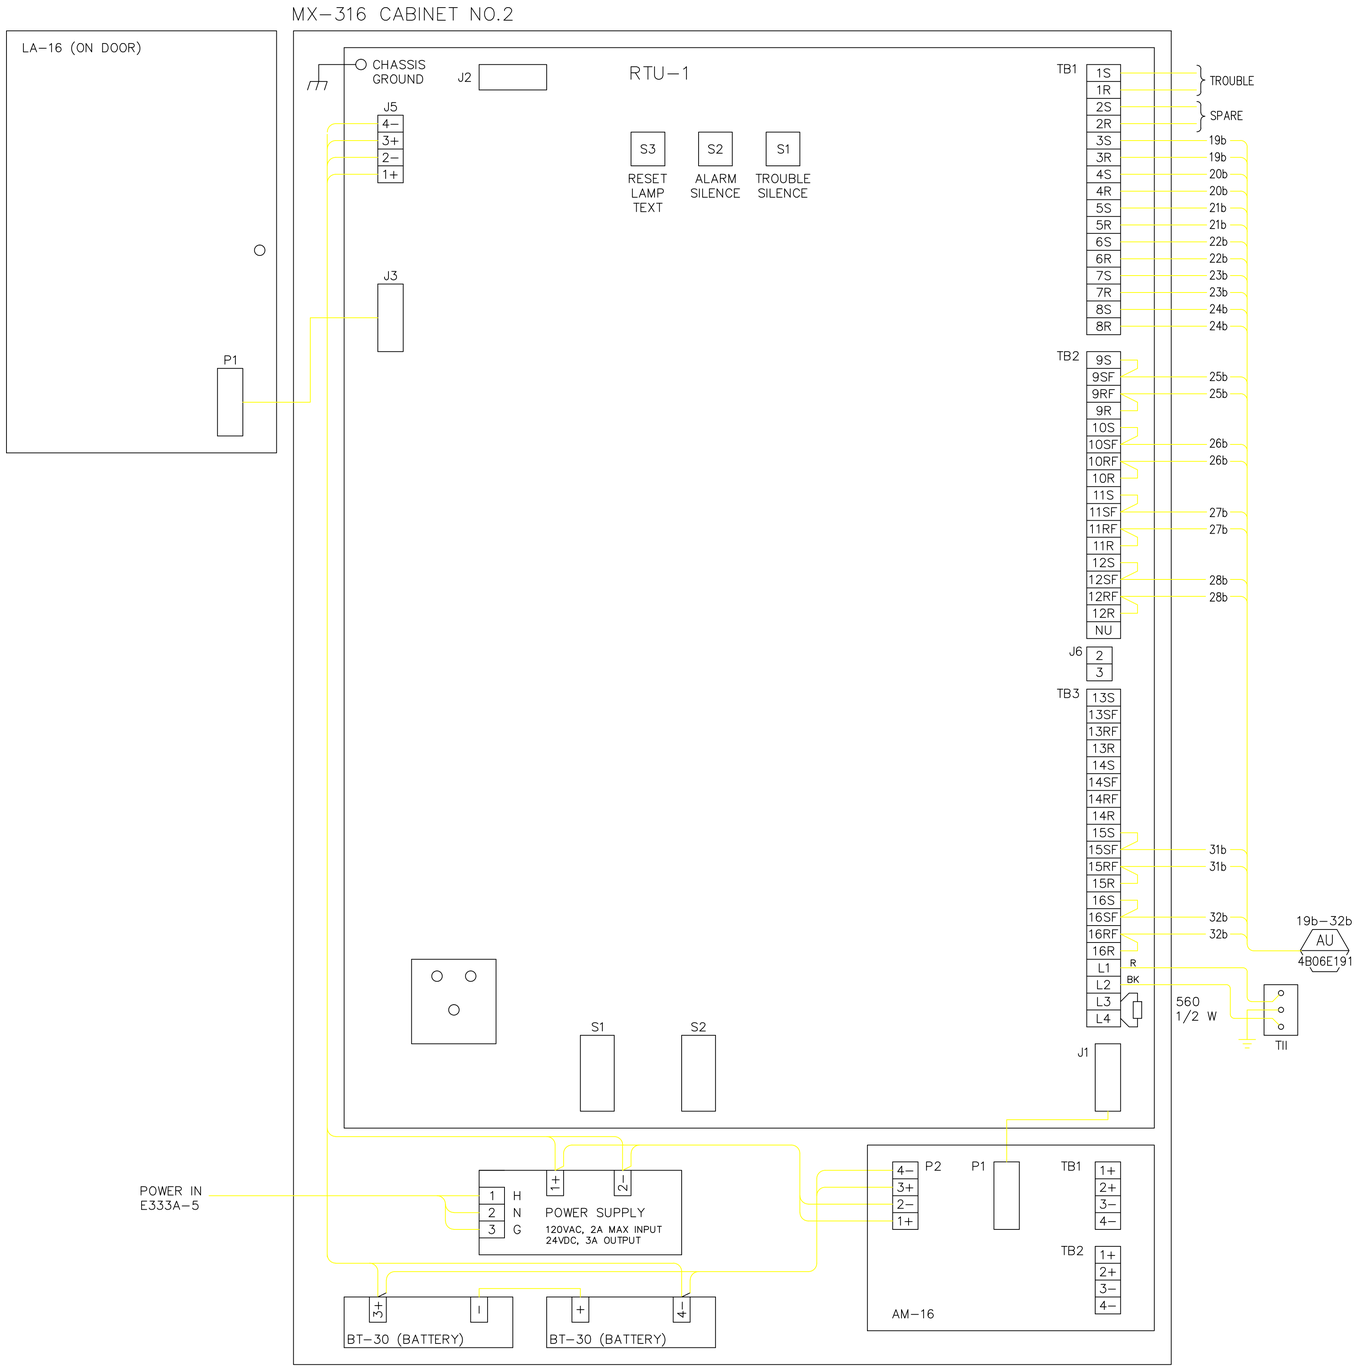

REFERENCE DRAWINGS

4B06E191F INTERCONNECTION DIAGRAM

REVISION NUMBER	DRAWN BY	CHECKED BY	APPR'D BY	DATE	REMARKS
B	AD	MCG	MCG	09/19/03	AS-BUILT, FIRE ALARM PHASE I UPGRADE
A	ROB	–	–	6/6/97	ISSUED FOR FIELD VERIFICATION

06 FIRE ALARM SYSTEM
MX-316 TERMINATIONS
TRANSMITTER #234

UNIVERSITY OF CALIFORNIA LAWRENCE BERKELEY LABORATORY
FACILITIES DEPARTMENT

DRAWN BY LM	DATE 5/7/1997	
CHECKED BY ROB	5/15/1997	
APPROVED BY	5/24/2001	
CAD FILE PATH 00015817		
SCALE NONE		
DRAWING NO. 4B06E195B	SHEET E6	
PROJECT NO. 120960	1 OF 1	