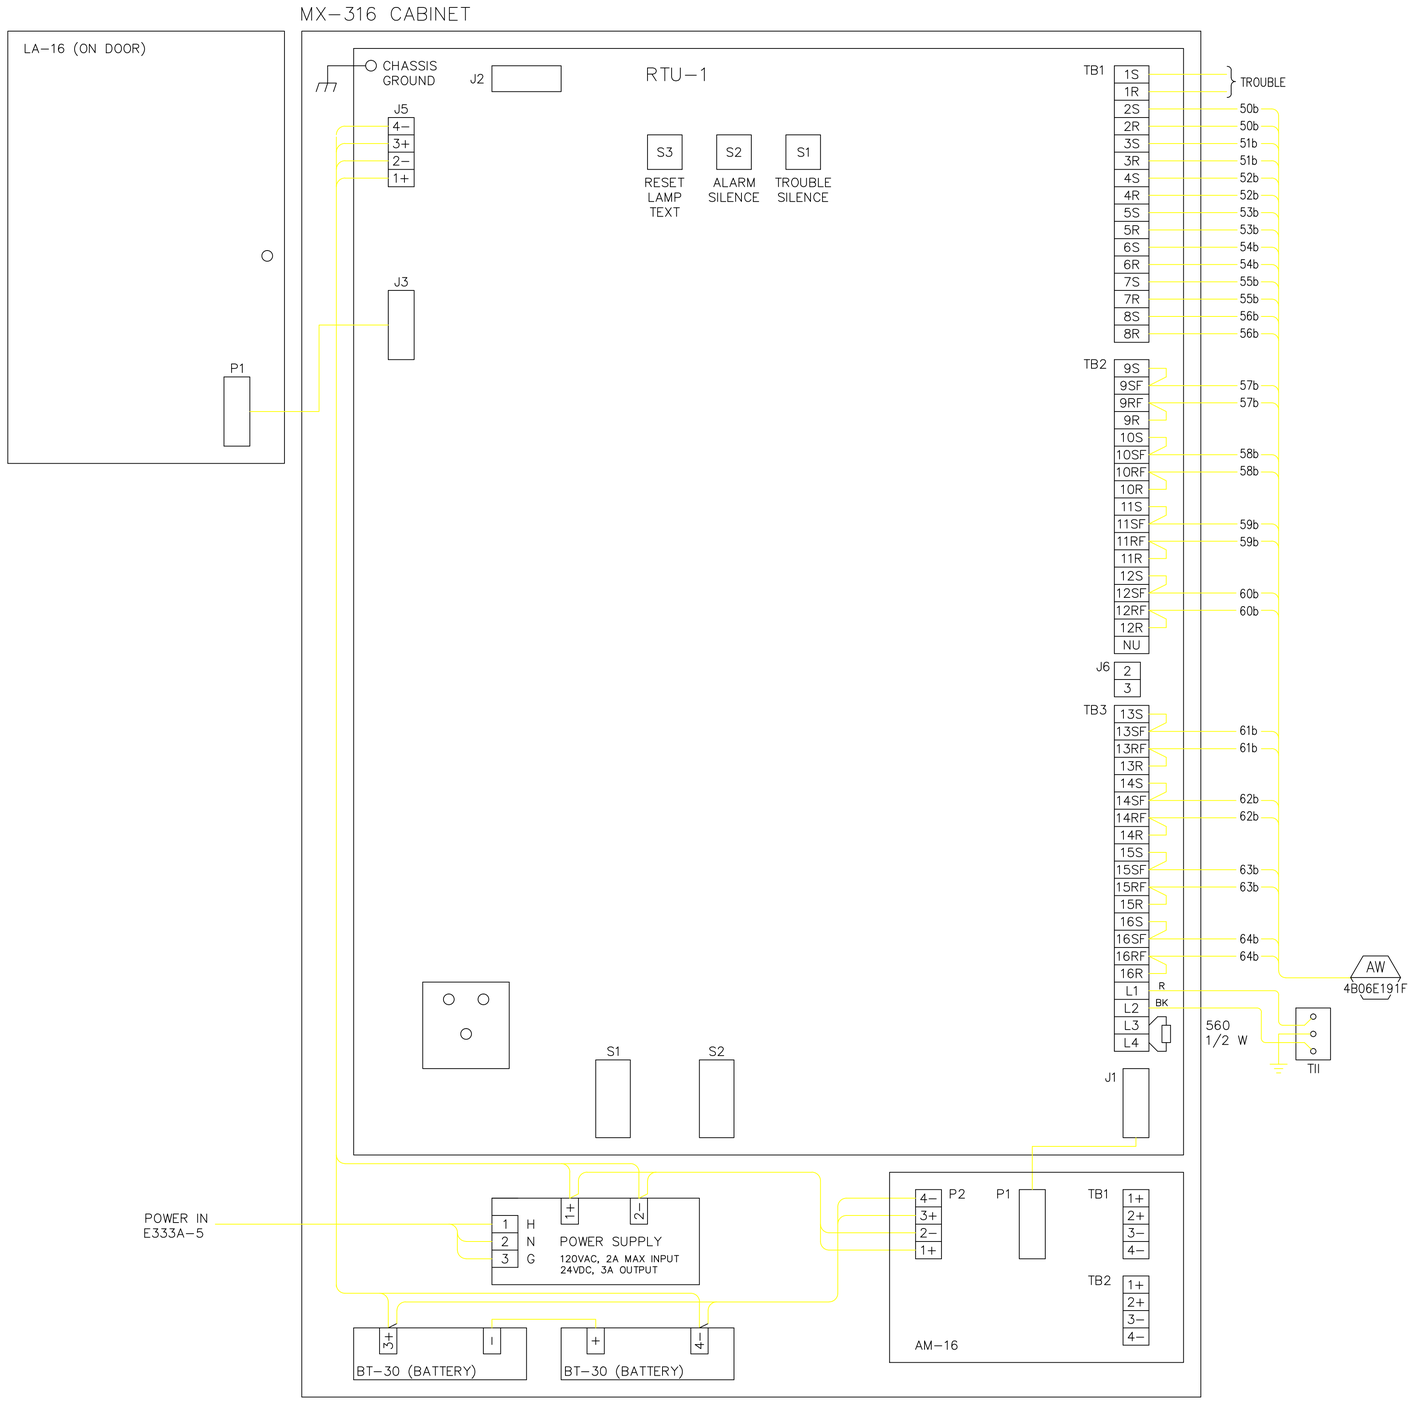

REFERENCE DRAWINGS

4B06E191F INTERCONNECTION DIAGRAM

REVISION NUMBER	DRAWN BY	CHECKED BY	APPR'D BY	DATE	REMARKS
B	AD	MCG	MCG	09/19/03	AS-BUILT, FIRE ALARM PHASE I UPGRADE
A	ROB	–	–	06/06/97	ISSUED FOR FIELD VERIFICATION

06 FIRE ALARM SYSTEM
MX-316 TERMINATIONS
TRANSMITTER # 236

UNIVERSITY OF CALIFORNIA LAWRENCE BERKELEY LABORATORY
FACILITIES DEPARTMENT

DRAWN BY	ROB	DATE 5/7/1997
CHECKED BY	MCG	5/15/1997
APPROVED BY		
CAD FILE PATH	00001930	
SCALE	As Noted	
DRAWING NO.	4B06E197B	SHEET E8
PROJECT NO.	120960	1 OF 1