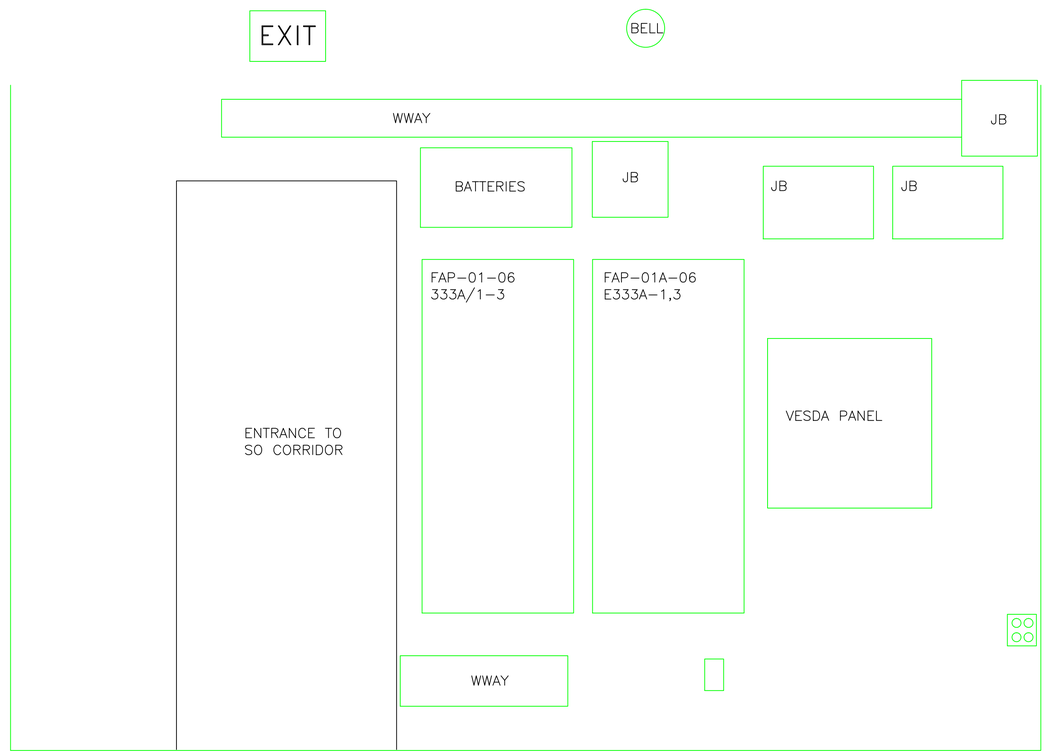

SOUTH ELEVATION

SCALE: 1"=1'-0"

1' 0 1' 2'

SCALE: 1" = 1'-0"

REVISION NUMBER	DRAWN BY	CHECKED BY	APPR'D BY	DATE	REMARKS
B	LDD	LDD	MCD	03/28/13	FIELD VERIFIED AS-BUILT
A	ROB	MCG	MCG	11/09/98	AS-BUILT

06 FIRE ALARM SYSTEM
PANEL LAYOUT
ELEVATIONS

UNIVERSITY OF CALIFORNIA LAWRENCE BERKELEY LABORATORY
FACILITIES DEPARTMENT

DRAWN BY	ROB	DATE 5/7/1997
CHECKED BY	MCG	5/15/1997
APPROVED BY	MCG	5/15/1997
CAD FILE PATH		
SCALE	As Noted	
DRAWING NO.	4B06E198B	SHEET E9
PROJECT NO.	120960	