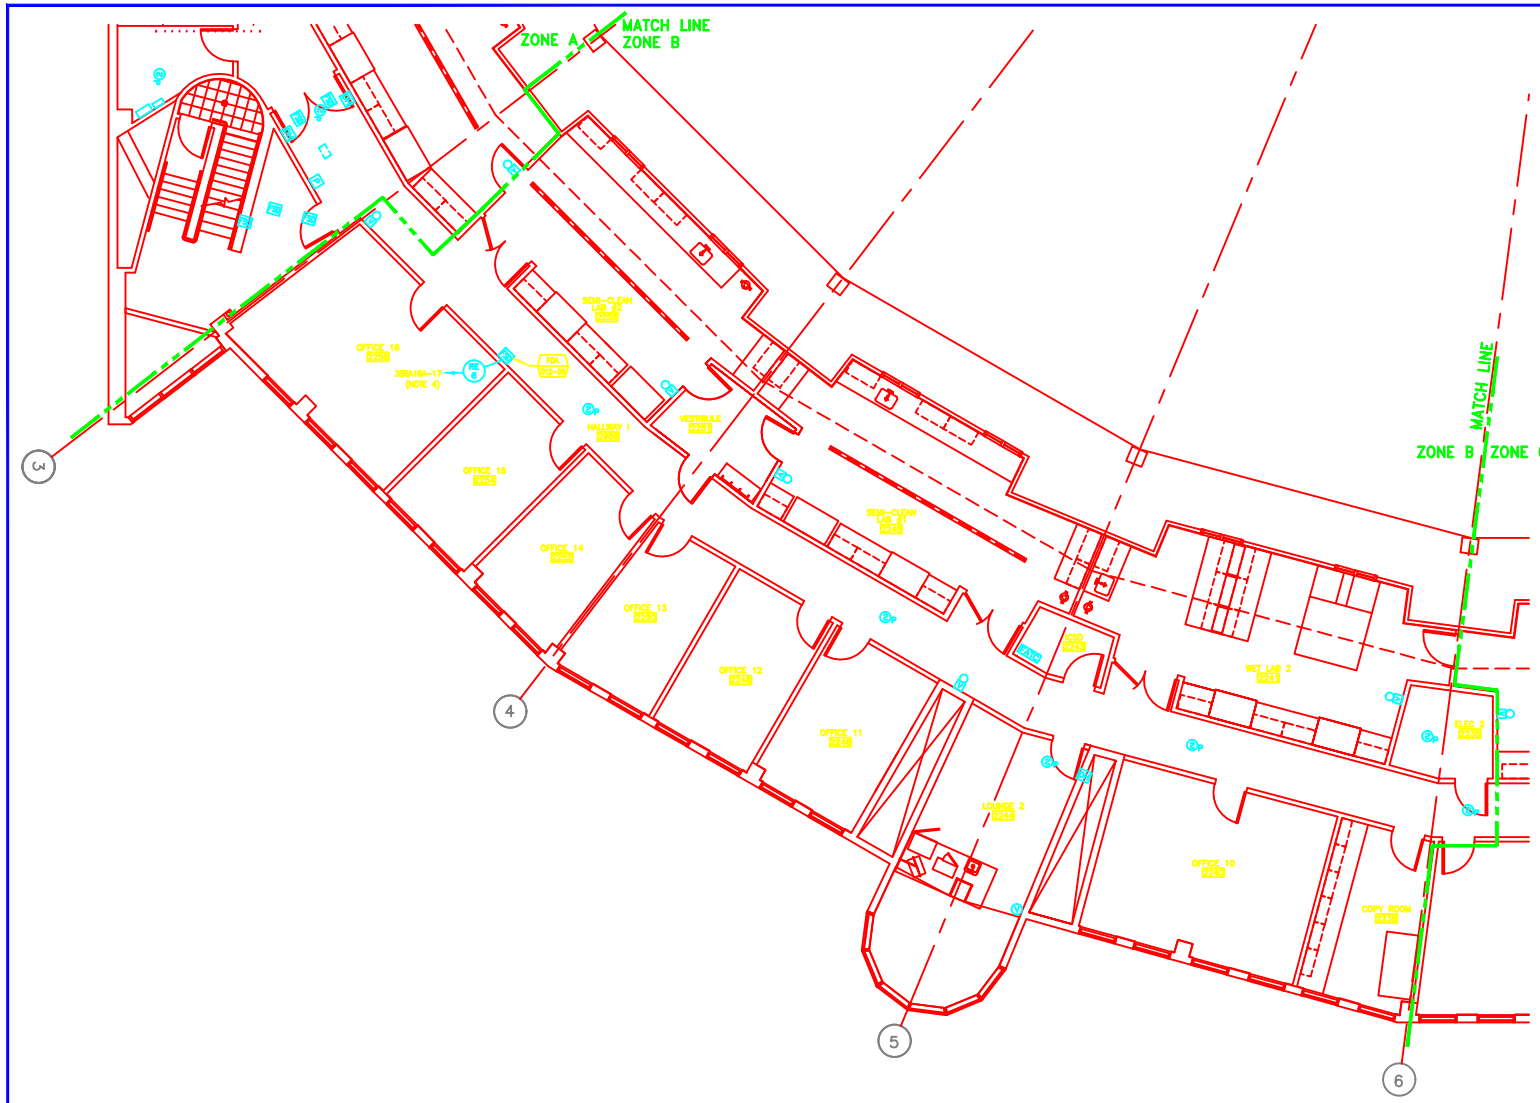

NOTES:

1. CONTRACTOR SHALL COORDINATE FIRE ALARM CONDUIT INSTALLATION WITH ELECTRICAL POWER AND ICS SYSTEM CONDUIT ROUTING TO AVOID INTERFERENCES. PROVIDE SEISMIC BRACING OF FIRE ALARM CONDUITS PER SPECIFICATION 01900 "LATERAL FORCE ANCHORAGE PROVISIONS".
2. SEE LEGEND, ABBREVIATIONS AND NOTES ON SHEET E01 FOR FIRE ALARM DEVICE MOUNTING REQUIREMENTS.
3. FOR RELOCATION OF EXISTING FIRE ALARM CONDUITS, SEE SHEET E12.
4. SEE SHEET E81 FOR FIRE ALARM WIRING AND RISER DIAGRAMS.

GENERAL NOTES

CONTRACTOR IN CONSTRUCTING INDIVIDUAL BID SCOPE OF WORK SHALL CONSIDER AND MAKE PROVISIONS FOR FUTURE CONSTRUCTION.

Eichleay
Engineers Inc. of California
1390 Willow Pass Road, Suite 600, Concord, Ca. 94520
(925) 689-7000 • FAX (925) 689-7008

REVISION NUMBER	DRAWN BY	CHECKED BY	APPROVED BY	DATE	REMARKS
A				11/4/99	AS-BUILT RECORD DWGS PER CONST. MARKUPS

BUILDING 6
OFFICE & LAB BUILD-OUT
FIRE ALARM PLAN ZONE "B"

UNIVERSITY OF CALIFORNIA LAWRENCE BERKELEY LABORATORY
FACILITIES DEPARTMENT

DRAWN BY	DAS
DATE	09/26/99
CHECKED BY	
APPROVED BY	
CAD FILE PATH	00013186
SCALE	3/16"=1'-0"
DRAWING NO.	4B06E240A
SHEET	E28
PROJECT NO.	PM5610