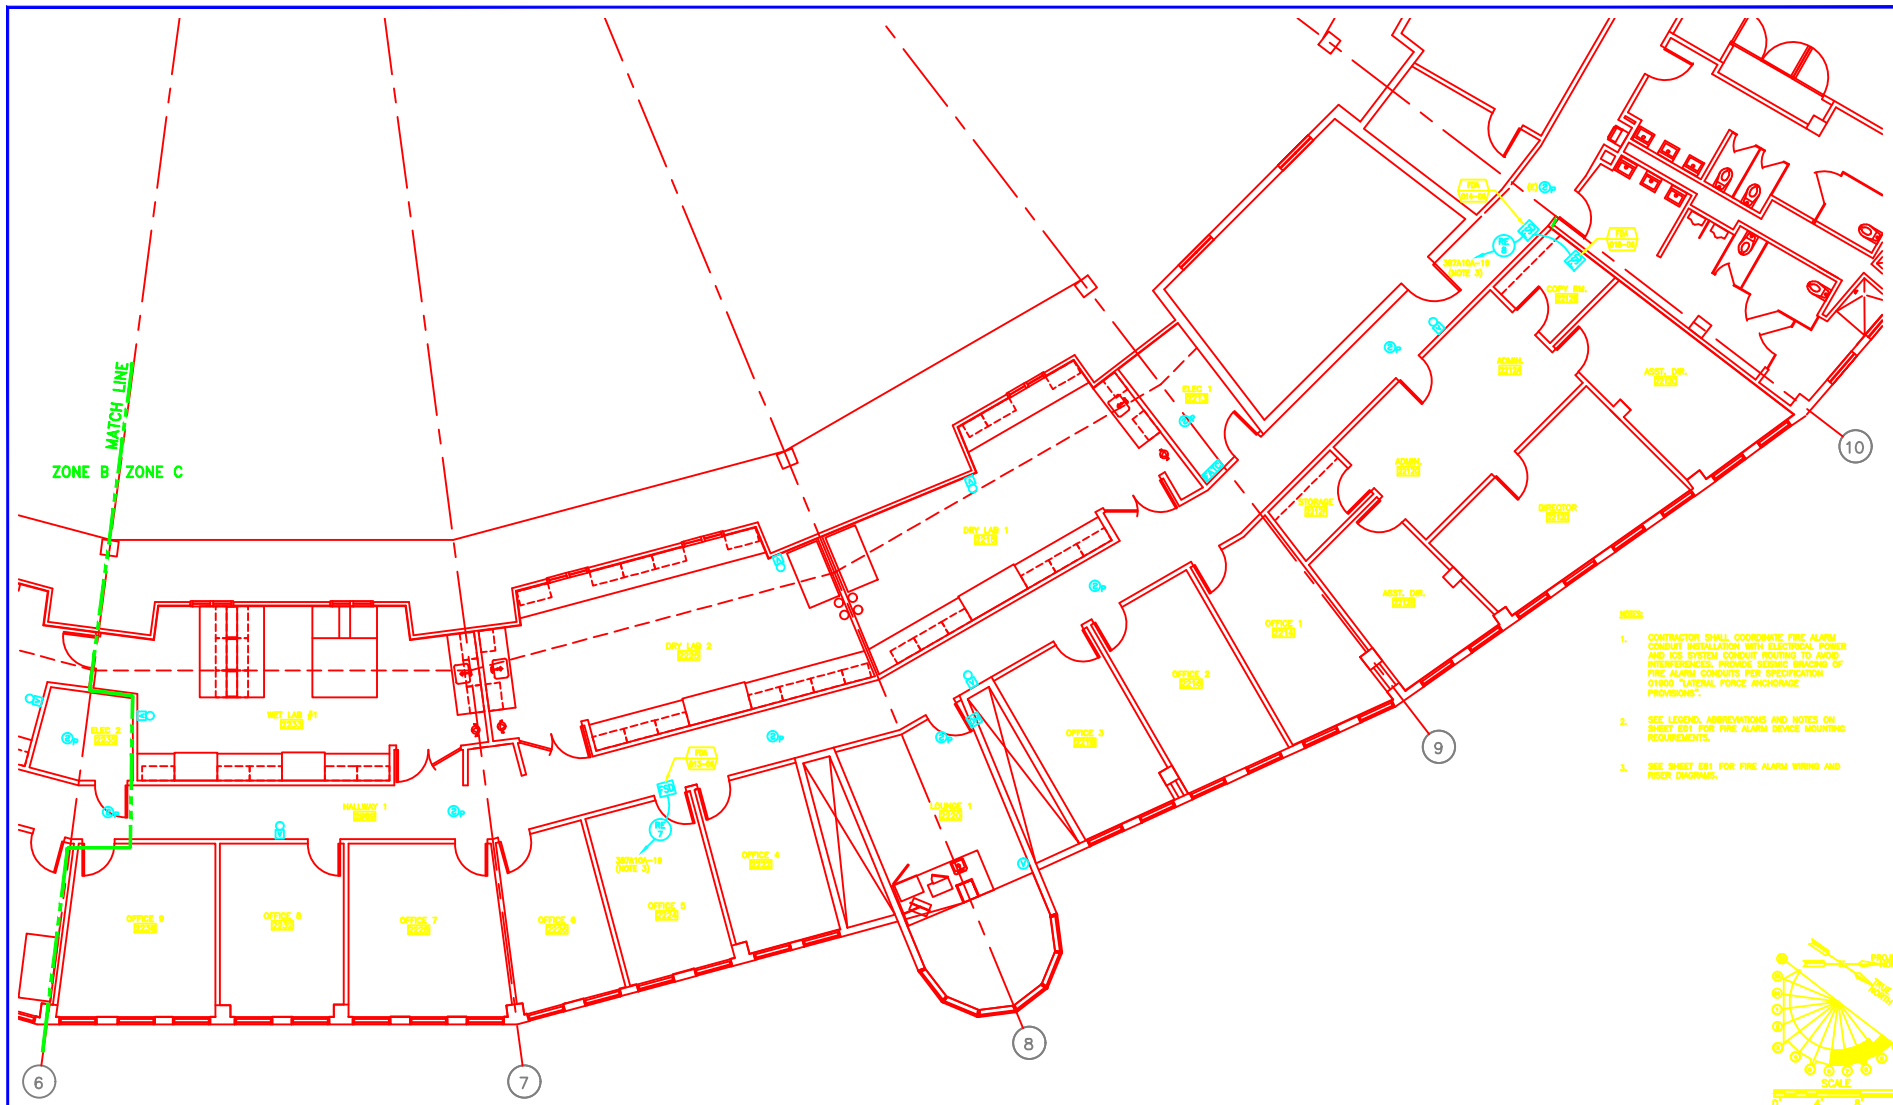

NOTES:

1. CONTRACTOR SHALL COORDINATE FIRE ALARM CONDUIT INSTALLATION WITH ELECTRICAL POWER AND ICS SYSTEM CONDUIT ROUTING TO AVOID INTERFERENCES. PROVIDE SEISMIC BRACING OF FIRE ALARM CONDUITS PER SPECIFICATION 01800 "LATERAL FORCE ANCHORAGE PROVISIONS".
2. SEE LEGEND, ABBREVIATIONS AND NOTES ON SHEET E01 FOR FIRE ALARM DEVICE MOUNTING REQUIREMENTS.
3. SEE SHEET E31 FOR FIRE ALARM WIRING AND RISER DIAGRAMS.

PROJECT NORTH
TRUE NORTH
SCALE
0' 4' 8' 12'

GENERAL NOTES

CONTRACTOR IN CONSTRUCTING INDIVIDUAL BID SCOPE OF WORK SHALL CONSIDER AND MAKE PROVISIONS FOR FUTURE CONSTRUCTION.

Eichleay Engineers Inc. of California
1390 Willow Pass Road, Suite 600, Concord, Ca. 94520
(925) 689-7000 • FAX (925) 689-7008

REVISION NUMBER	DRAWN BY	CHECKED BY	APPROVED BY	DATE	REMARKS
A				11/6/00	AS-BUILT RECORD DWGS PER CONST. MARKUPS

BUILDING 6
OFFICE & LAB BUILD-OUT
FIRE ALARM PLAN ZONE"C"

UNIVERSITY OF CALIFORNIA LAWRENCE BERKELEY LABORATORY
FACILITIES DEPARTMENT

DRAWN BY	DAS	DATE 09/26/00
CHECKED BY		
APPROVED BY		
CAD FILE PATH	00013187	
SCALE	3/16"=1'-0"	
DRAWING NO.	4B06E241A	SHEET E29
PROJECT NO.	PM5610	