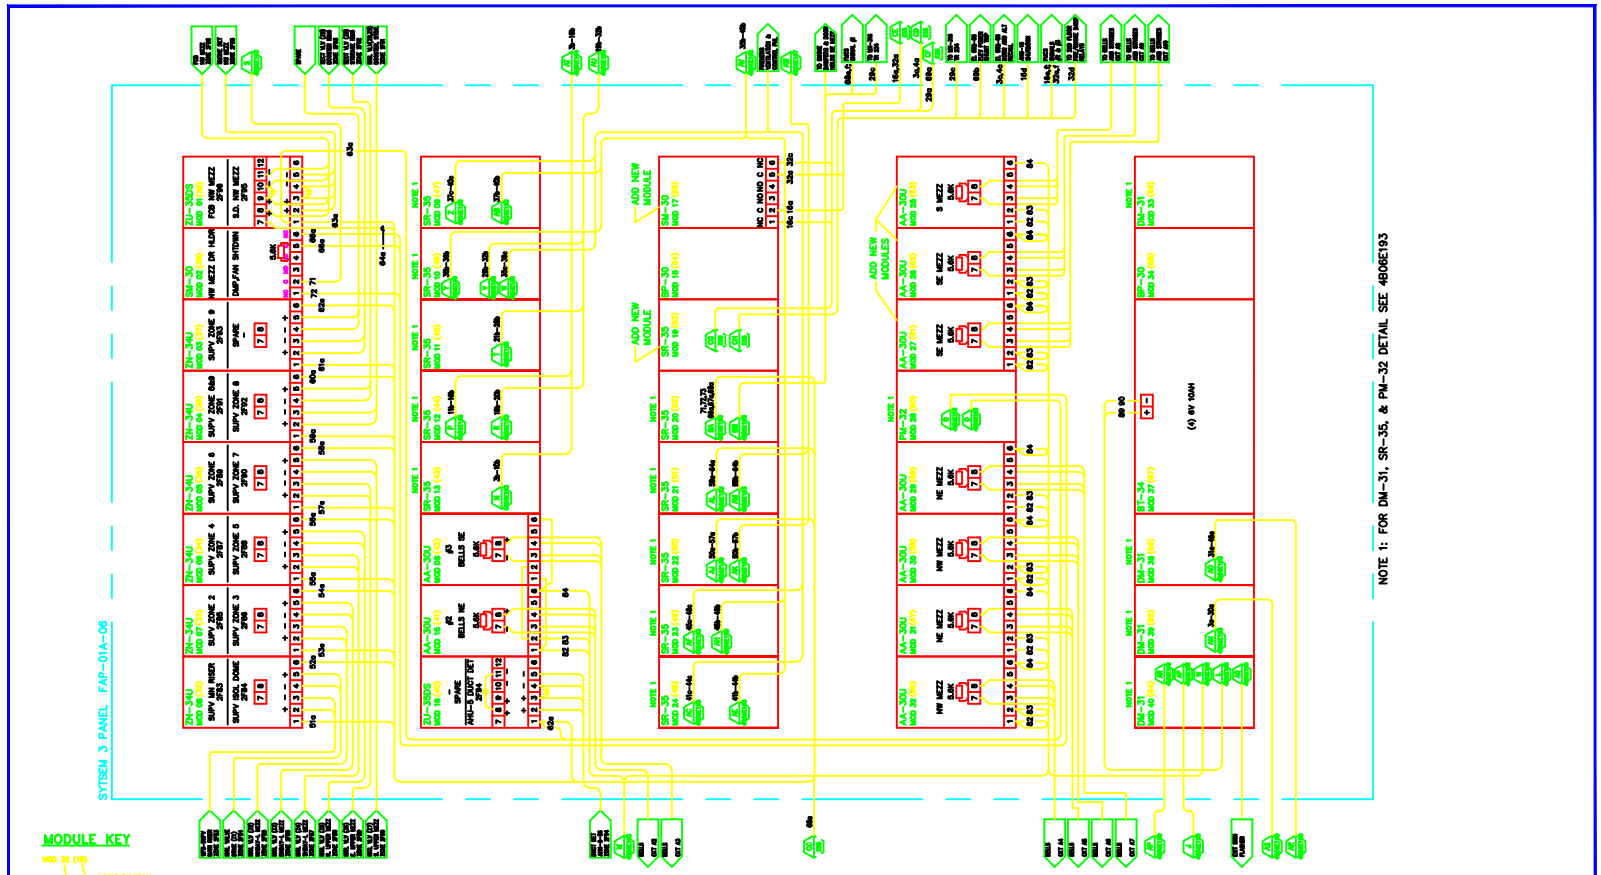

MODULE KEY

MOD 32 (16)

LOGIC DIAGRAM REFERENCE

LOCATION IN SYSTEM 3 PANEL

NOTE: THIS DRAWING WAS 4B06E191

GENERAL NOTES

CONTRACTOR IN CONSTRUCTING INDIVIDUAL BID SCOPE OF WORK SHALL CONSIDER AND MAKE PROVISIONS FOR FUTURE CONSTRUCTION.

Eichleay Engineers Inc. of California
1390 Willow Pass Road, Suite 600, Concord, Ca. 94520
(925) 689-7000 * FAX (925) 689-7006

REVISIONS	DRAWN BY	CHECKED BY	APPR'D BY	DATE	REMARKS
A					AS-BUILT RECORD DRAWN PER CONST. MANUAL

BUILDING 6
OFFICE & LAB BUILD-OUT
FIRE ALARM CONNECTION DIAG. #2

UNIVERSITY OF CALIFORNIA LAWRENCE BERKELEY LABORATORY
FACILITIES DEPARTMENT

DRAWN BY	DAS
DATE	11/18/98
CHECKED BY	
APPROVED BY	
CAD FILE PATH	00013204
SCALE	NONE
DRAWING NO.	4B06E258A
SHEET	E96
PROJECT NO.	FM9510