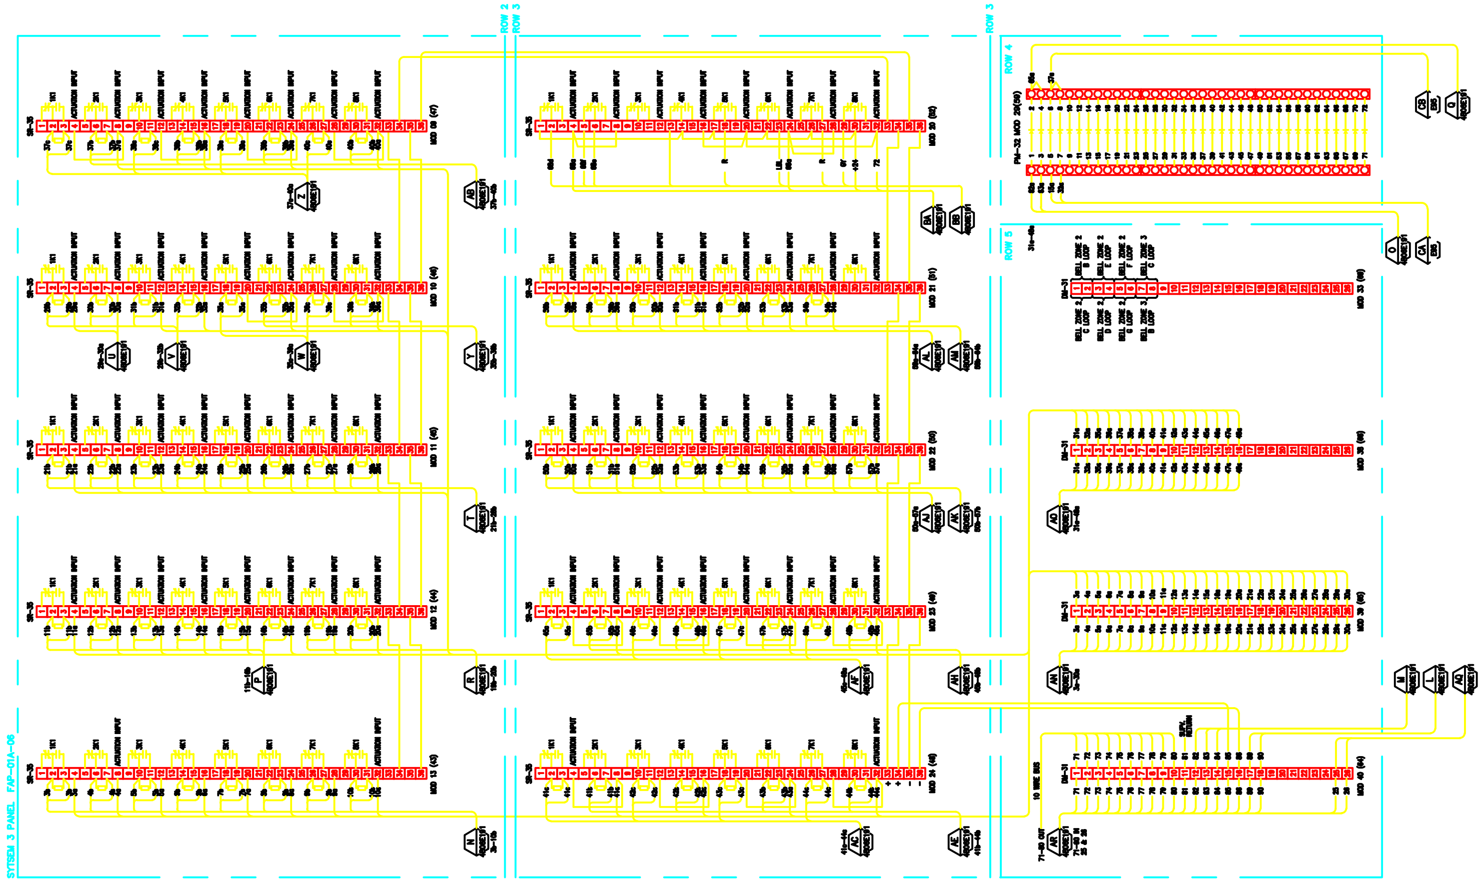

NOTE: THIS DRAWING WAS 4B06E193

MODULE KEY

GENERAL NOTES

CONTRACTOR IN CONSTRUCTING INDIVIDUAL BID SCOPE OF WORK SHALL CONSIDER AND MAKE PROVISIONS FOR FUTURE CONSTPUCTION.

Eichleay
Engineers Inc. of California
1390 Willow Pass Road, Suite 600, Concord, Ca. 94520
(925) 689-7000 * FAX (925) 689-7006

A				11/8/00	AS-BUILT RECORD DWGS PER CONST. MARKUPS
REVISION NUMBER	DRAWN BY	CHECKED BY	APPR'D BY	DATE	REMARKS

BUILDING 6
OFFICE & LAB BUILD-OUT
FIRE ALARM CONNECTION DIAG. #3

UNIVERSITY OF CALIFORNIA LAWRENCE BERKELEY LABORATORY
FACILITIES DEPARTMENT

DRAWN BY	DAS
DATE	12/18/98
CHECKED BY	
APPROVED BY	
CAD FILE PATH	00013205
SCALE	NONE
DRAWING NO.	4B06E259A
SHEET	E97
PROJECT NO.	FM6510