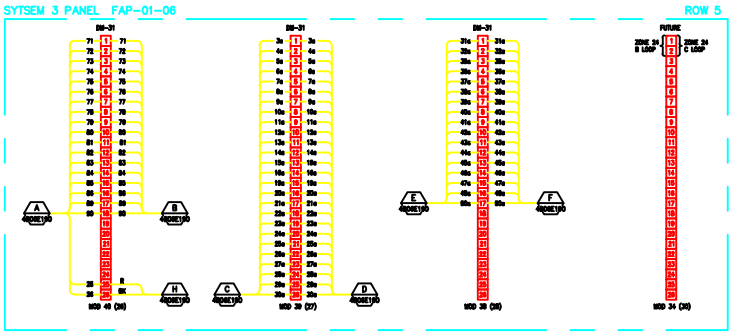

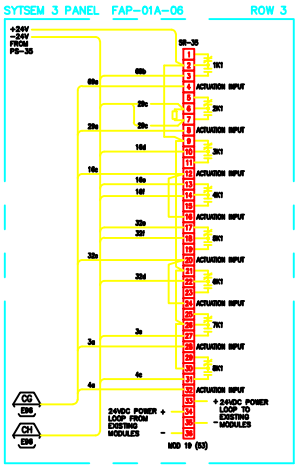

MODULE KEY

MOD 32 (18)

- LOGIC DIAGRAM REFERENCE
- LOCATION IN SYSTEM 3 PANEL

NOTE: THIS DRAWING WAS 4B06E192

GENERAL NOTES

CONTRACTOR IN CONSTRUCTING DISPOSAL SID SCOPE OF WORK SHALL CONSIDER AND MAKE PROVISIONS FOR FUTURE CONSTRUCTION.

Eichleay Engineers Inc. of California
1390 Willow Pass Road, Suite 600, Concord, Ca. 94520
(925) 689-7000 * FAX (925) 689-7006

REV	DATE	DRAWN	CHKD	APVD	DESCRIPTION
A					AS-BUILT RECORD DWG PER CHGS. MARKED

BUILDING 6
OFFICE & LAB BUILD-OUT
FIRE ALARM CONNECTION DIAG. #4

UNIVERSITY OF CALIFORNIA LAWRENCE BERKELEY LABORATORY
FACILITIES DEPARTMENT

DRAWN BY DAS DATE 12/19/96
CHECKED BY
APPROVED BY
CAD FILE NAME 00013906
SCALE NONE
DRAWING NO. 4B06E260A
SHEET E98
PROJECT NO. P00070