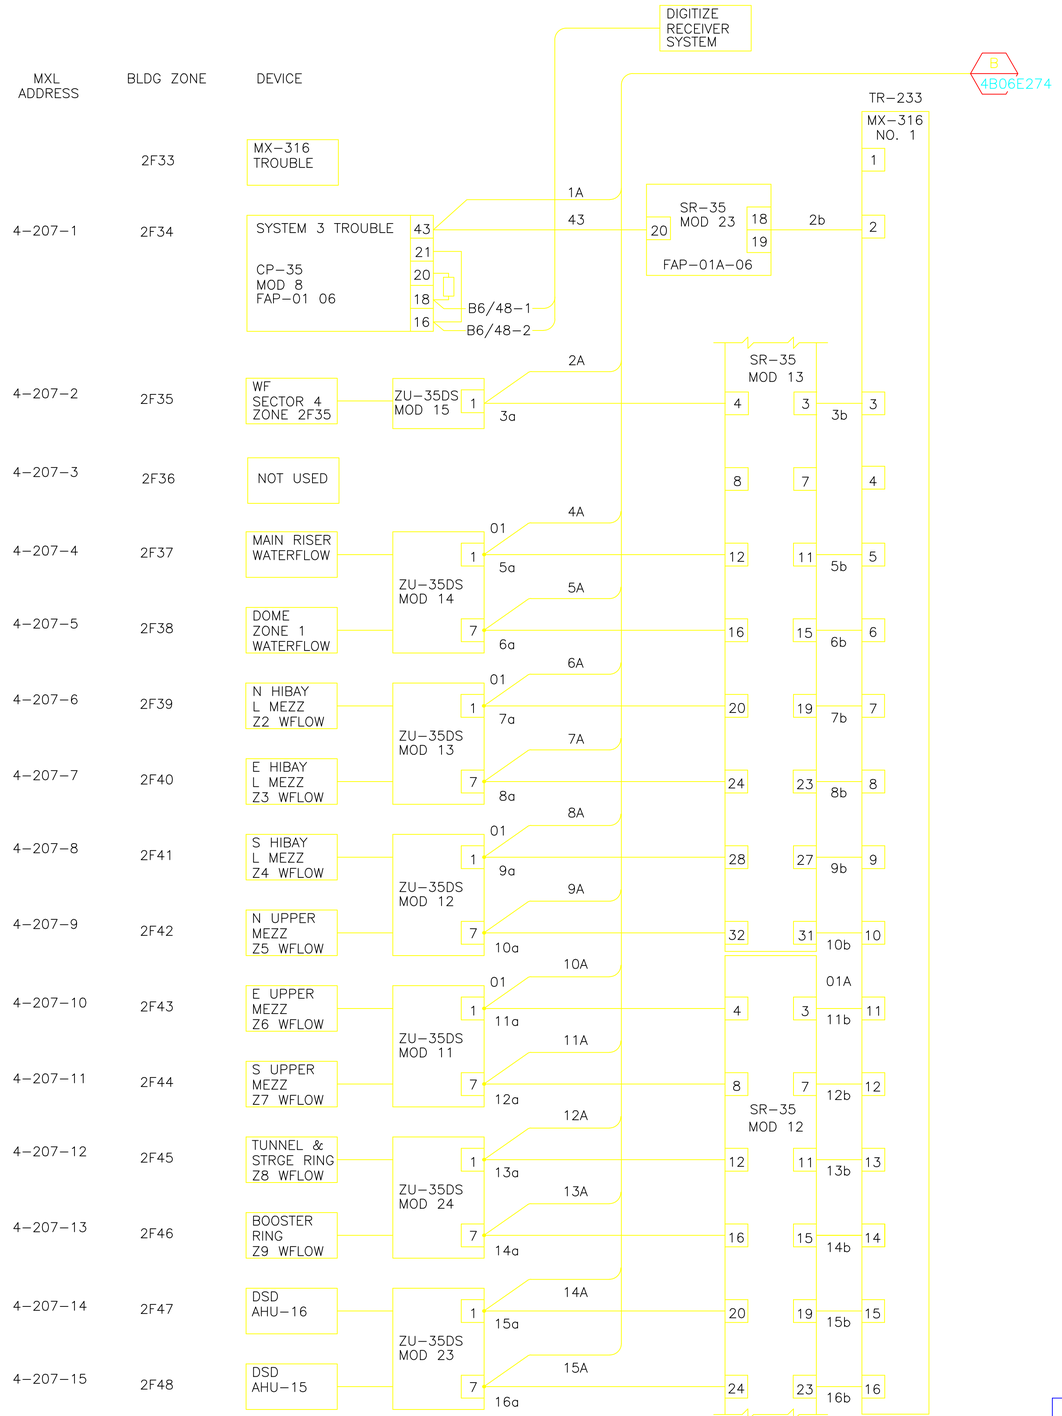

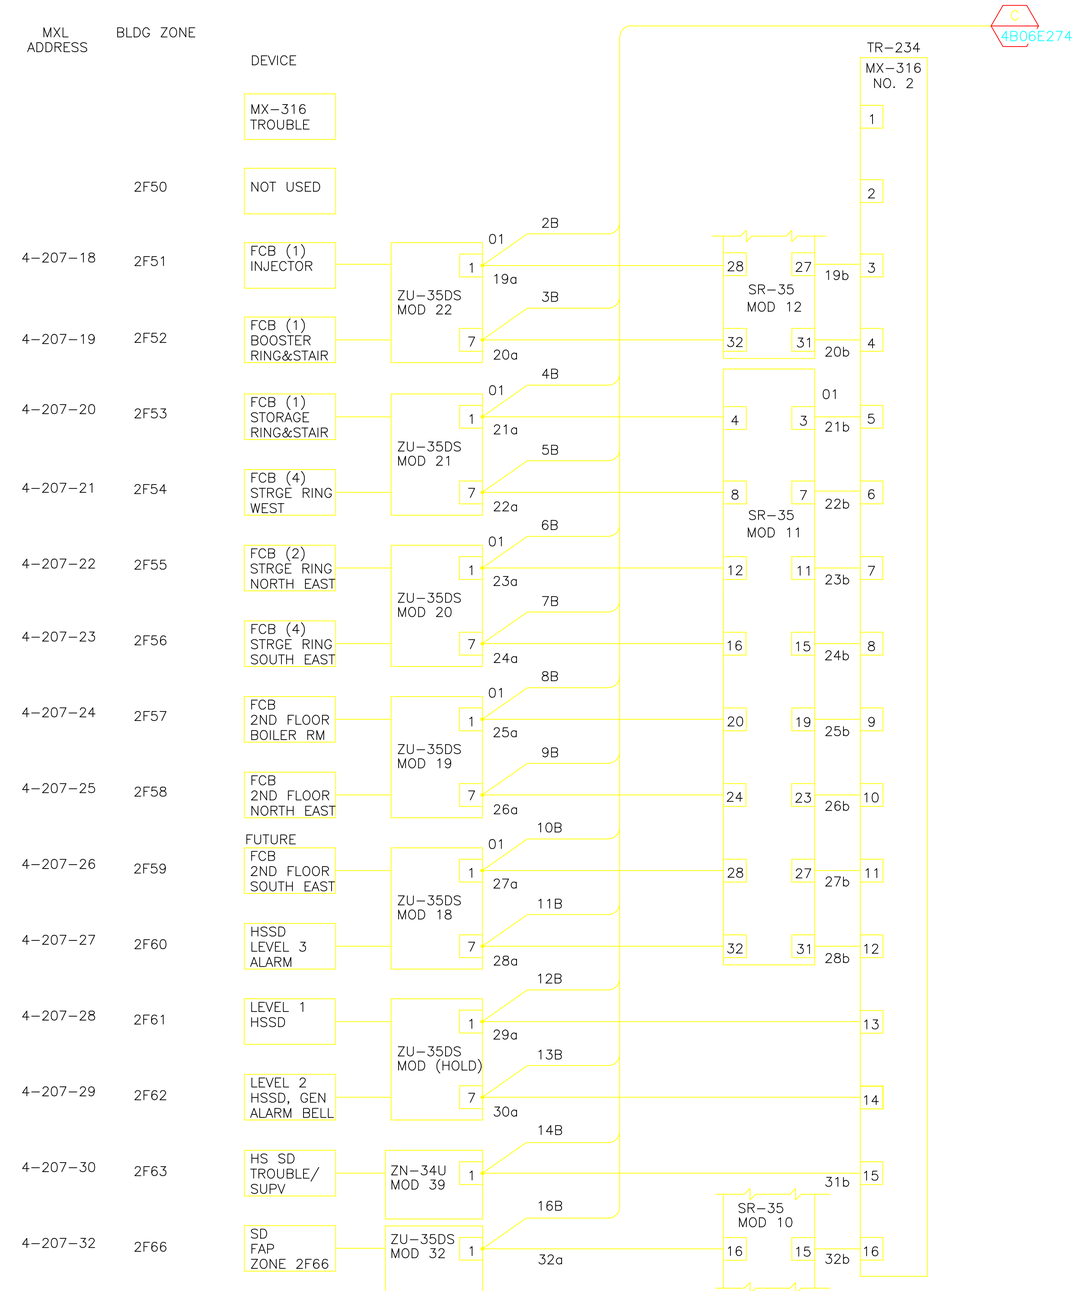

NOTES:

1. FOR TYPICAL DEVICE, AND "EOL" MODULE WIRING, SEE STANDARD FIRE ALARM DRAWINGS 4BSTE002 AND 4BSTE041 THROUGH 4BSTE051.

REFERENCE DRAWINGS:

4B06E191F INTERCONNECTION DIAGRAM

AS BUILT

E

4/24/2013

REVISION NUMBER	DRAWN BY	CHECKED BY	APPR'D BY	DATE	REMARKS
E	LDD	LDD	MCD	04/24/13	AS BUILT PER FIELD VERIFICATIONS
D	AD	LDD	MCD	08/23/07	FIRE ALARM SYSTEM UP-GRADE
C	AD	MCG	MCG	04/05/05	REVISED FOR DIGITIZE SYSTEM
B	AD	MCG	MCG	09/19/03	AS-BUILT, FIRE ALARM PHASE I UPGRADE
–	DWH	BBT	BBT	7/26/02	CONFORMED SET
A	HYT	HYT		5/23/02	SOUTH EXPANSION PROJECT

PROFESSIONAL SEAL (IF REVISION, APPLIES ONLY TO REVISED WORK)

ISSUE (PROGRESS, ESTIMATE, BID, CONSTRUCTION, CONFORMED, REVISION, RECORD)

06 FIRE ALARM SYSTEM

SYSTEM 3 PANEL FAP-01-06

FIELD DEVICE CONNECTIVITY

UNIVERSITY OF CALIFORNIA
LAWRENCE BERKELEY NATIONAL LABORATORY
FACILITIES DIVISION

DRAWN BY	HYT	DATE 3/30/2001
CHECKED BY	HYT	3/30/2001
APPROVED BY		
CAD FILE PATH		
SCALE	Full	
DRAWING NO.	4B06E272D	SHEET 1 OF 1
PROJECT NO.	120960	