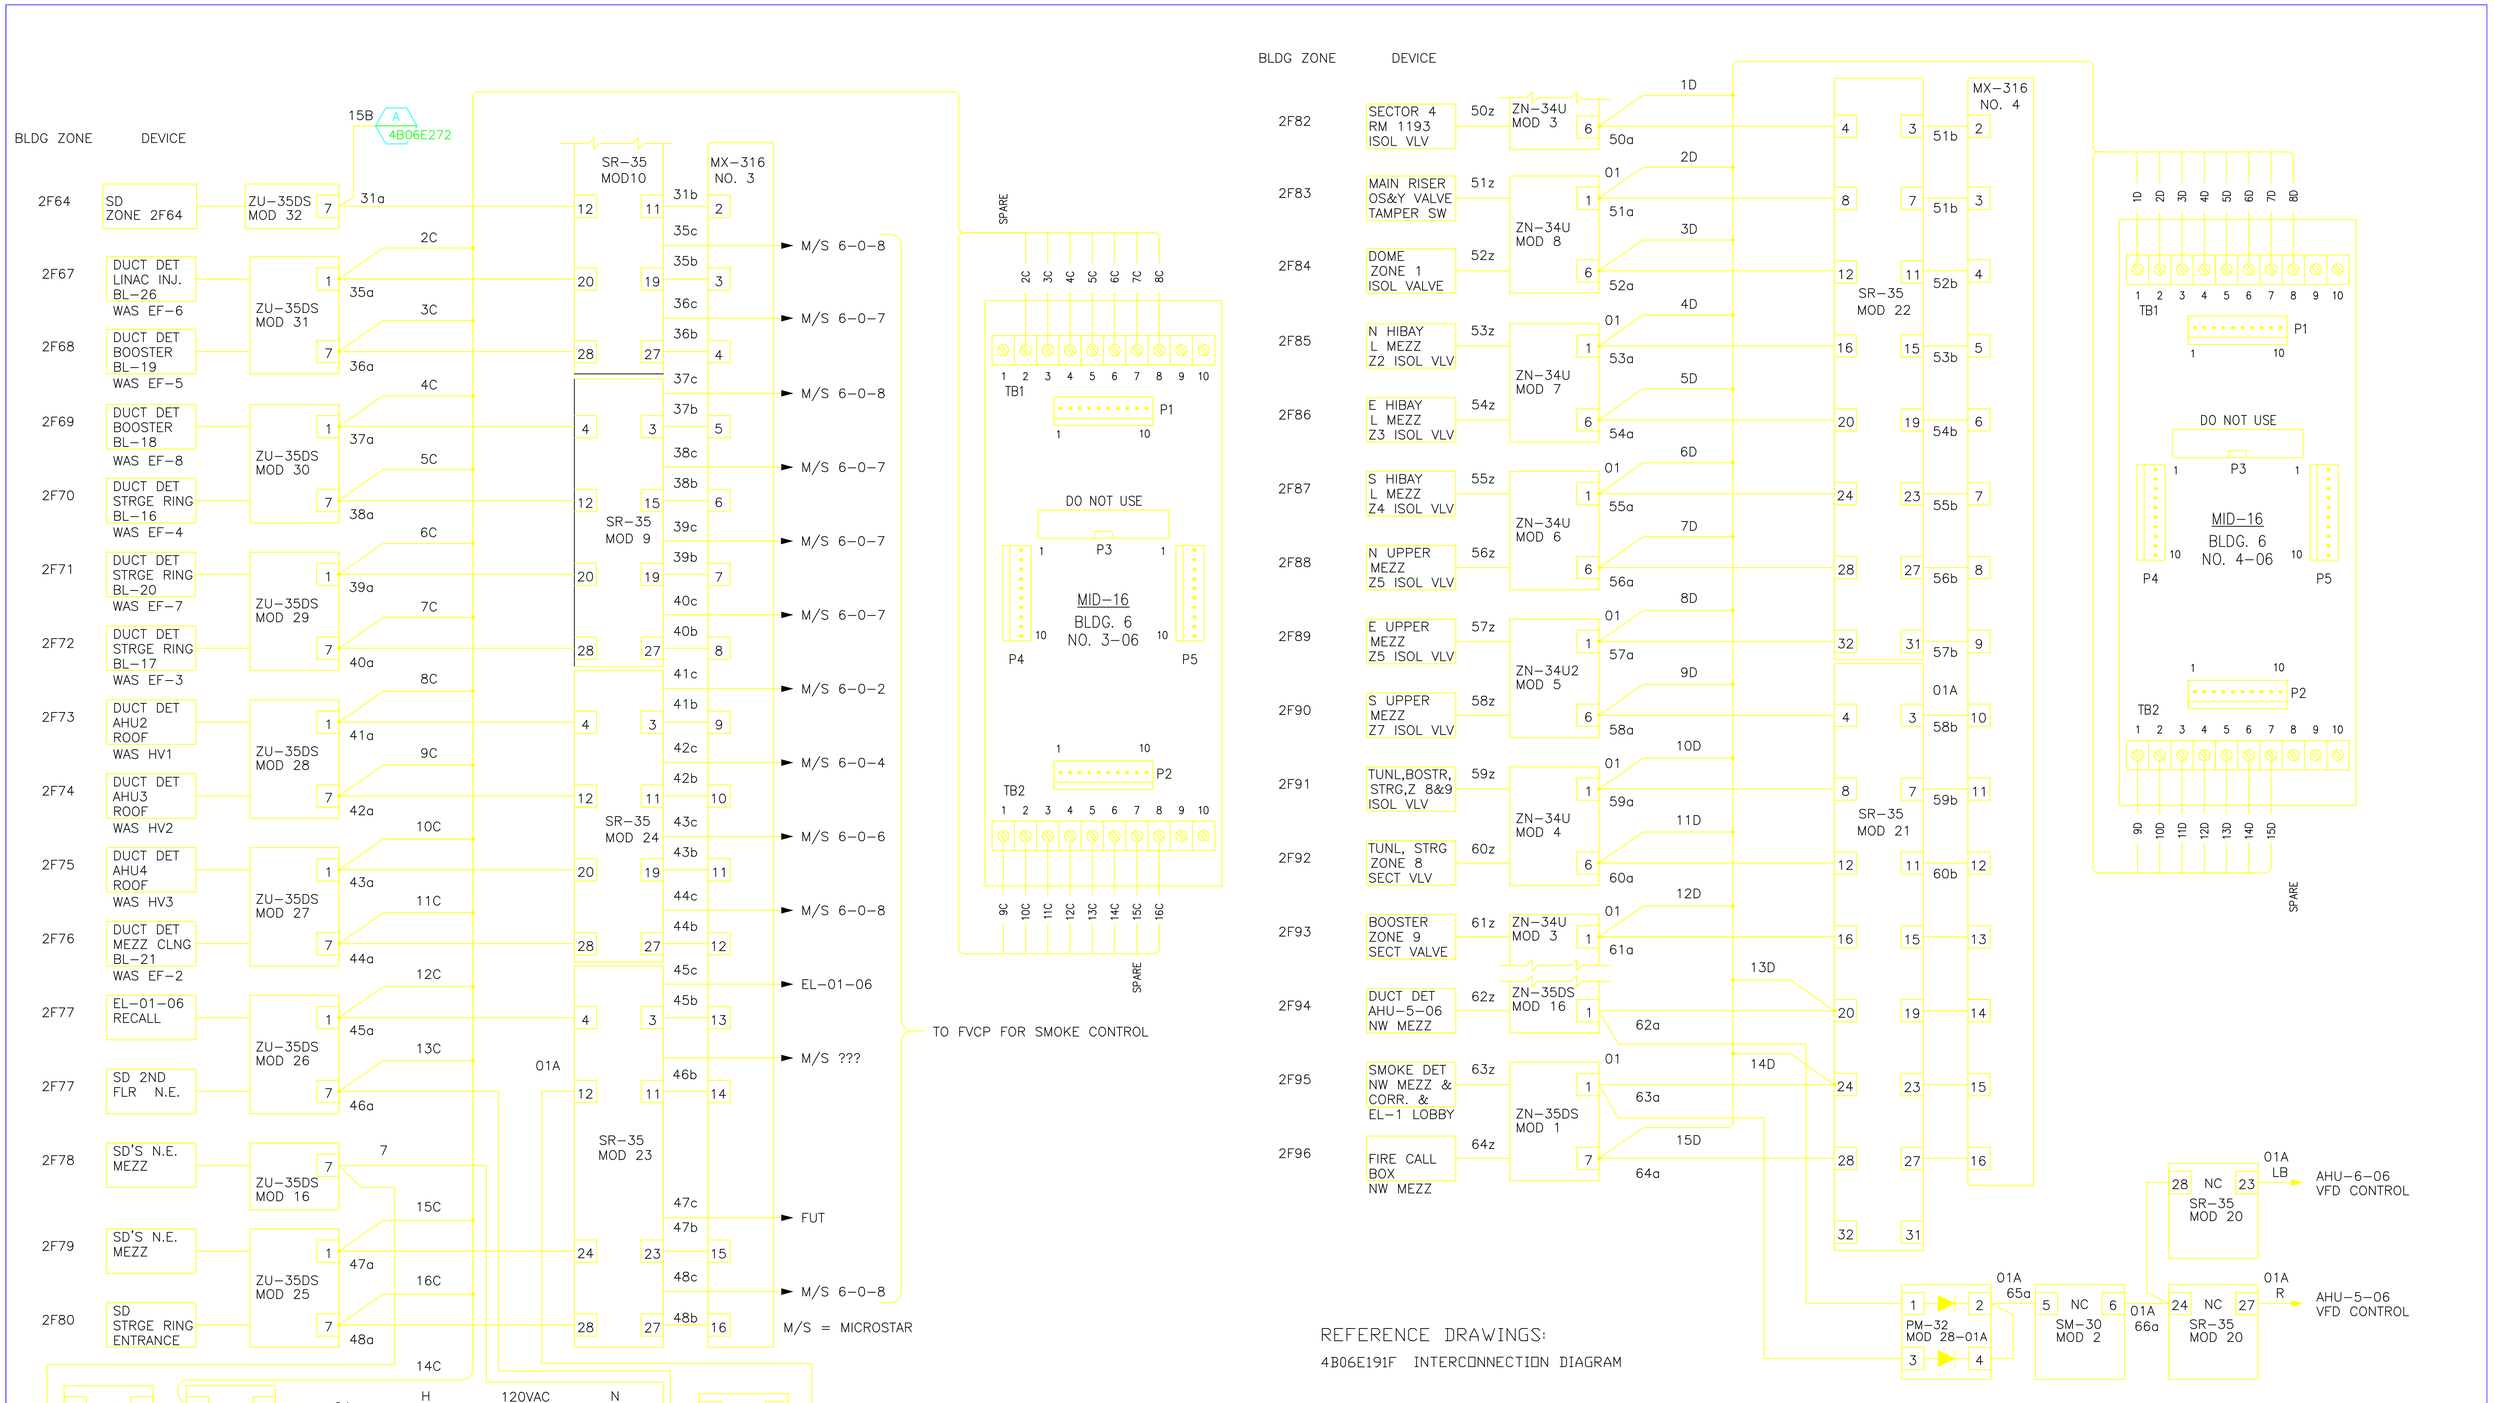

REFERENCE DRAWINGS:

4B06E191F INTERCONNECTION DIAGRAM

C	AD	MCG	MCG	09/19/03	AS-BUILT, FIRE ALARM PHASE I UPGRADE		
B	LDD	MCG	MCG	12/12/02	SECTOR 4 ADDITION - PROJ FX1044		
A	HYT	HYT		5/23/02	SOUTH EXPANSION PROJECT		
REVISION NUMBER	DRAWN BY	CHECKED BY	APPR'D BY	DATE	REMARKS		

PROFESSIONAL SEAL (IF REVISION, APPLIES ONLY TO REVISED WORK)

ISSUE (PROGRESS, ESTIMATE, BID, CONSTRUCTION, CONFORMED, REVISION, RECORD)

ASBUILT REVISION C 9/19/2003

06 FIRE ALARM SYSTEM

SYSTEM 3 PANEL FAP-01-06

FIELD DEVICE CONNECTIVITY

UNIVERSITY OF CALIFORNIA
LAWRENCE BERKELEY NATIONAL LABORATORY
FACILITIES DIVISION

DRAWN BY HYT	DATE 3/30/2001	
CHECKED BY HYT	3/30/2001	
APPROVED BY	1/2/2002	
CAD FILE PATH 00015819		
SCALE Full		
DRAWING NO. 4B06E273C	SHEET 1 OF 1	
PROJECT NO. 120960		