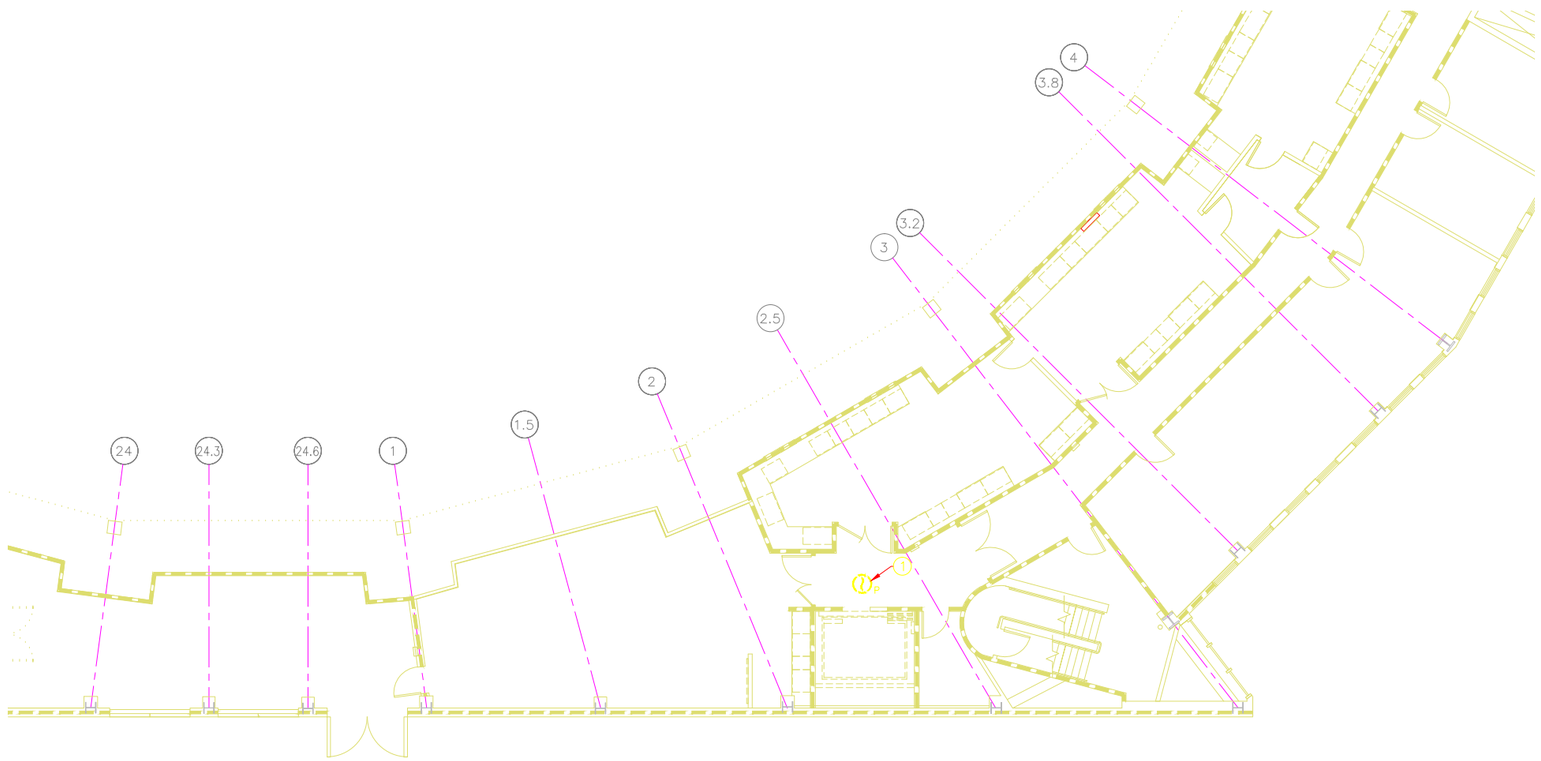

KEYED NOTES:

1. EXISTING SMOKE DETECTOR TO REMAIN. DISCONNECT FROM EXISTING CIRCUIT AND REMOVE EXISTING CONDUCTORS (AS NECESSARY). CONNECT TO EXISTING 2ND FLOOR CORRIDOR SMOKE DETECTOR CIRCUIT FROM FIRE ALARM PANEL FAP-01-06, ZU-35DS, MOD 32.

KEY PLAN:

HYT Corporation
FIRE PROTECTION ENGINEERS – CONSULTANTS
3498 CLAYTON ROAD – SUITE 101, CONCORD, CALIFORNIA 94519
PHONE: (925) 681-2731 * FAX: (925) 681-2733

CONSULTING FIRM

Eichleay Engineers Inc. of California
1390 Willow Pass Road, Suite 600, Concord, Ca. 94520
(925) 689-7000 • FAX (925) 689-7006
EEI JOB NO: 30330

CONSULTING A/E FIRM (PRIME)

PROFESSIONAL SEAL (IF REVISION, APPLIES ONLY TO REVISED WORK)

AS BUILT
1/12/2004

ISSUE (PROGRESS, ESTIMATE, BID, CONSTRUCTION, CONFORMED, REVISION, AS-BUILT)

REVISION NUMBER	DRAWN BY	CHECKED BY	APPR'D BY	DATE	REMARKS
B	WEW	WN	MOH	1/12/04	AS BUILT
A	DWH	BBT	BBT	7/26/02	CONFORMED SET

6
SOUTH SIDE EXPANSION
FIRE ALARM, 2ND FLOOR DEMOLITION

UNIVERSITY OF CALIFORNIA
LAWRENCE BERKELEY NATIONAL LABORATORY
FACILITIES DEPARTMENT

DRAWN BY	DWH	DATE 03/01/02
CHECKED BY	BBT	5/21/02
APPROVED BY	DWH	5/21/02
CAD FILE PATH	00017552	
SCALE	1/8" = 1'-0"	
DRAWING NO.	4B06E303B	SHEET F32
PROJECT NO.	FX1080	1 OF 1